


PINEBROOK COLLIERY
CLARK VEIN

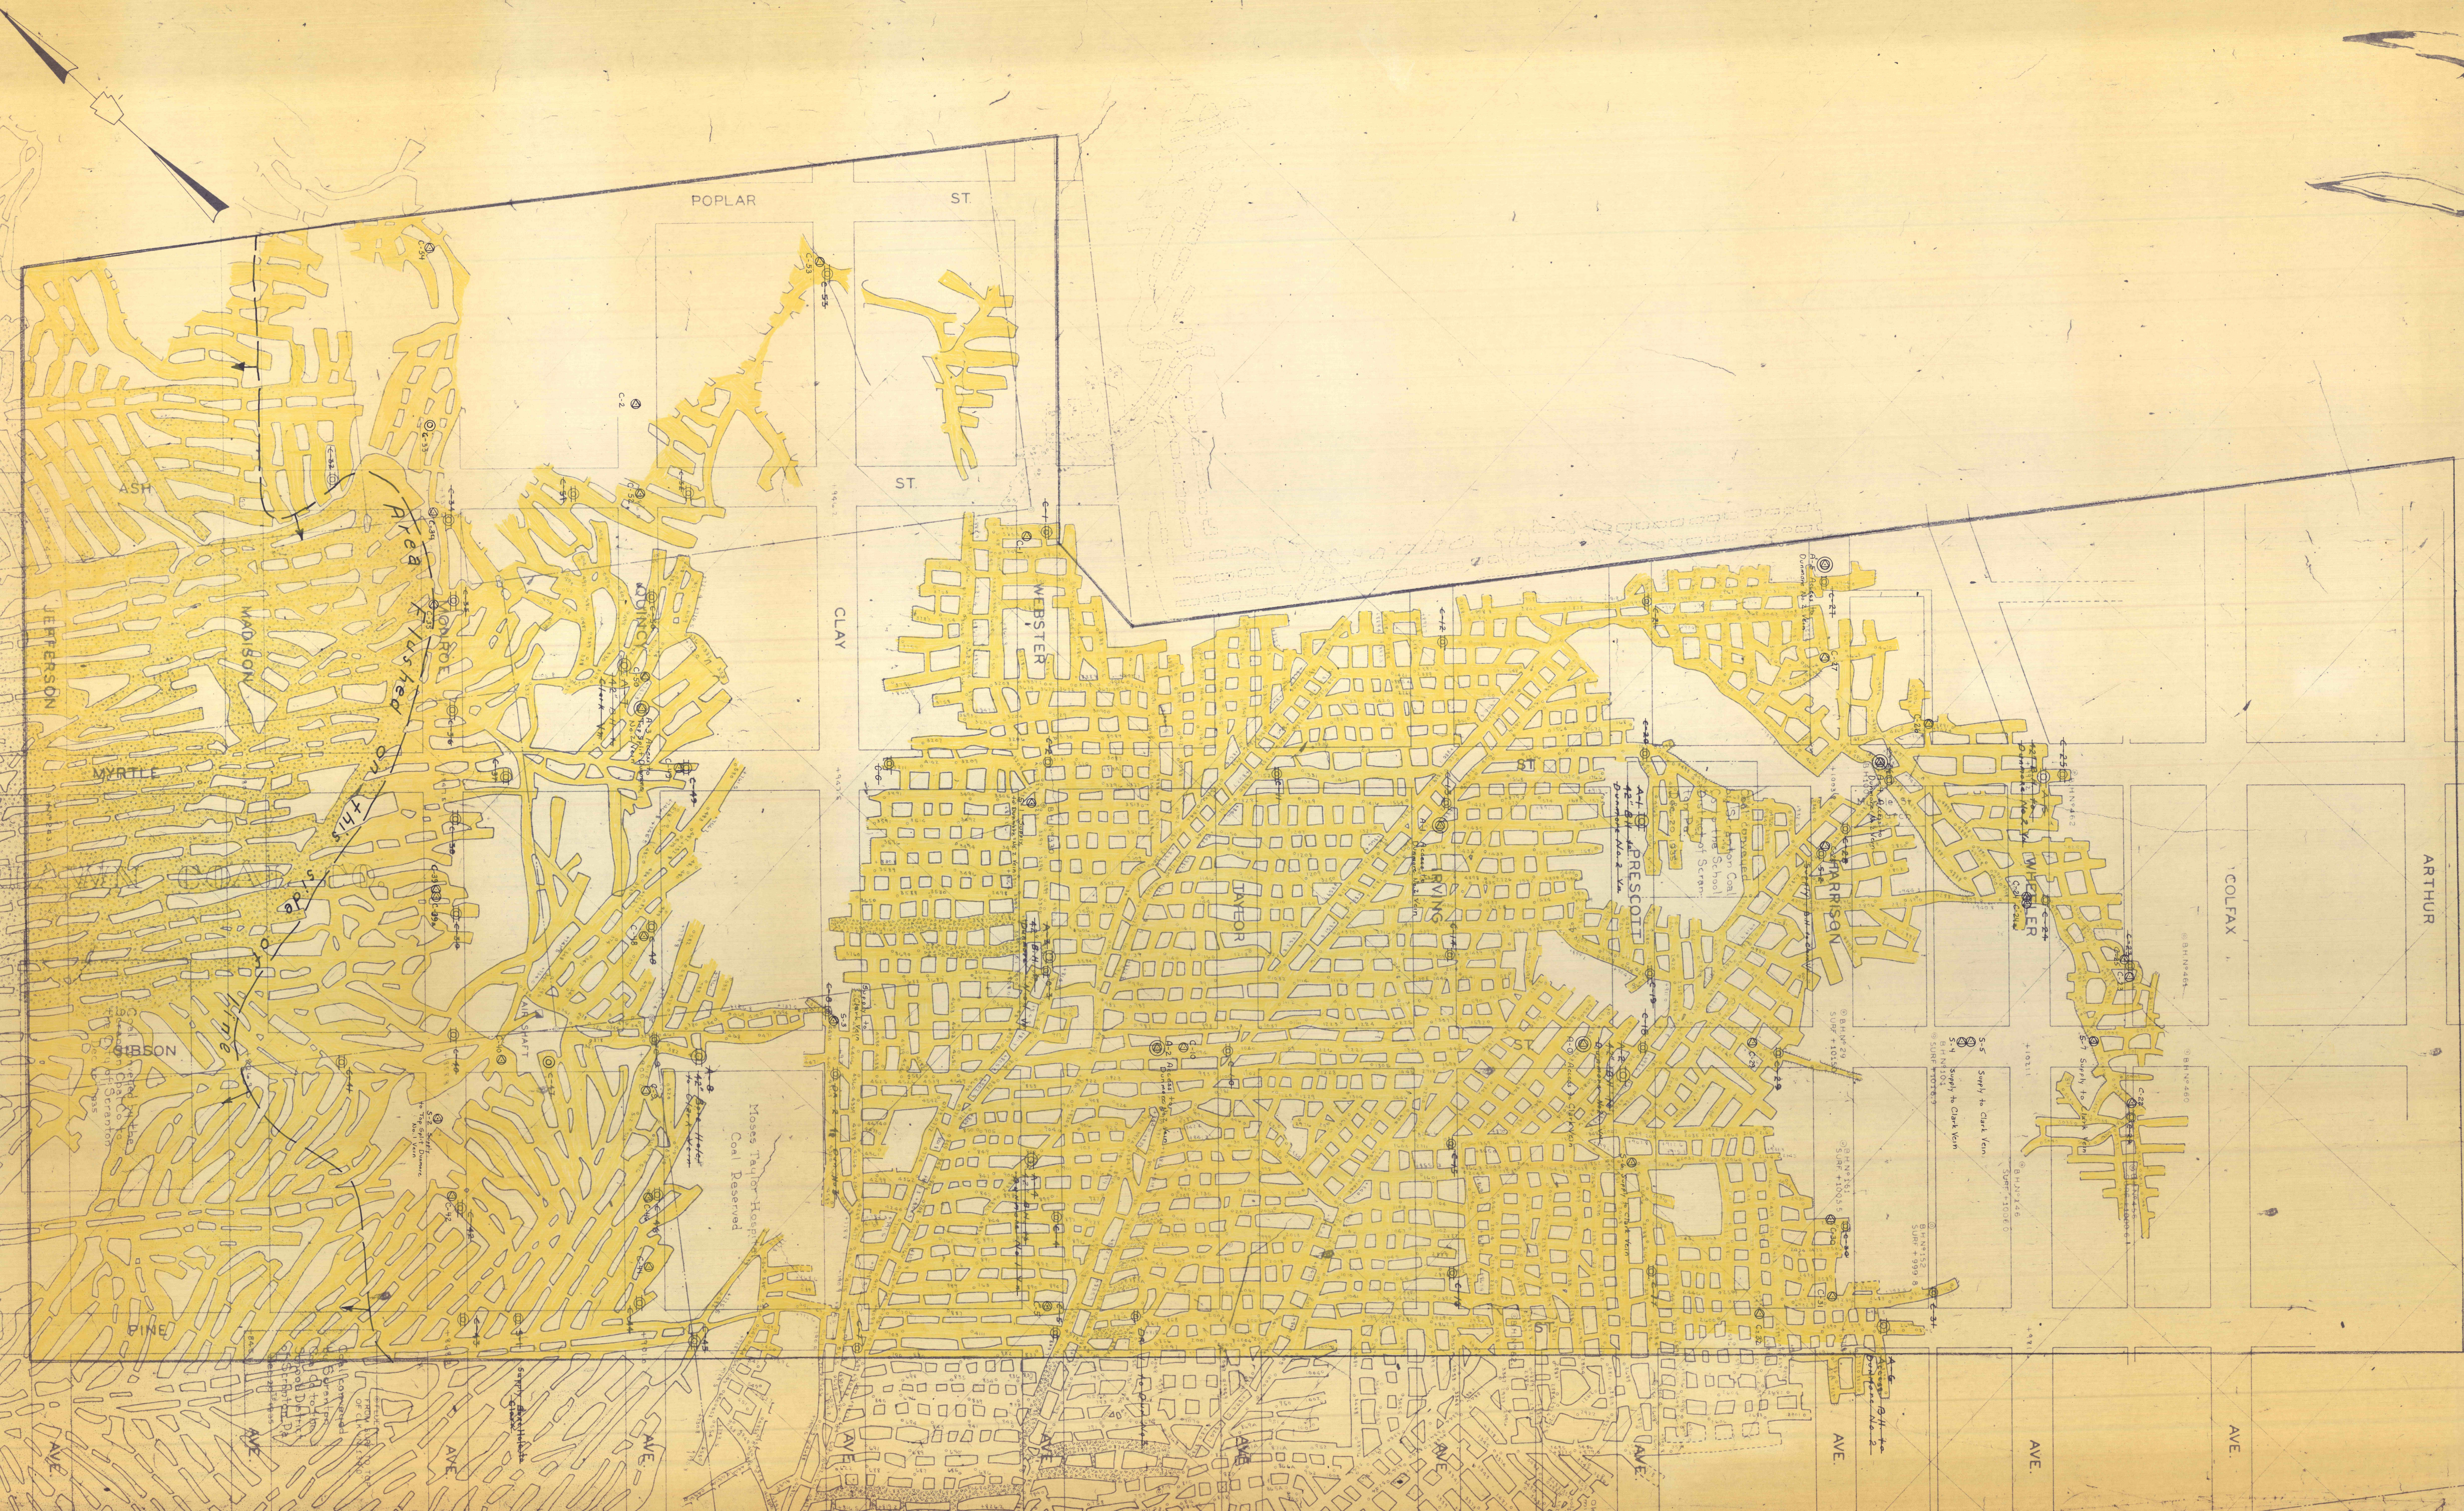

PINEBROOK COLLIERY
CLARK VEIN

- LEGEND**
- Indicates Flashed Areas
 - C - Clark Vein
 - T - Top Split Dunmore No 1 Vein
 - D - Dunmore No 1 Vein
 - D' - Dunmore No 2 Vein
 - S - Supply Drifts
 - A - Access Borehole
 - D - Damage Borehole
 - - Reopened or additional
 - - Deleted Borehole

COMMONWEALTH OF PENNSYLVANIA
DEPARTMENT OF ENVIRONMENTAL RESOURCES
OFFICE OF ENGINEERING AND CONSTRUCTION

**FLUSHING OF VOIDS
ABANDONED PINE BROOK MINE
CLARK VEIN**

HILL SECTION - PHASE I
CITY OF SCRANTON

LACKAWANNA COUNTY
PENNSYLVANIA

SCALE: AS SHOWN
DRAWN BY: [Signature]
CHECKED BY: [Signature]
APPROVED BY: [Signature]

