


Vertical  
Meters

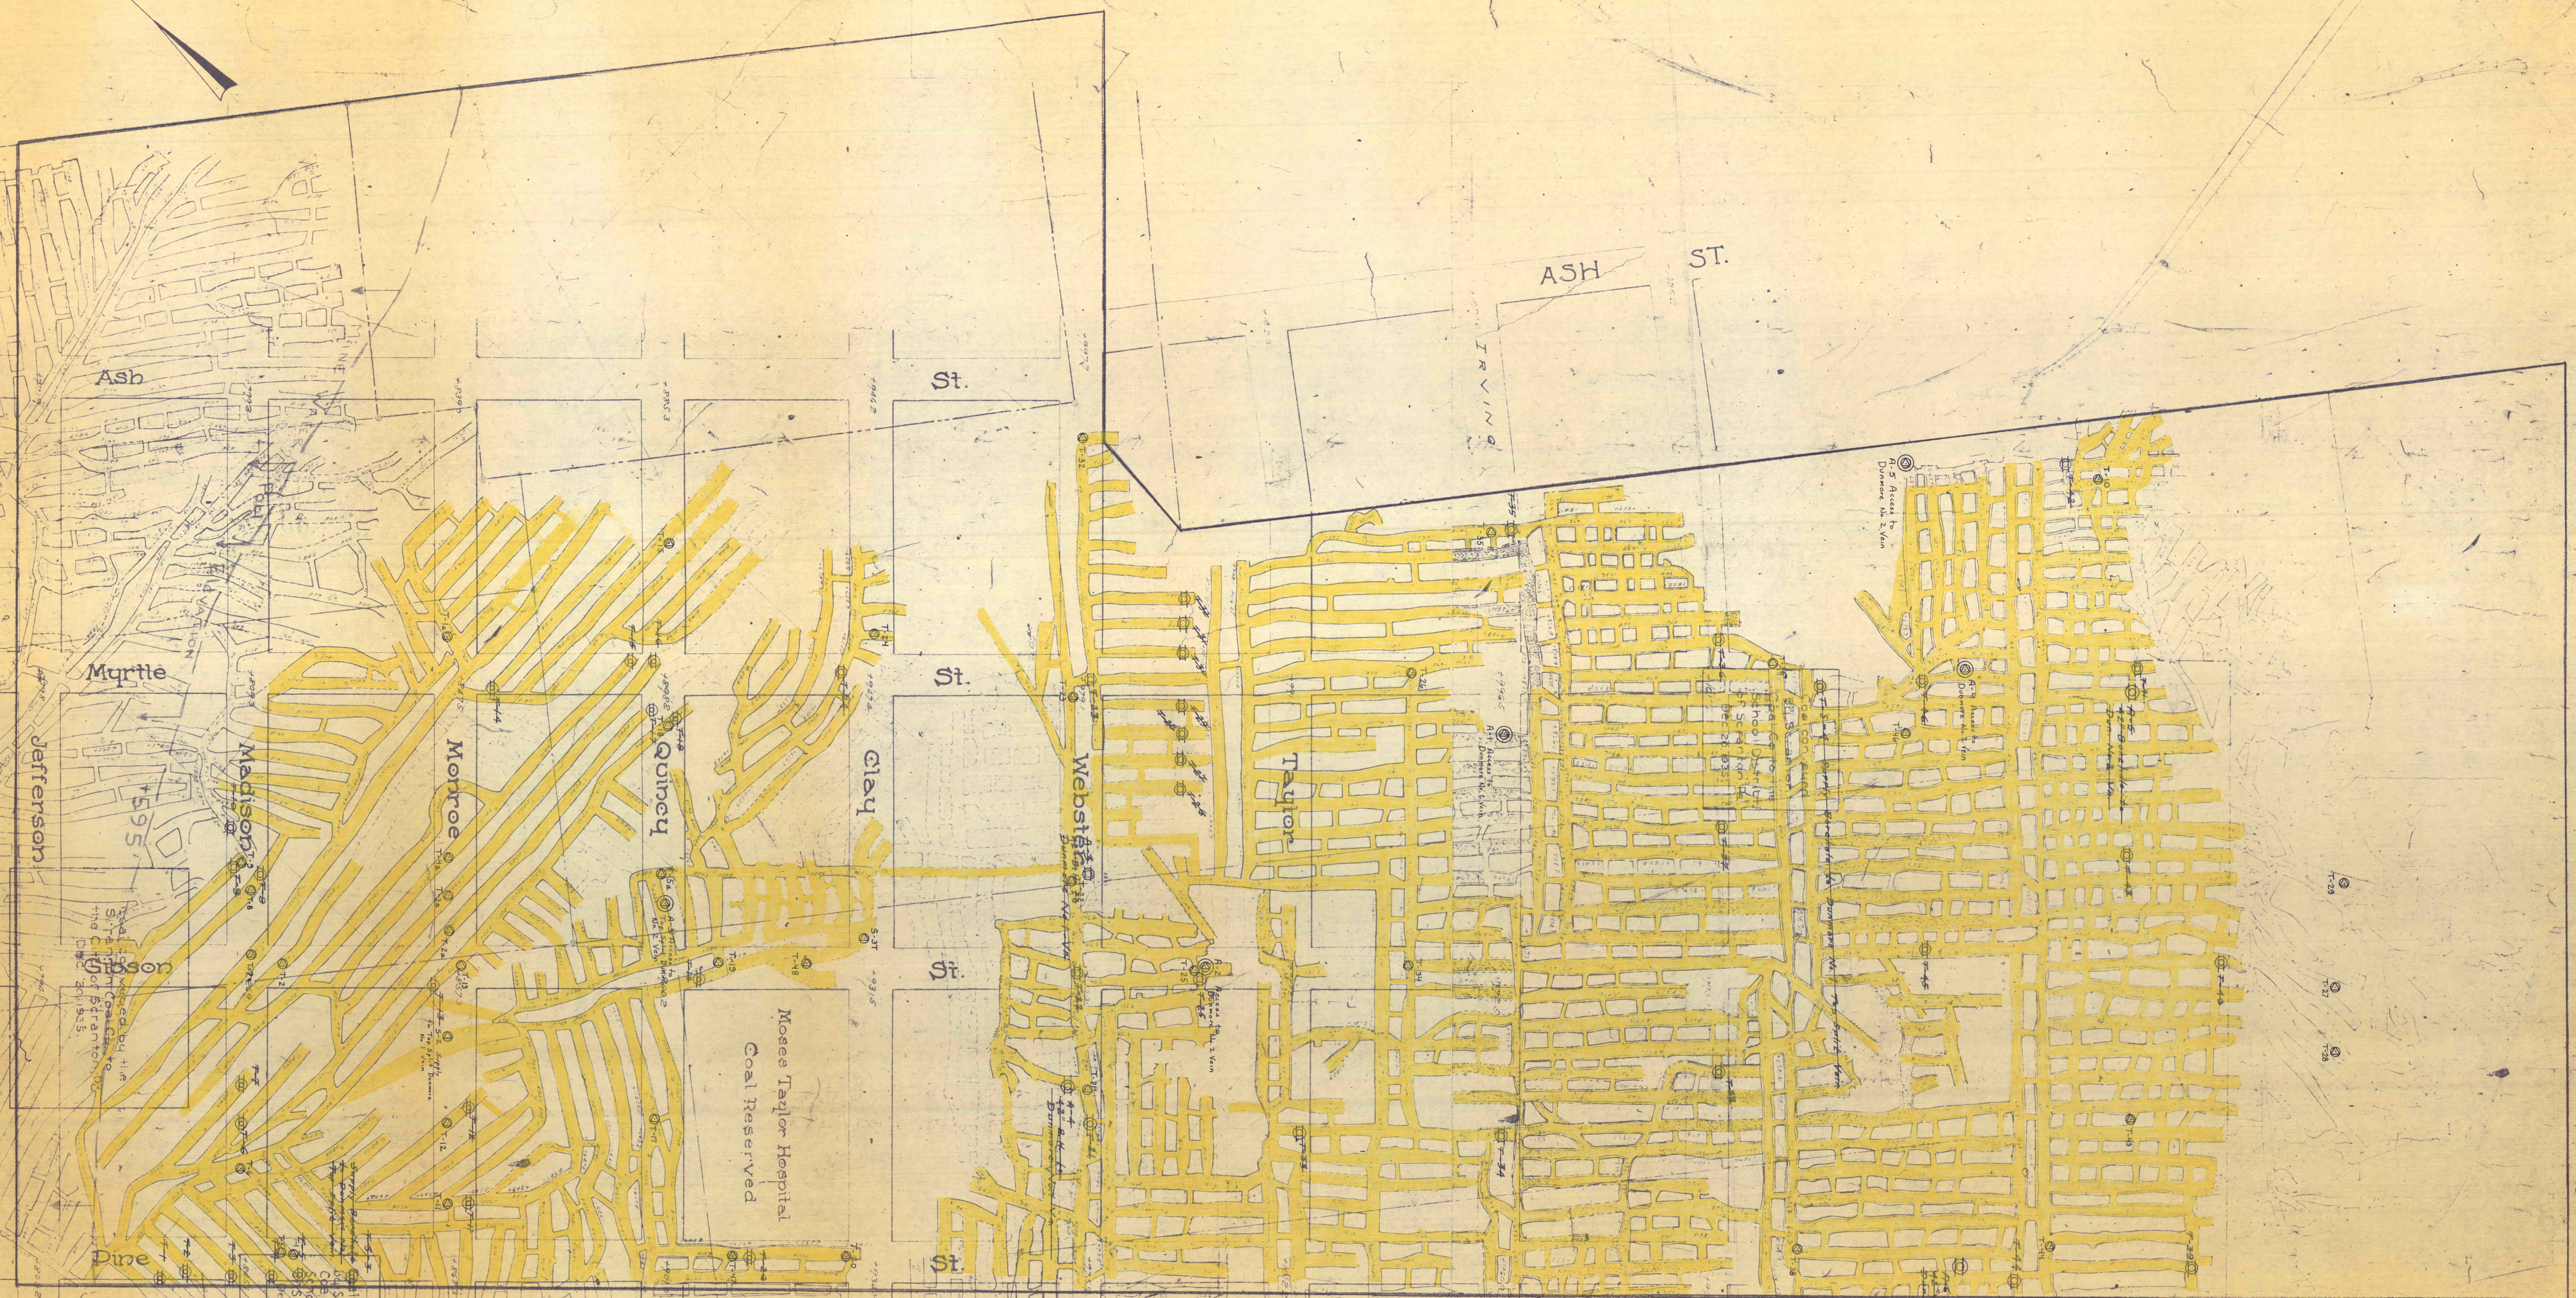

- Rock Picking & Flushing
- REVISIONS
- ⊕ Relocated or additional
  - ⊖ Deleted Borehole
  - ⊞ Indicates Flashed Area
- LEGEND
- C - Clark Vein
  - T - Top Split Dunmore No 1 Vein
  - D - Dunmore No 1 Vein
  - D' - Dunmore No 2 Vein
  - S - Supply Borehole
  - A - Access Borehole
  - R - Drilling Borehole

COMMONWEALTH OF PENNSYLVANIA  
DEPARTMENT OF ENVIRONMENTAL RESOURCES  
OFFICE OF ENGINEERING AND CONSTRUCTION

HILL SECTION PHASE I  
CITY OF SCRANTON

ABANDONED PINE BROOK MINE  
TOP SPLIT NO. 1 DUNMORE VEIN

LACKAWANNA COUNTY  
PENNSYLVANIA

Scale: 1" = 100'

DATE: 5/1/74

BY: C. Kline

DWG. NO. ASE

Approved for Construction  
City of Scranton  
Date: 5/1/74

730  
732  
734