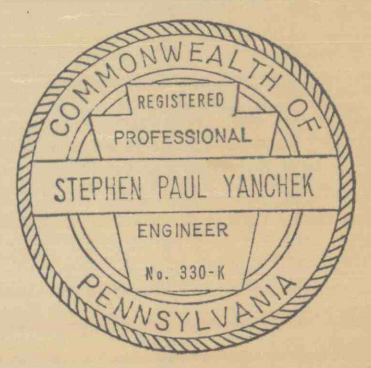


NO.	DATE	AS BUILT DRAWINGS	APPR.
1-12	79	REVISION	
SUBMITTED		Stephen P. Yancheck P.E.	
APPROVED			
APPROVED			
			
COMMONWEALTH OF PENNSYLVANIA DEPARTMENT OF ENVIRONMENTAL RESOURCES OFFICE OF RESOURCES MANAGEMENT			
ASP - 12 - 1 HILL SECTION FLUSHING PROJECT EXTENSION CITY OF SCRANTON & BOROUGH OF DUNMORE LACKAWANNA COUNTY, PA. PENNSYLVANIA COAL CO. NO. 1 DUNMORE VEIN			
DRAWN BY	DATE	DRAWING NO.	
CHECKED BY	SCALE 1"=100'	SHEET 2 of 3	