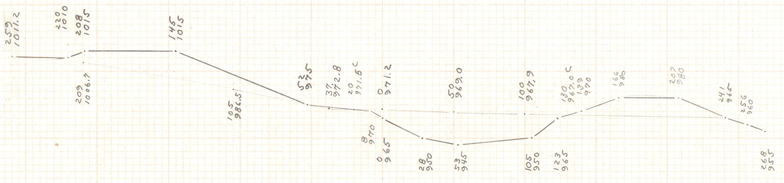

Station 1+00
Elev 950
Fill 2,172.5 SF
CUT LT 1969.8 SF RT 1060.5

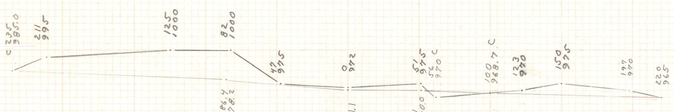

Station 0+36
Elev 950
Fill 106.1 SF
CUT LT 2949.4 SF CUT RT 490.6

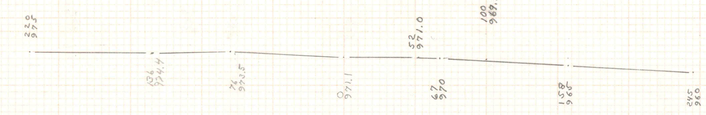

Station 0+00
Elev 950
No CUT LT No CUT RT
No Fill 0 SF

Base Line

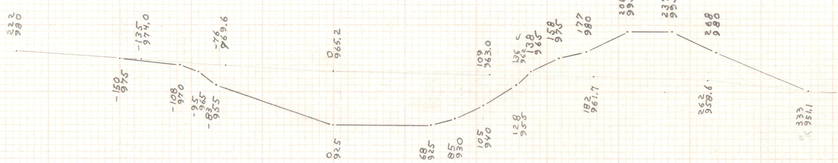

Station 3+00
Elev. 950
Fill 6,760.0 SF
CUT LT 0 RT 3903.8

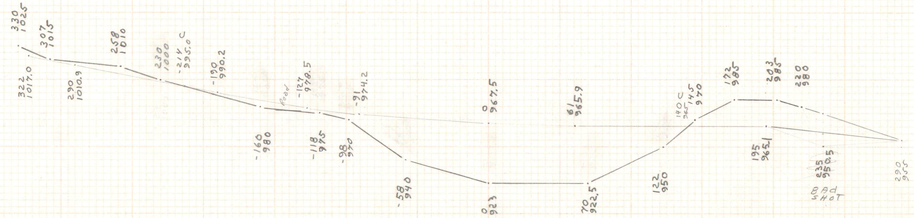

Station 2+00
Elev. 950
Fill 8,002.2 SF
CUT LT 268.2 RT 1910.3

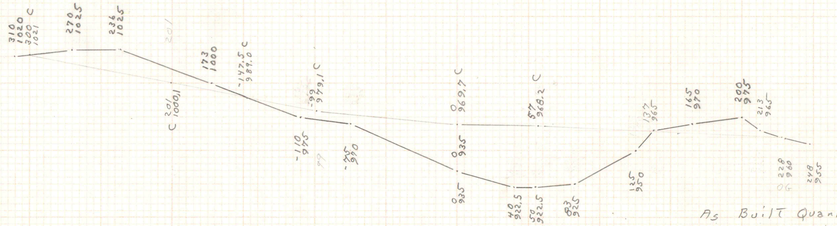

Station 1+60
Elev 950
Fill 6,726.4 SF
CUT LT. 1434.4 RT 587.5

Base Line

Starra Pit #2

As Built Quantities AD 227

Pit only	Fill	5,929,869.2 C.F	219,624.8 CY
Non Pit	Fill	86,352.8 C.F	3,198.3 CY
	CUT	6,023,949.4 CF	223,109.3 CY

286.2 CY

1 of 4