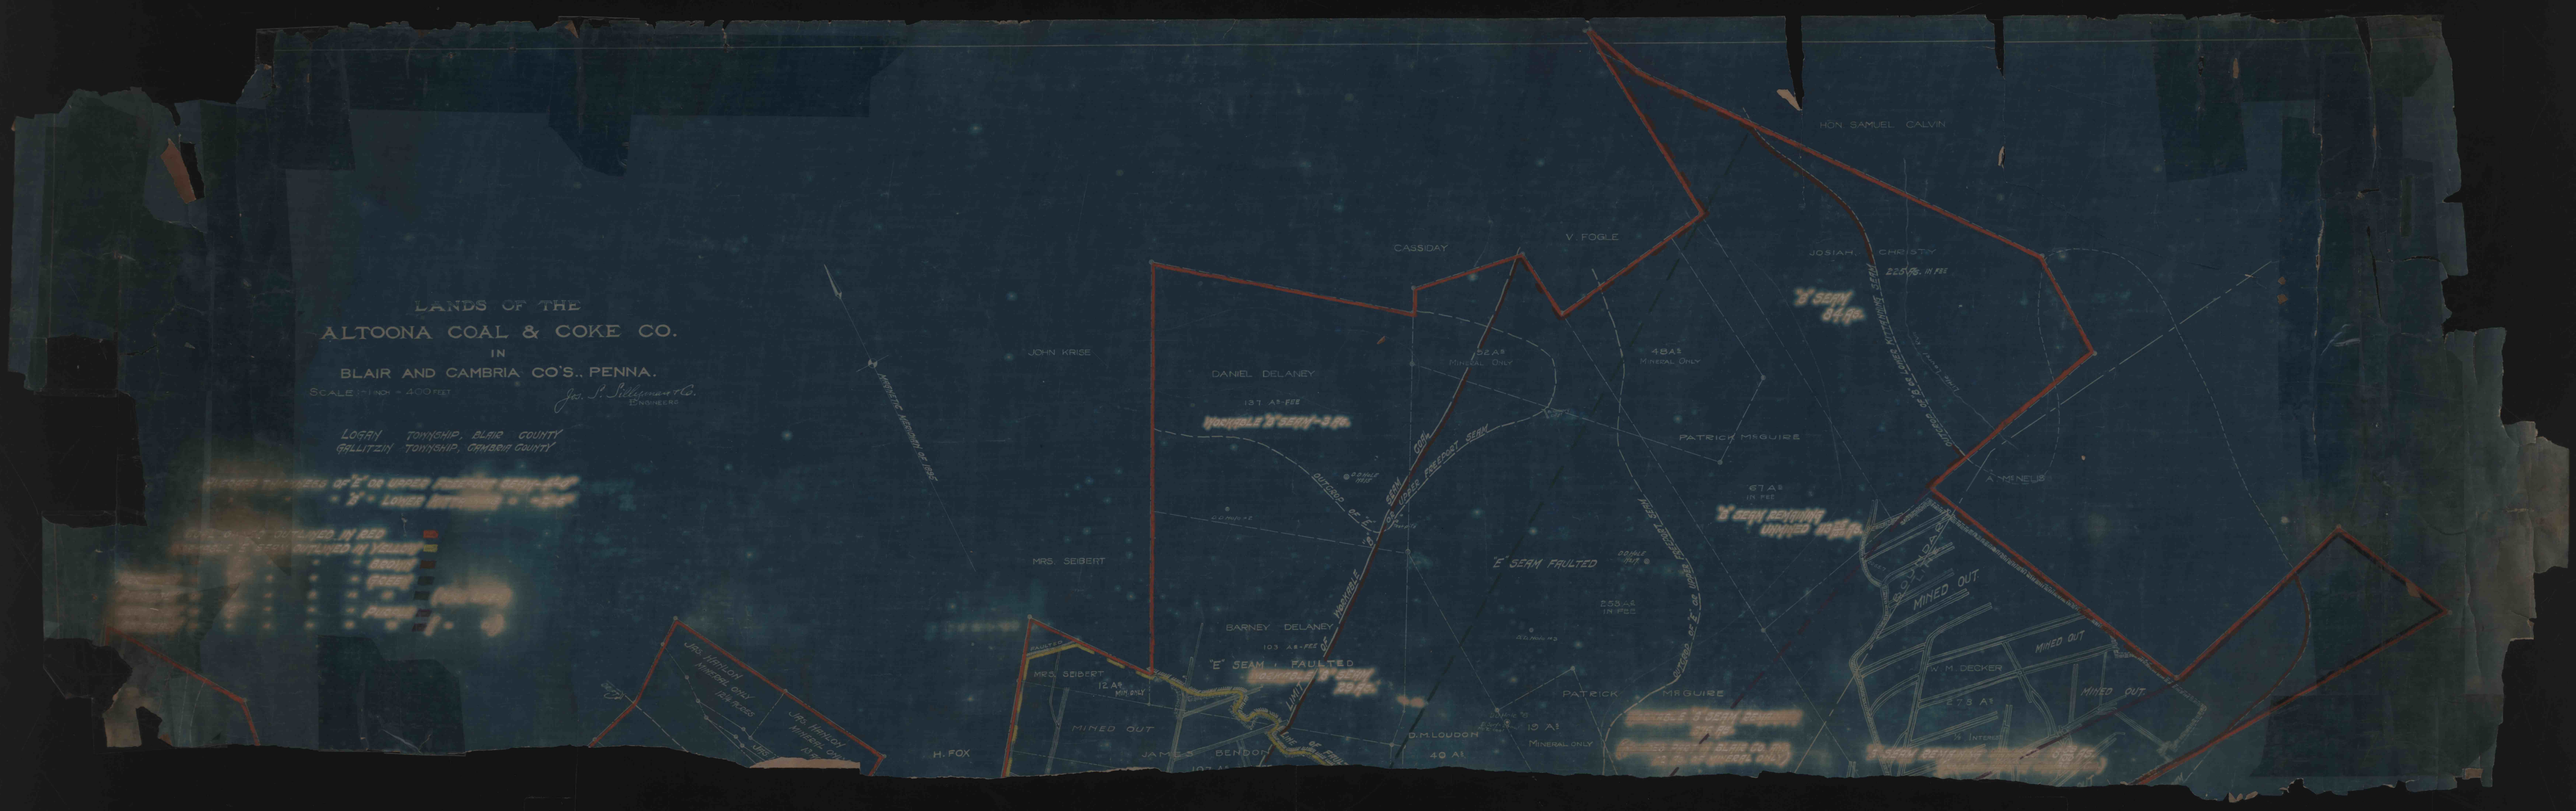
LANDS OF THE
ALTOONA COAL & COKE CO.
IN
BLAIR AND CAMBRIA CO'S., PENNA.
SCALE 1 INCH = 400 FEET
Jos. S. Silliman & Co.
ENGINEERS
LOGAN TOWNSHIP, BLAIR COUNTY
GALLITZIN TOWNSHIP, CAMBRIA COUNTY
CASSIDAY
V. FOGLE
HON. SAMUEL CALVIN
JOSIAH CHRISTY
JOHN KRISE
DANIEL DELANEY
137 A1 FEE
MRS. SEIBERT
BARNEY DELANEY
103 A1 FEE
'E' SEAM FAULTED
MINED OUT
PATRICK McGUIRE
67 A1
IN FEE
A. MENEUR
W. M. DECKER
27.3 A1
H. FOX
JAMES BENDON
107 A1
D. M. LOUDON
49 A1
MINERAL ONLY
52 A1
MINERAL ONLY
48 A1
MINERAL ONLY
12 A1
MIN ONLY
253 A1
IN FEE
15 A1
MINERAL ONLY
MRS. HAMLIN
MINERAL ONLY
124 ACRES
MRS. HAMLIN
MINERAL ONLY
41 A1
OUTCROP OF 'E' SEAM
PROBABLE LIMIT OF 'E' SEAM
LIMIT OF 'E' SEAM
PROBABLE LIMIT OF 'E' SEAM
PROBABLE 'E' SEAM
PROBABLE 'E' SEAM
'E' SEAM
'E' SEAM BEYOND
'E' SEAM FAULTED
PROBABLE 'E' SEAM BEYOND
'E' SEAM BEYOND
DONALE No 7
DONALE No 8
