


ALDENVILLE QUADRANGLE
PENNSYLVANIA-WAYNE CO.
7.5 MINUTE SERIES (TOPOGRAPHIC)



PROMPTON S.P.
BK pencil
Xfer from Bur Design
which was penciled from
Highway map. -
(Not final) 3/5/61
KSC

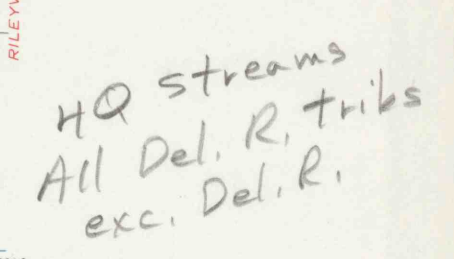

PENNSYLVANIA

QUADRANGLE LOCATION

ROAD CLASSIFICATION

HARD-SURFACE ALL WEATHER ROADS DRY WEATHER ROADS

Heavy-duty. 4 LANE B LANE Improved dirt.

Medium-duty. 4 LANE B LANE Unimproved dirt.

Loose-surface, graded, or narrow hard-surface.

☒ U. S. Route ☐ State Route

WHITE MILLS
300' N. 5W

ALDENVILLE, PA.
N4137.5—W7515/7.5

1946
PHOTOREVISED 1969
AMS 5967 III NE—SERIES V831

2-22.1

DRAWING NUMBER

PLAN HOLD CORPORATION • IRVINE, CA