



PLAN HOLD



PEEL PROTECTIVE STRIP TO EXPOSE ADHESIVE. POSITION EDGE OF PRINT ON THIS LINE AND RUB TO ADHERE.

DRAWING NUMBER
C/1-A-4.4
PLAN HOLD CORPORATION IRVINE CALIFORNIA
REORDER BY NO. 075A.24

0906 2





20AL109

C/4-4.4
0906

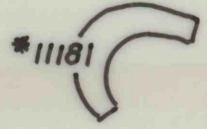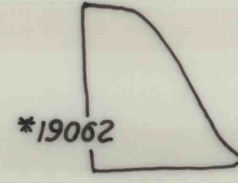





+

+

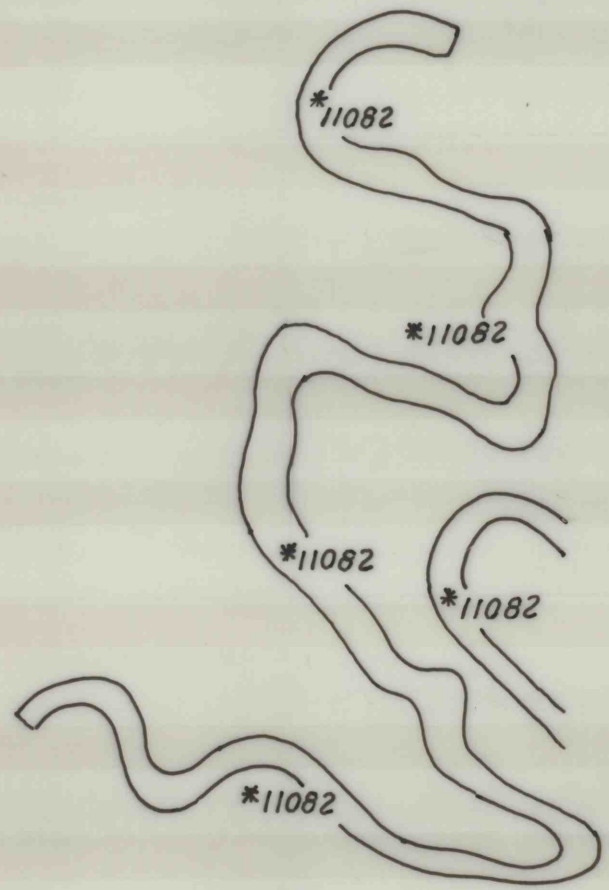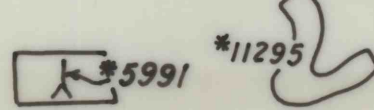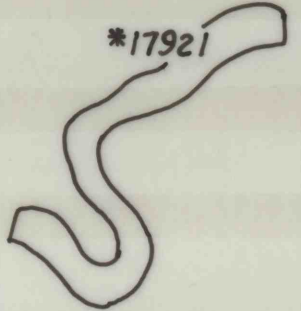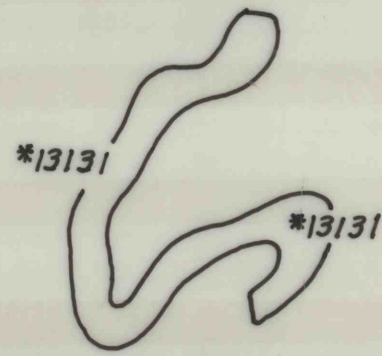

+

+

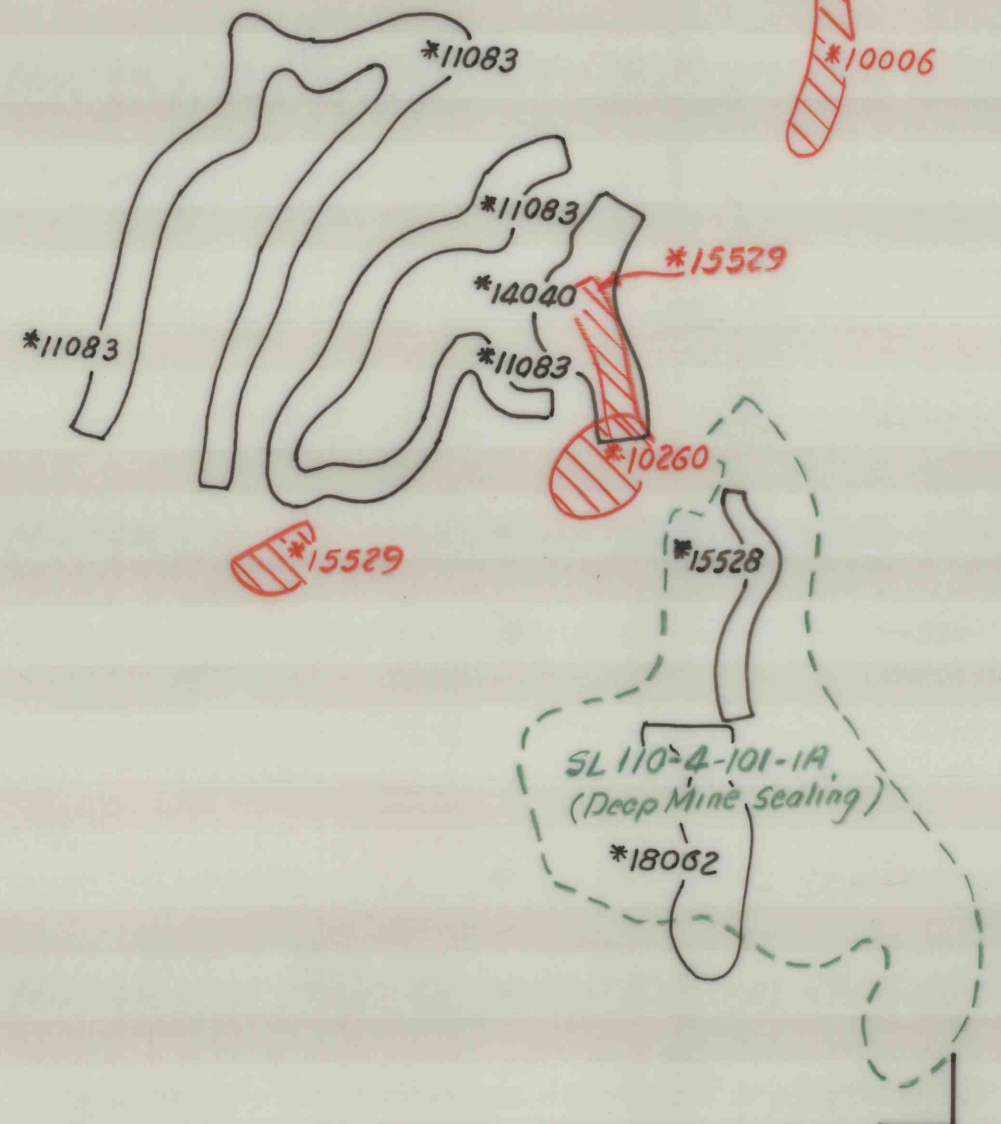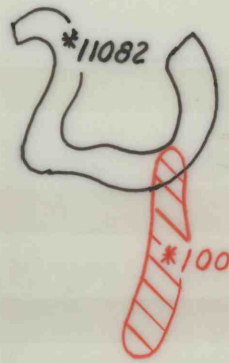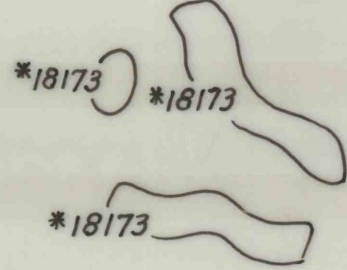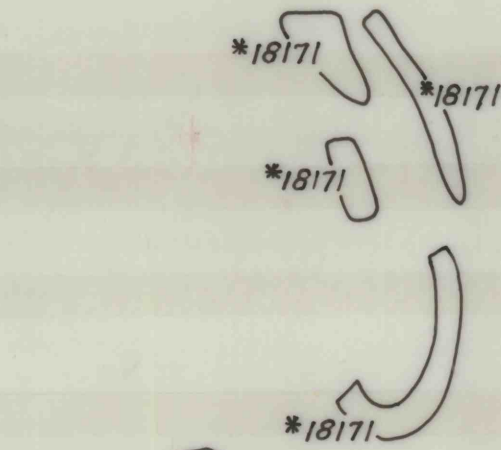

*10005