

DRAWING NUMBER

PLAN HOLD CORPORATION • RINNE, CALIFORNIA
RENDERED BY NUMBER 0754
POSITION DATE OF PRINT ON THIS LINE

DRAWING NUMBER


PLAN HOLD CORPORATION • RINNE, CALIFORNIA
RENDERED BY NUMBER 0754
POSITION DATE OF PRINT ON THIS LINE

DRAWING NUMBER

PLAN HOLD CORPORATION • RINNE, CALIFORNIA
RENDERED BY NUMBER 0754
POSITION DATE OF PRINT ON THIS LINE

SOAP

SOAP 4-7.1

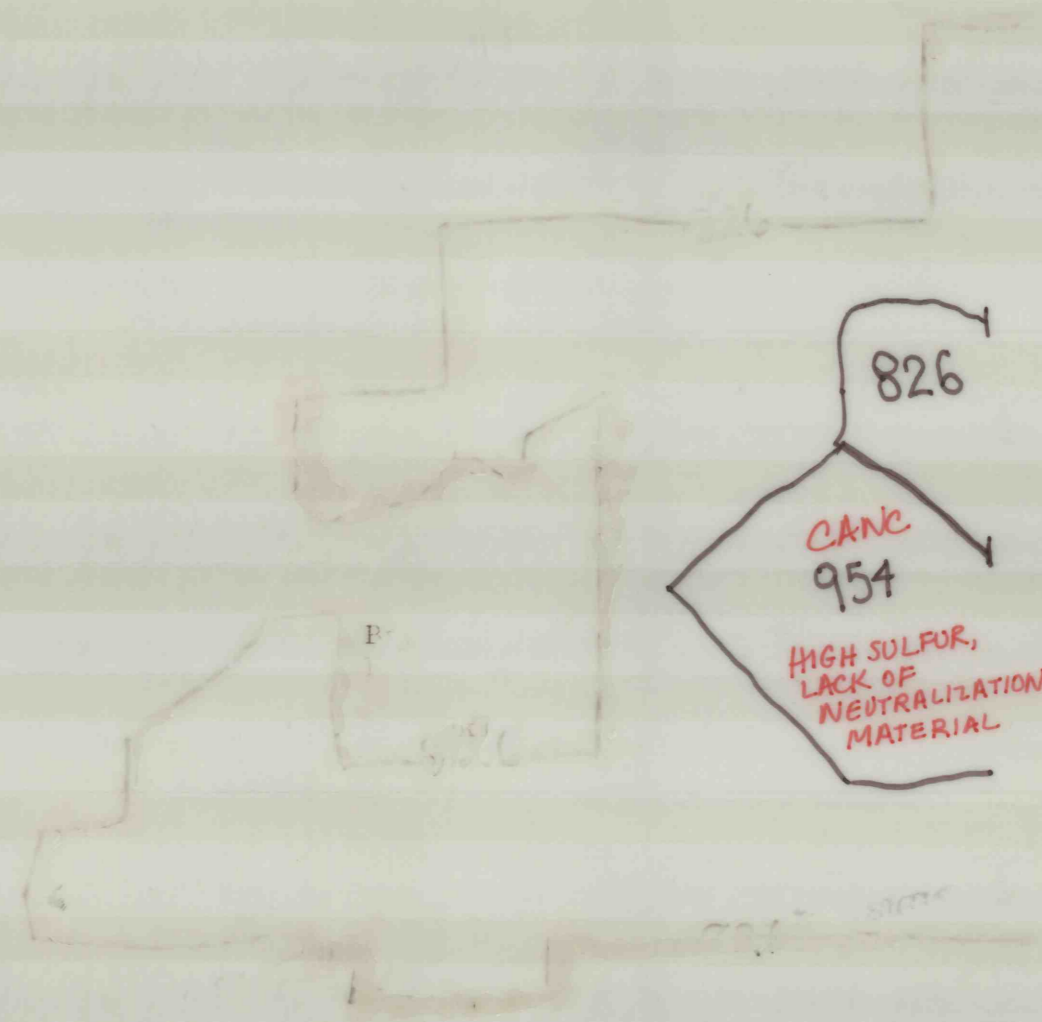

NPHC
SOAP
7.1
↑
PROBABLE SIGNIFICANT
IMPACT ON PRIVATE H₂O
SUPPLIES

