



PLAN HOLD

PEEL PROTECTIVE STRIP TO EXPOSE ADHESIVE. POSITION EDGE OF PRINT ON THIS LINE AND RUB TO ADHERE.


PLAN HOLD CORPORATION - TORRANCE, CALIFORNIA
REORDER BY NO. 0784-24

DRAWING NUMBER
A/4-7.1

0913

COAL 104

A/4-7.1 (Sheet 1 of 2)
0913

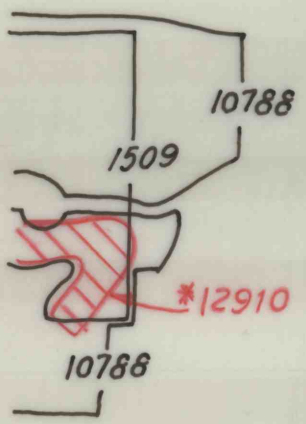

Knockdale Coal & Coke Co.
(Cedar No. 3)
W.P.A. 4-7.5

