PLAN HOLD
PEEL PROTECTIVE STRIP TO EXPOSE ADHESIVE. POSITION EDGE OF PRINT ON THIS LINE AND RUB TO ADHERE.
DRAWING NUMBER
B/4-7.1
0913
PLAN HOLD CORPORATION · TORRANCE · CALIFORNIA
REORDER BY NO. 070SA-24

COAL 107
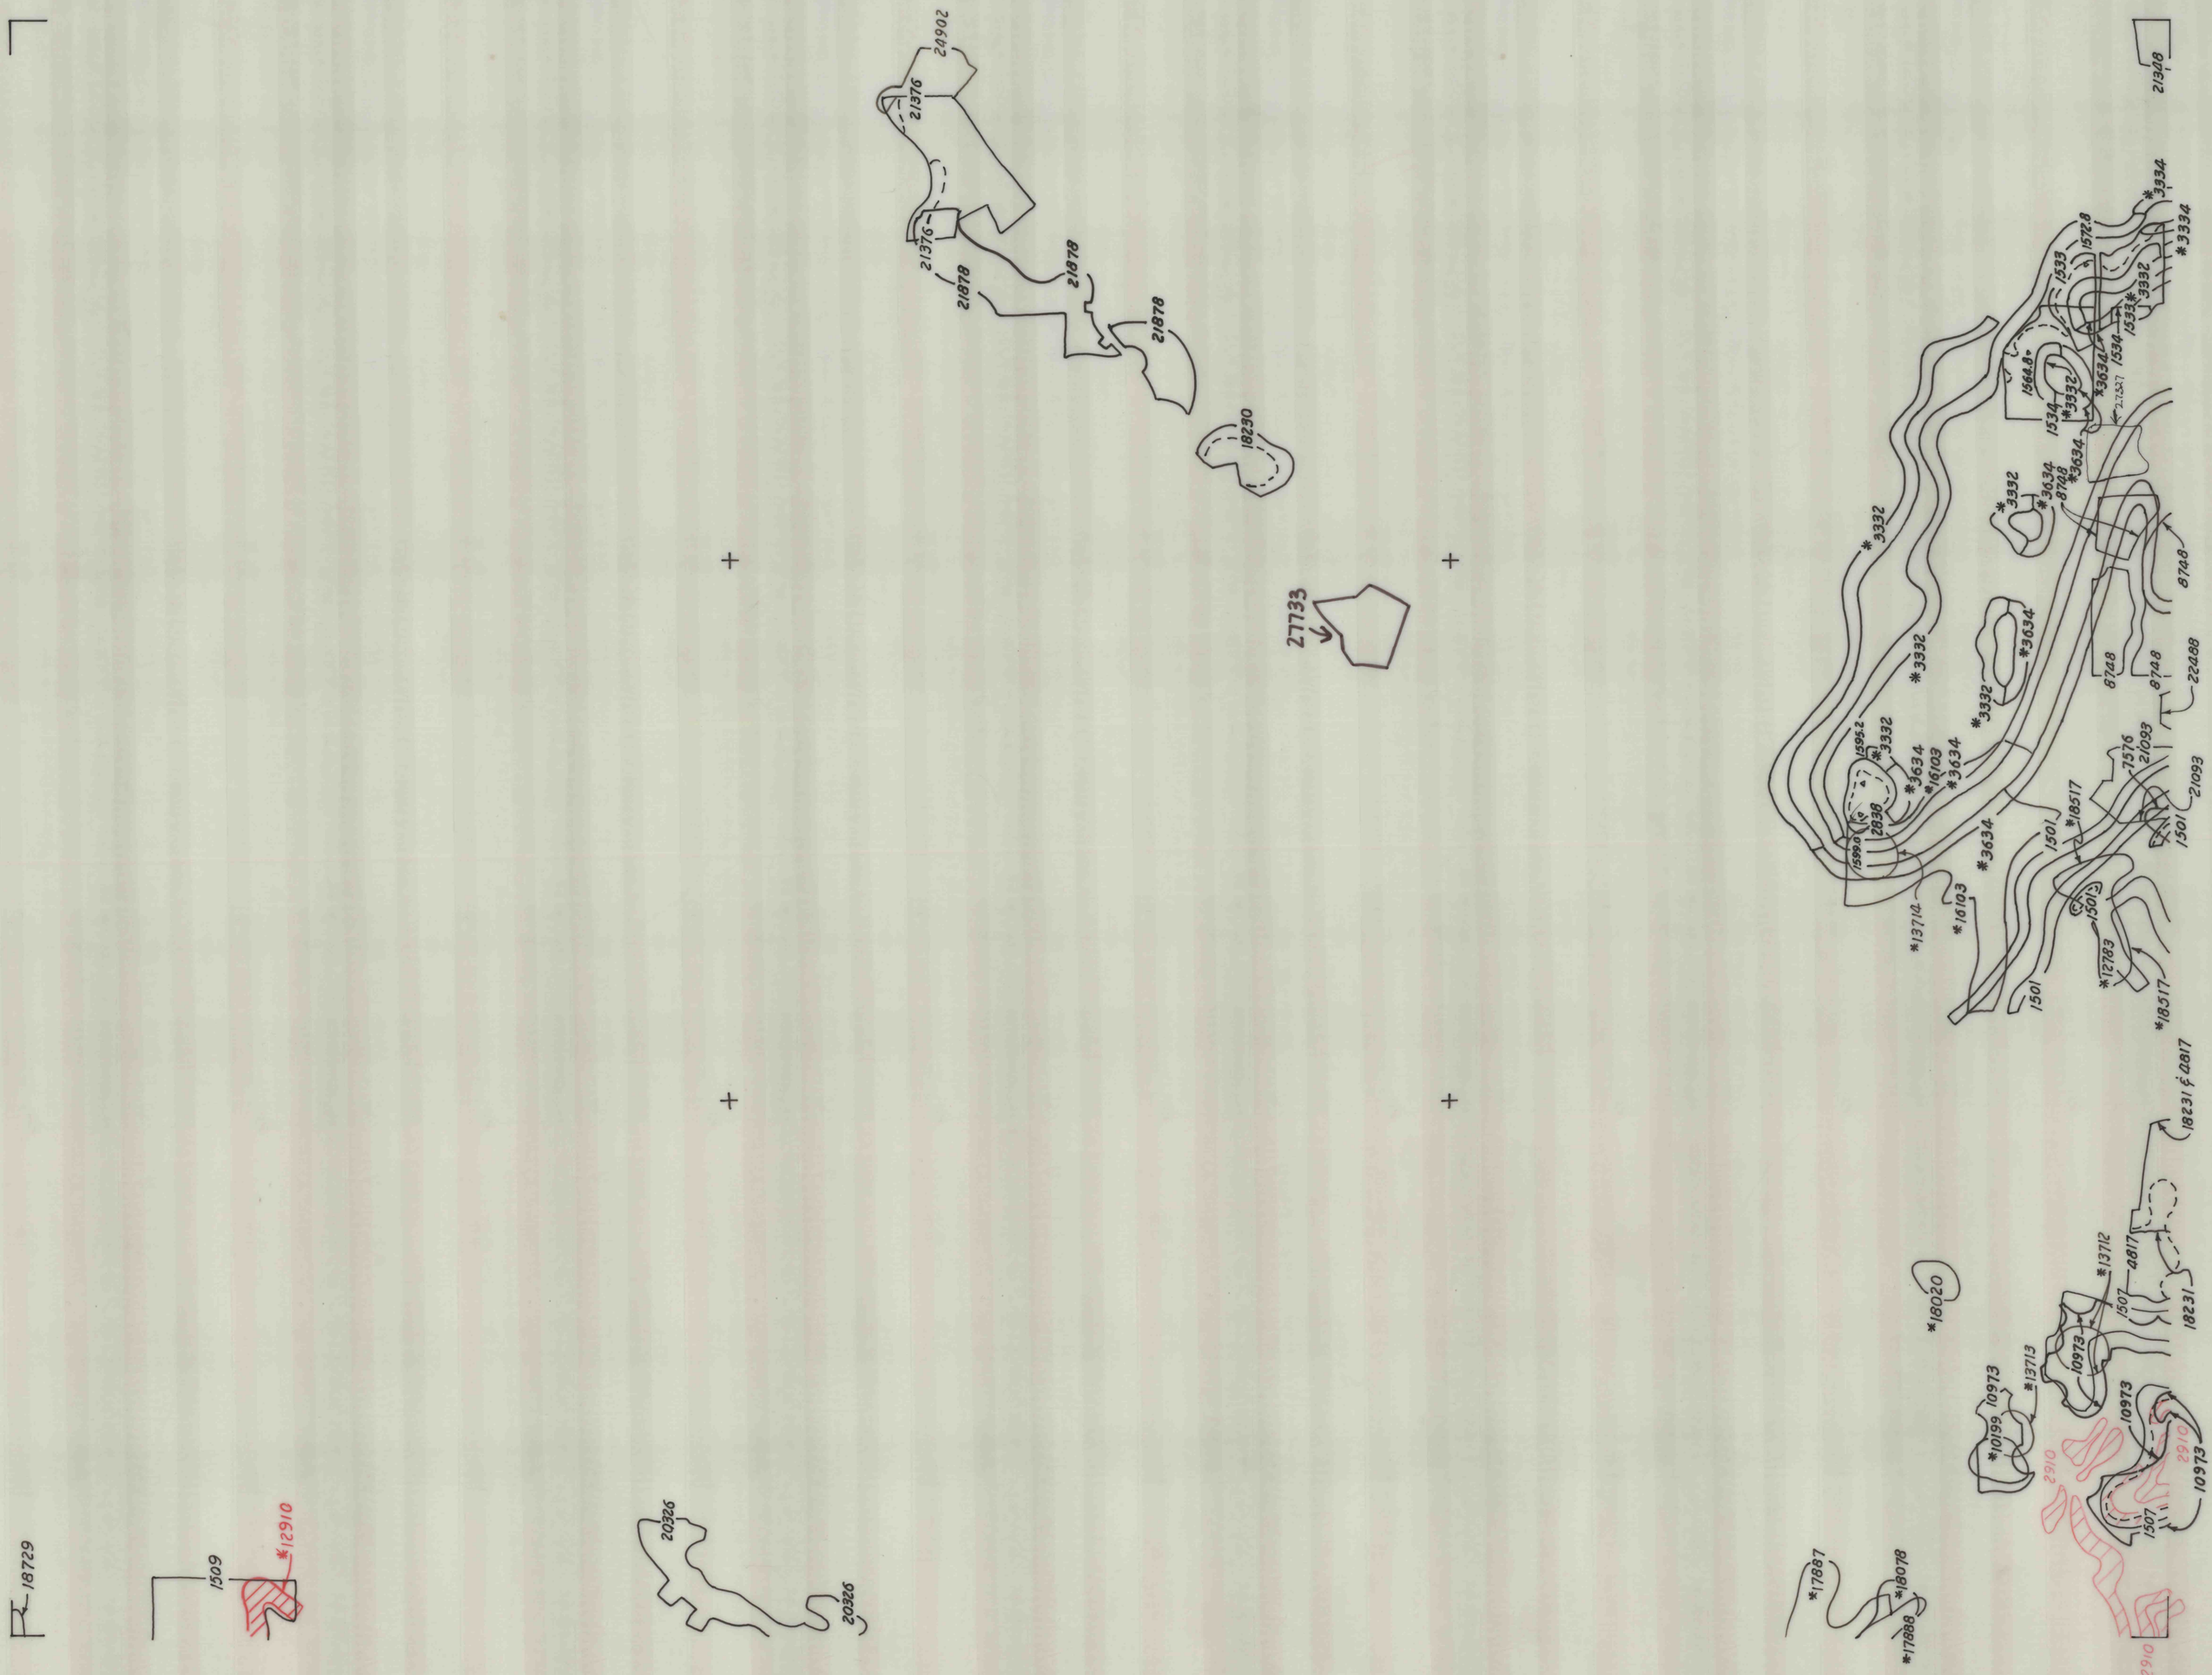
B/4-7.1
0913