


5966 I NW
(SW-10P)

UNITED STATES
DEPARTMENT OF THE INTERIOR
GEOLOGICAL SURVEY






BUSHKILL QUADRANGLE
PENNSYLVANIA-NEW JERSEY
7.5 MINUTE SERIES (TOPOGRAPHIC)

5966 II NW
(LAKE WASHINGTON)

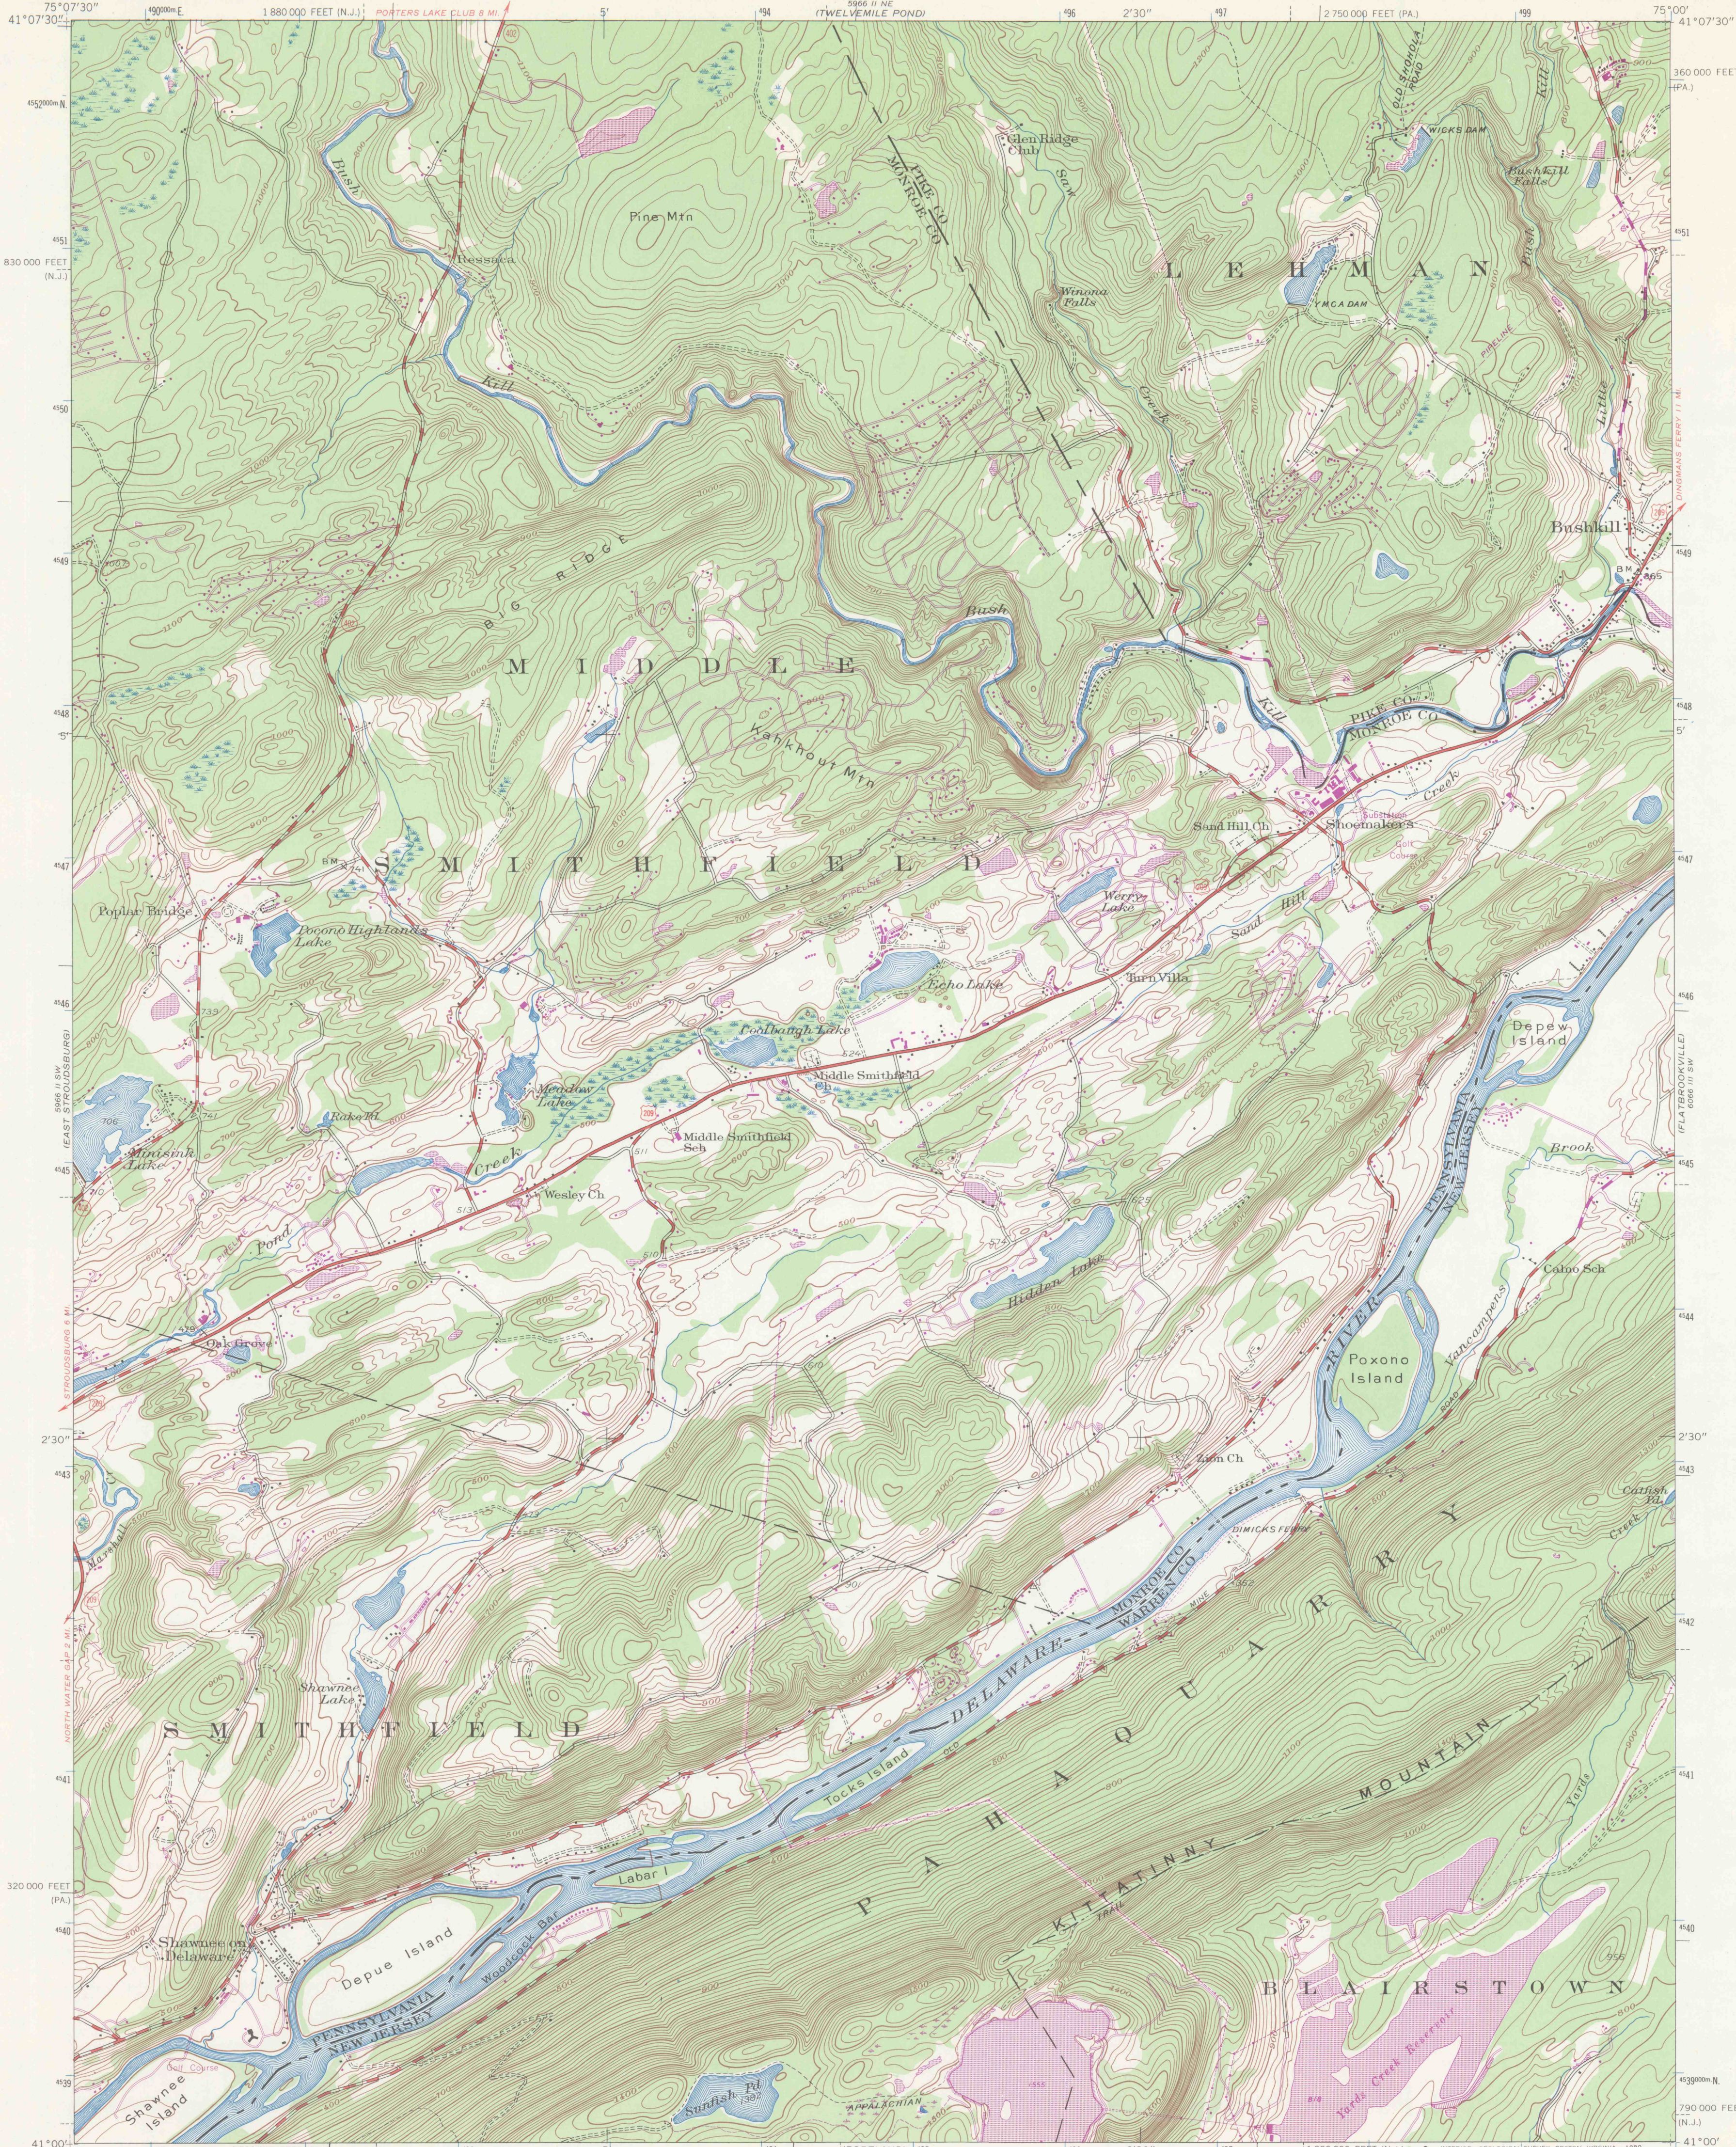

Mapped, edited, and published by the Geological Survey
Control by USGS and USC&GS
Topography by photogrammetric methods from aerial photographs
Field checked 1944
Polyconic projection, 1927 North American Datum
10,000-foot grids based on Pennsylvania coordinate system, north zone,
and New Jersey coordinate system
1000-meter Universal Transverse Mercator grid ticks,
zone 18, shown in blue
To place on the predicted North American Datum 1983
move the projection lines 6 meters south and
32 meters west as shown by dashed corner ticks
Revisions shown in purple compiled in cooperation with
State of Pennsylvania agencies from aerial photographs
taken 1968 and 1973. This information not field checked

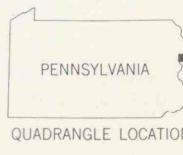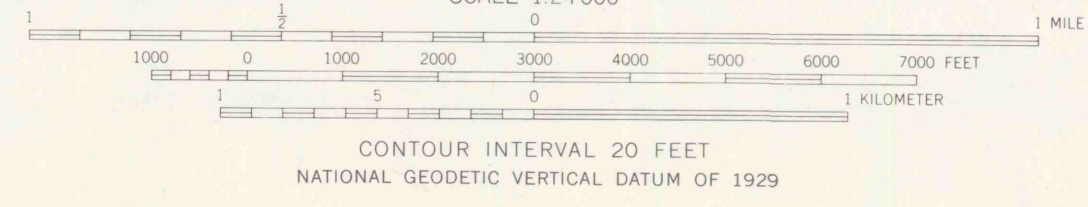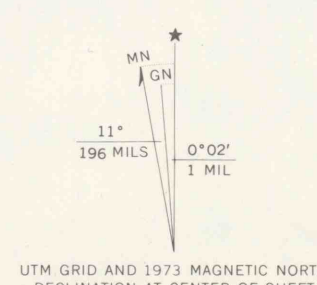

ROAD CLASSIFICATION

Heavy-duty	Light-duty
Medium-duty	Unimproved dirt
U.S. Route	State Route

BUSHKILL, PA. - N. J.
N4100-W7500/7.5

1944
PHOTOREVISED 1968 AND 1973
AMS 5966 II SE-SERIES V831

DRAWING NUMBER
4-23.2
1045

DRAWING NUMBER
Bushkill