


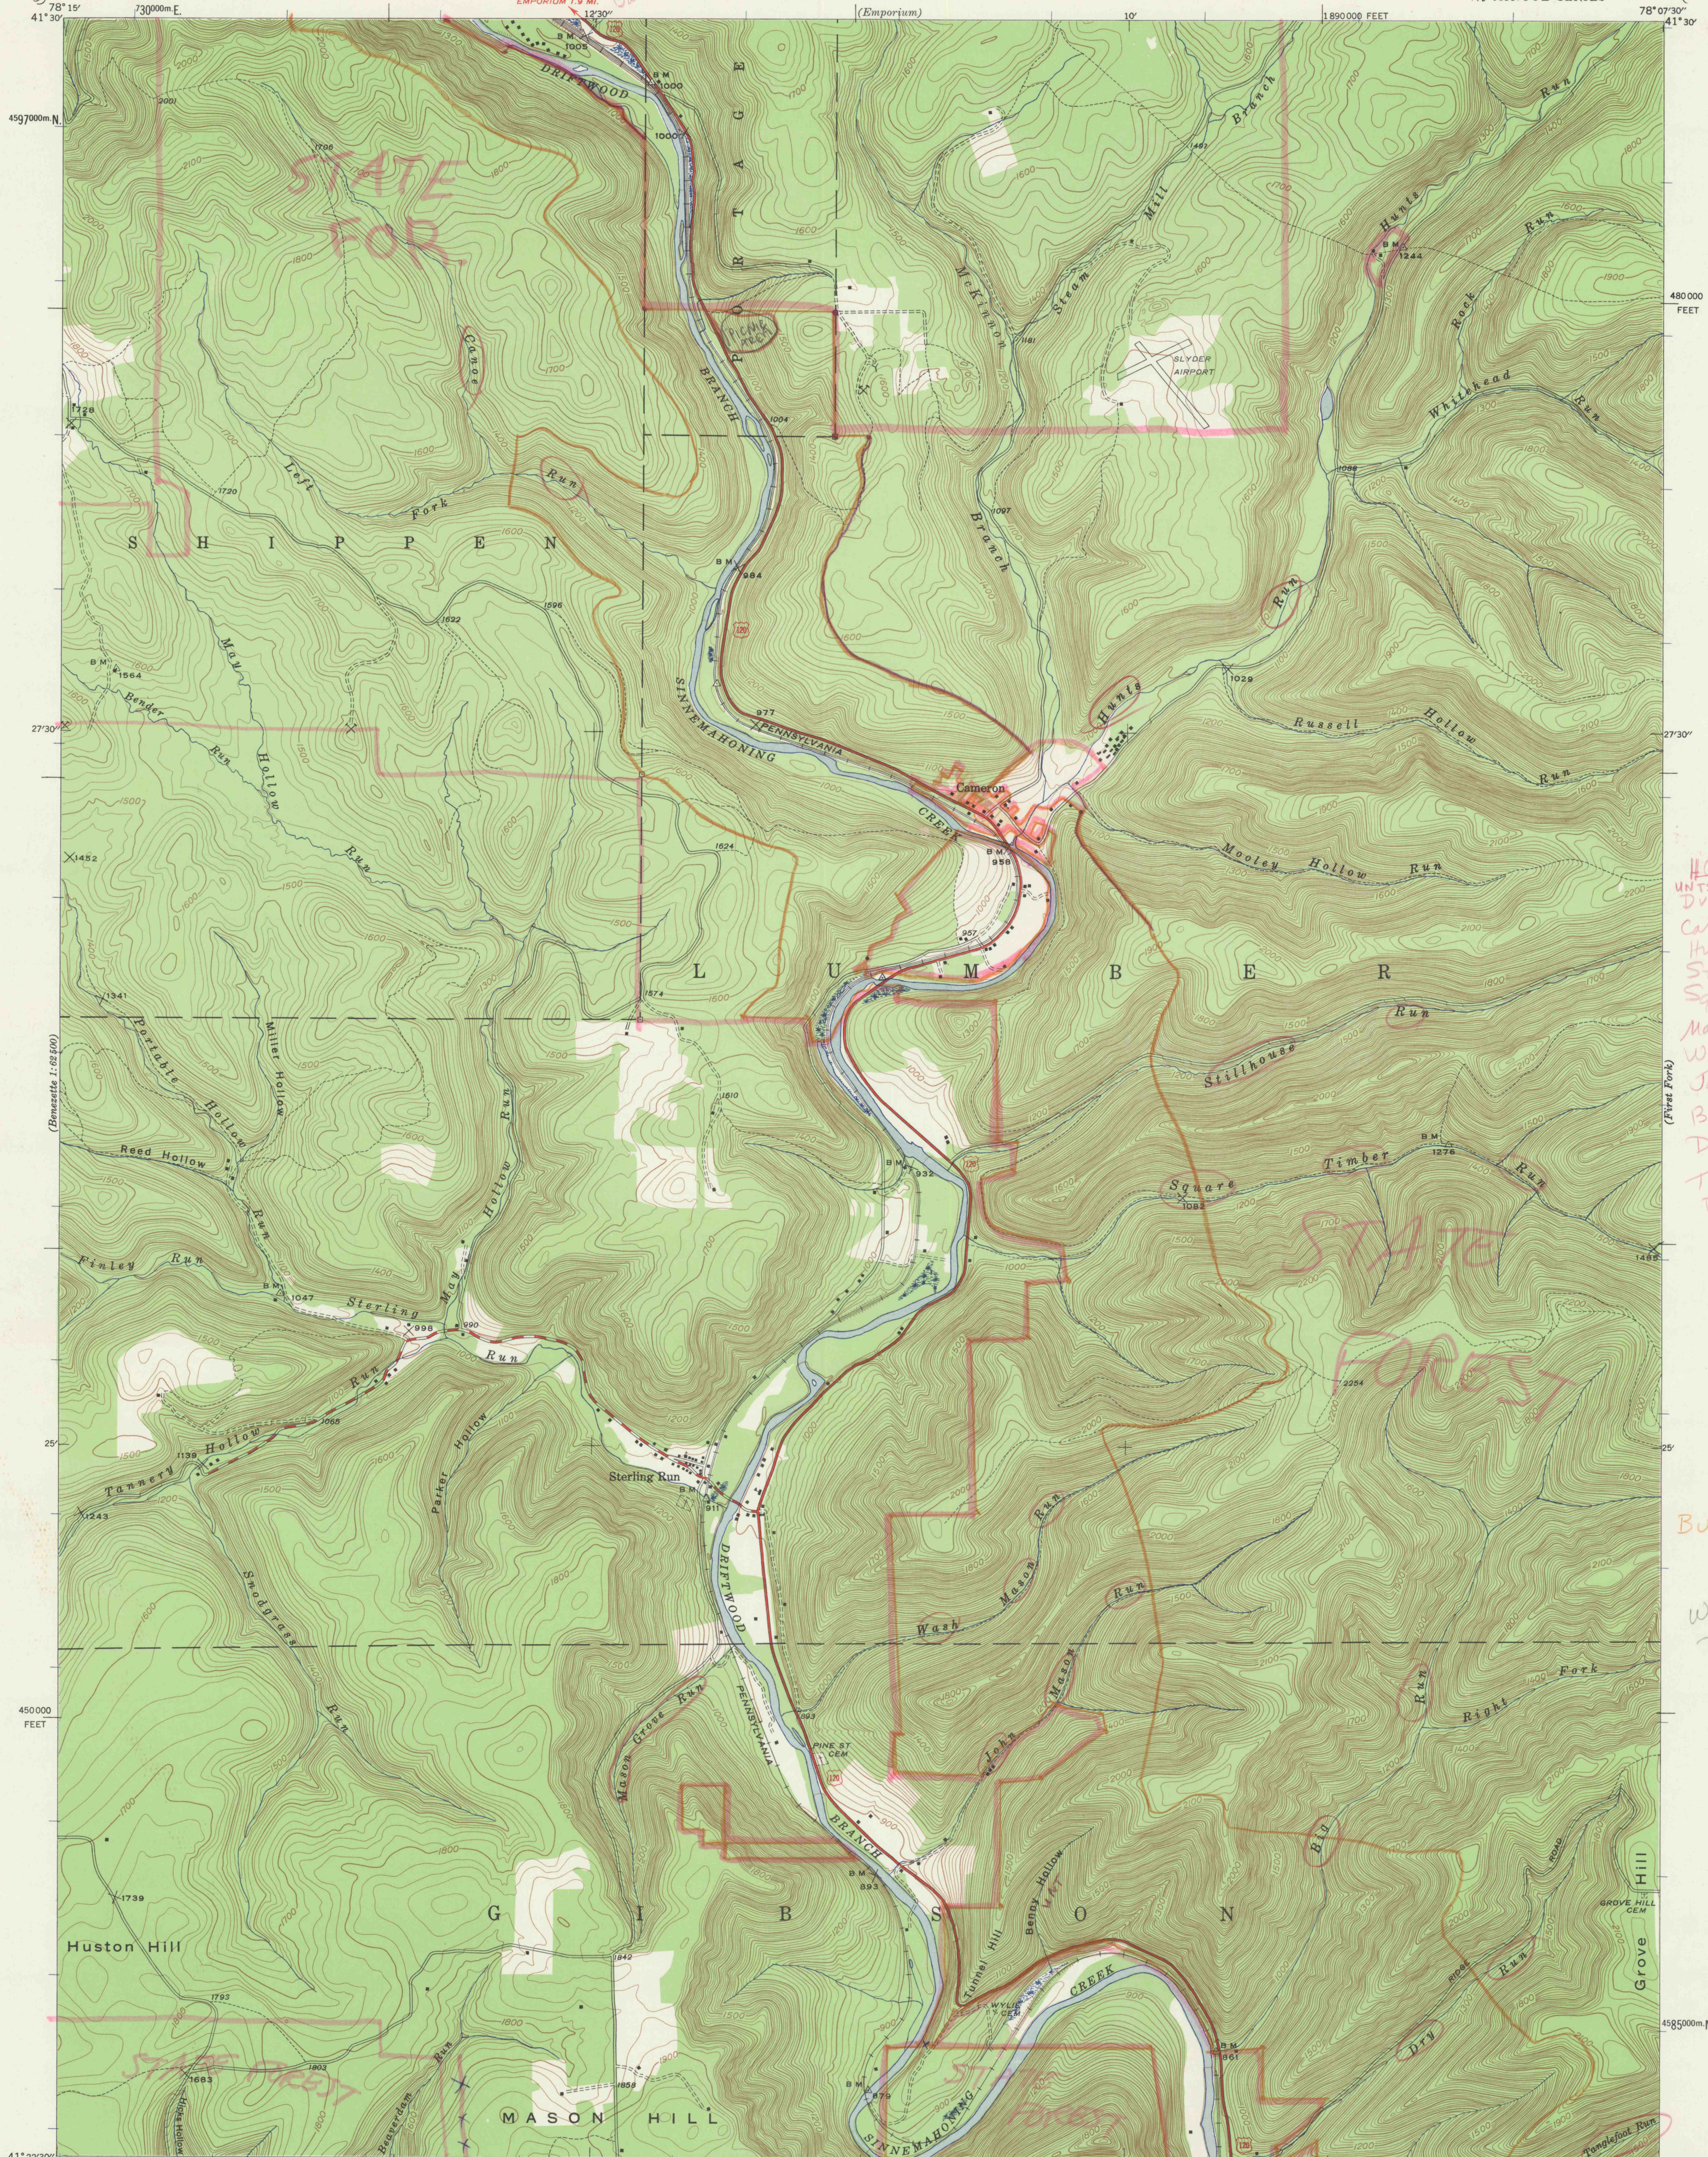

40 streams
UNTS. OF
Driftwood Br.
Cane Run
Hunt Run
Stillhouse Br.
Square Timber Br.
Mason Grove Br.
Wash Mason Br.
John Mason Br.
Big Run
Dry Run
Tanglefoot Br.
Bauer Hollow

BUCKTAIL SP
NAT. AREA.

Wayside
Memorial
SF Picnic
Area
Sec 2

State
Forest

DRAWING NUMBER

DRAWING NUMBER

DRAWING NUMBER
SAM/3-11.4

Maped by the Geological Survey
1945

ROAD CLASSIFICATION

Heavy-duty ——— Light-duty ———
Medium-duty ——— Unimproved dirt ———
U.S. Route

THIRD NORTH
MAGNETIC NORTH

APPROXIMATE MEAN
DECLINATION, 1945

SCALE 1:24,000

1 0 1000 2000 3000 4000 5000 6000 7000 FEET

1 0 1 2 KILOMETER

CONTOUR INTERVAL 20 FEET
DATUM IS MEAN SEA LEVEL

Projected projection. 1927 North American datum
10,000-foot grid based on Pennsylvania (North)
rectangular coordinate system
1000-meter Universal Transverse Mercator grid ticks,
zone 17, shown in blue

CAMERON, PA.
N 4122.5 - W 7807.5 / 7.5
1945

3-11.4