

DRAWING NUMBER

PLAN HOLD CORPORATION • PRIME, CALIFORNIA

REORDER BY NUMBER 07348

FORMER NAME OF PLAN: 07348

DRAWING NUMBER

PLAN HOLD CORPORATION • PRIME, CALIFORNIA

REORDER BY NUMBER 07348

FORMER NAME OF PLAN: 07348

DRAWING NUMBER

PLAN HOLD CORPORATION • PRIME, CALIFORNIA

REORDER BY NUMBER 07348

FORMER NAME OF PLAN: 07348



SOAP

SOAP

PLAN HOLD CORPORATION • PRIME, CALIFORNIA

REORDER BY NUMBER 07348

FORMER NAME OF PLAN: 07348

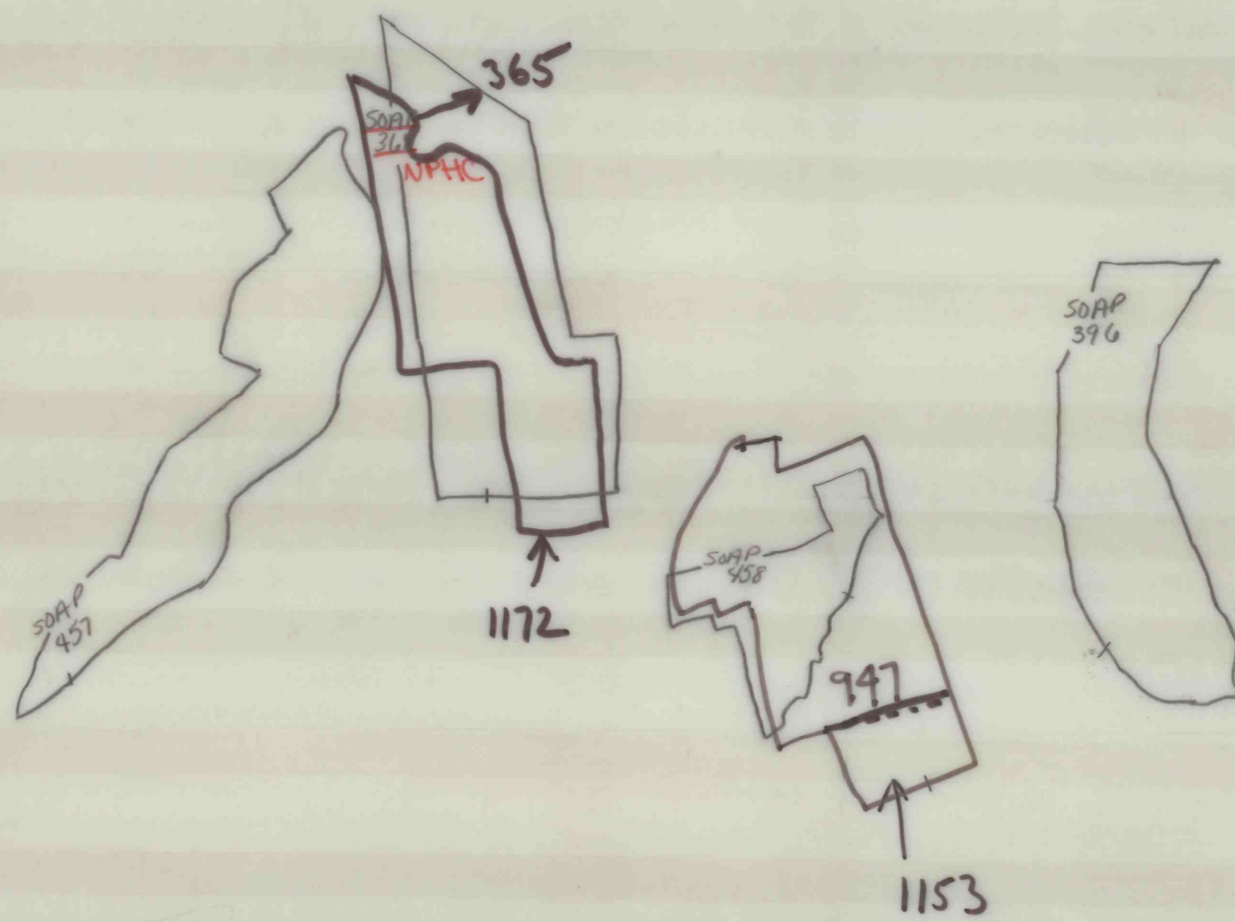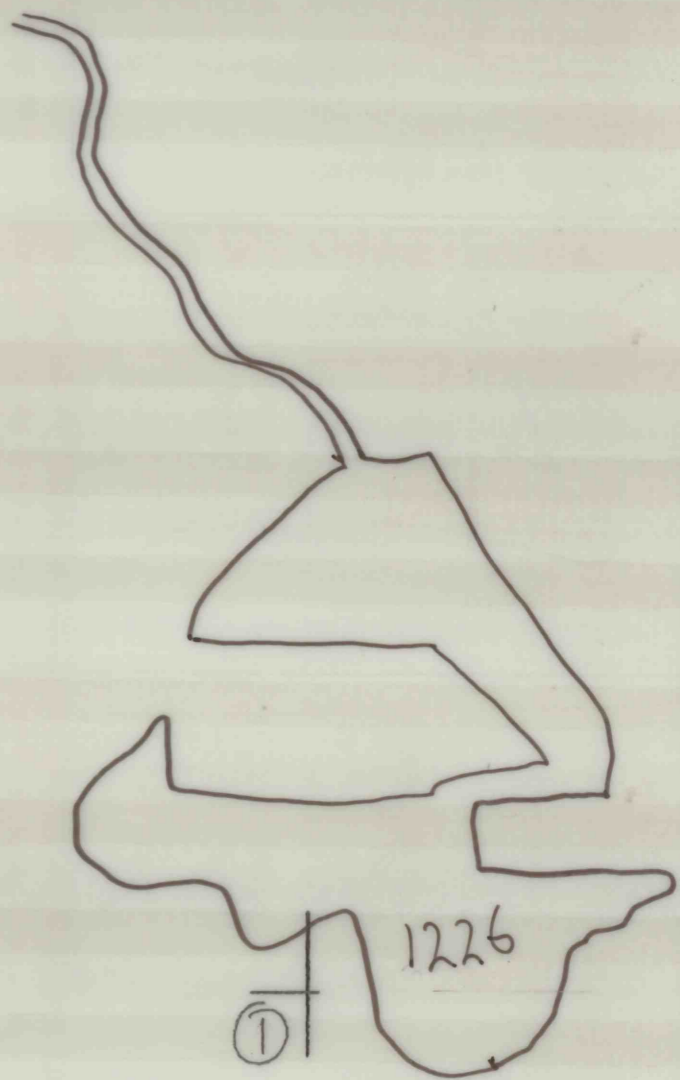

15251