PLAN HOLD

PEEL PROTECTIVE STRIP TO EXPOSE ADHESIVE. POSITION EDGE OF PRINT ON THIS LINE AND RUB TO ADHERE.

DRAWING NUMBER
B/4-10.3

PLAN HOLD CORPORATION IRVINE CALIFORNIA
REORDER BY NO. 070SA-24

1018

COAL 107
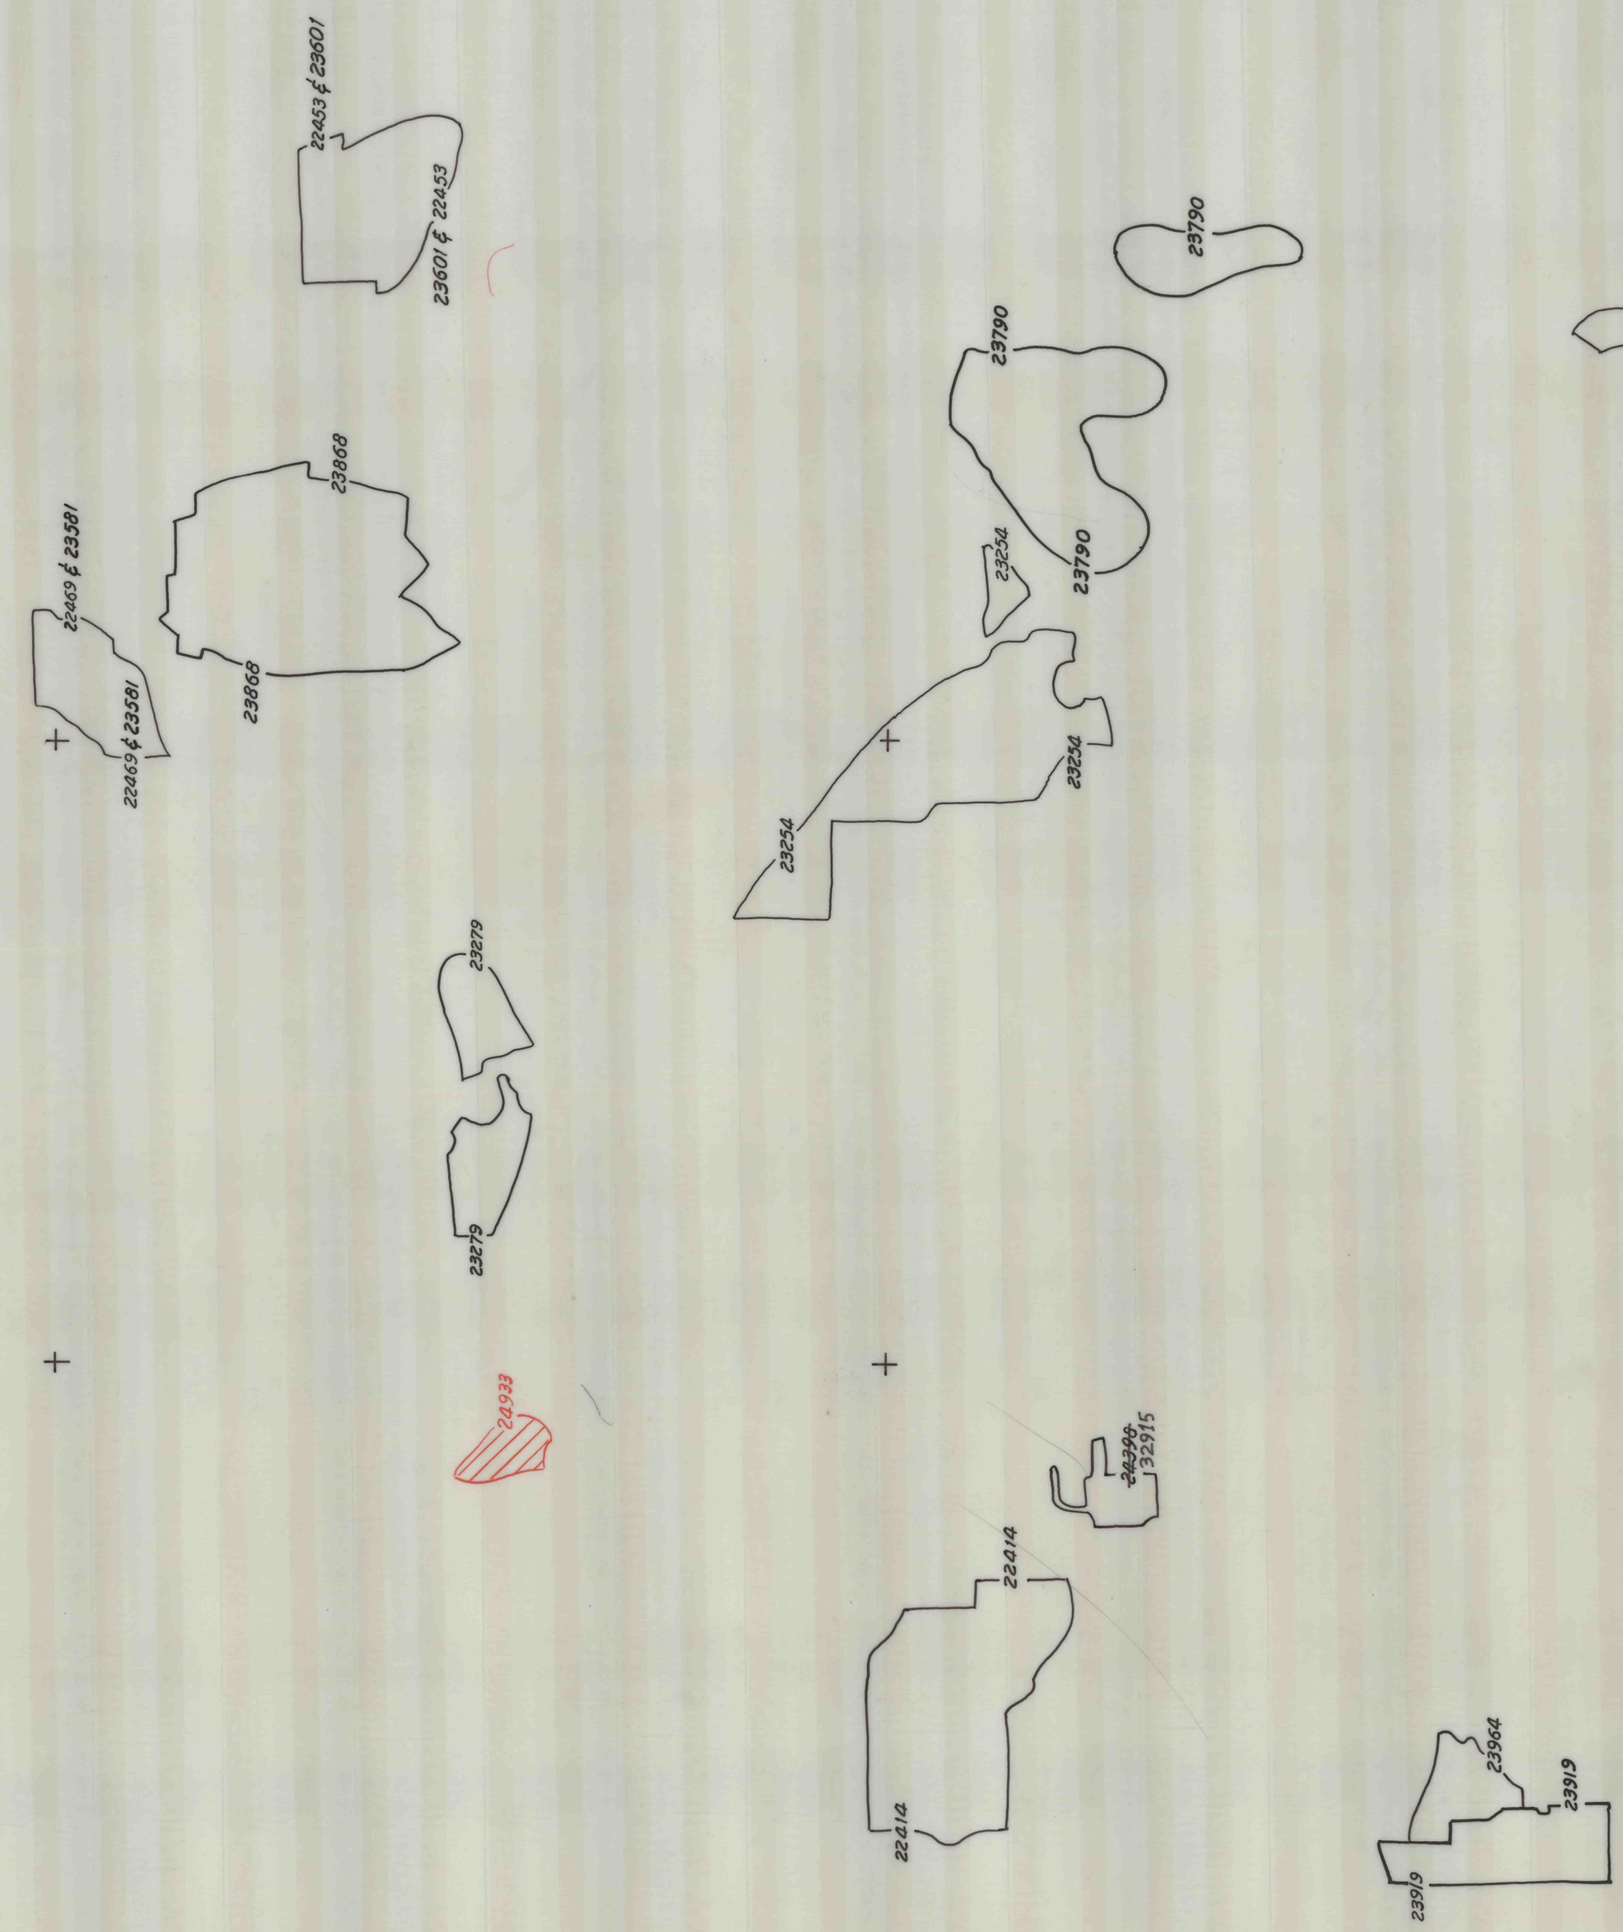
B/4-10.3 (Sheet 2 of 3)
1018