PLAN HOLD

PEEL PROTECTIVE STRIP TO EXPOSE ADHESIVE. POSITION EDGE OF PRINT ON THIS LINE AND RUB TO ADHERE.

DRAWING NUMBER
C/4-10.3

PLAN HOLD CORPORATION · TORRANCE · CALIFORNIA
REORDER BY NO. 0705A-24

1018

COAL 108
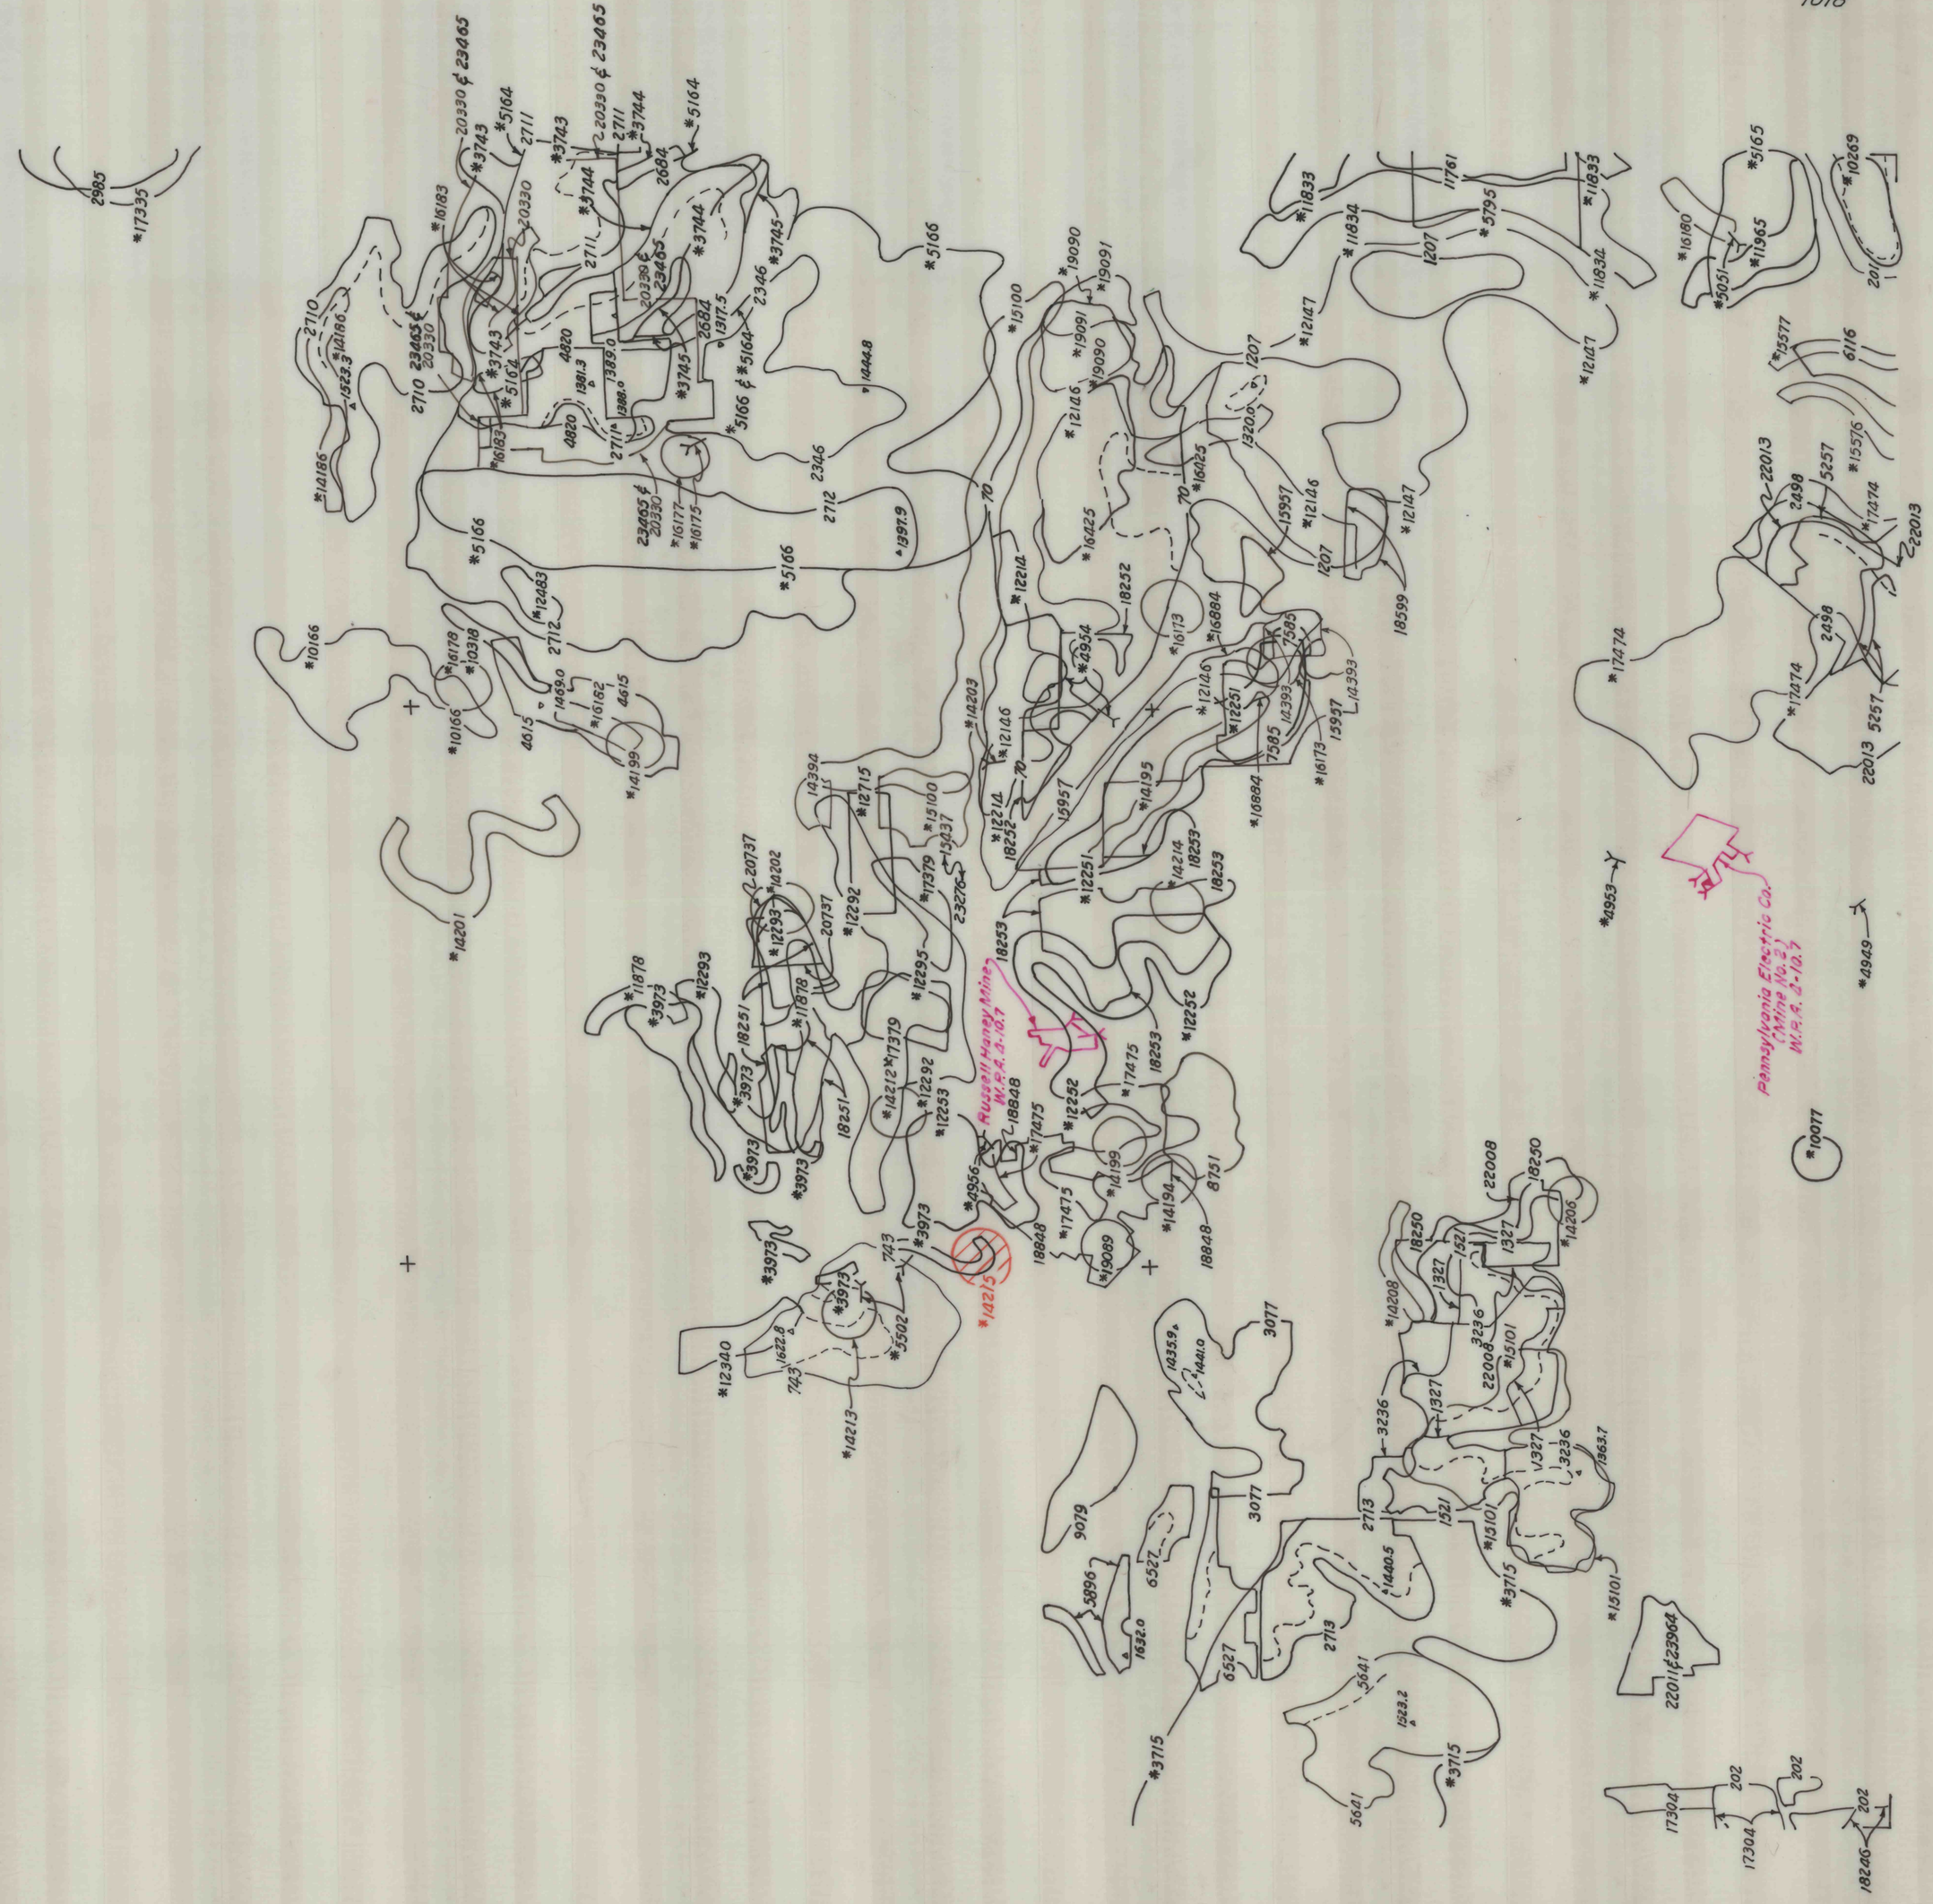
C/4-10.3 (Sheet 1 of 3)
1018