


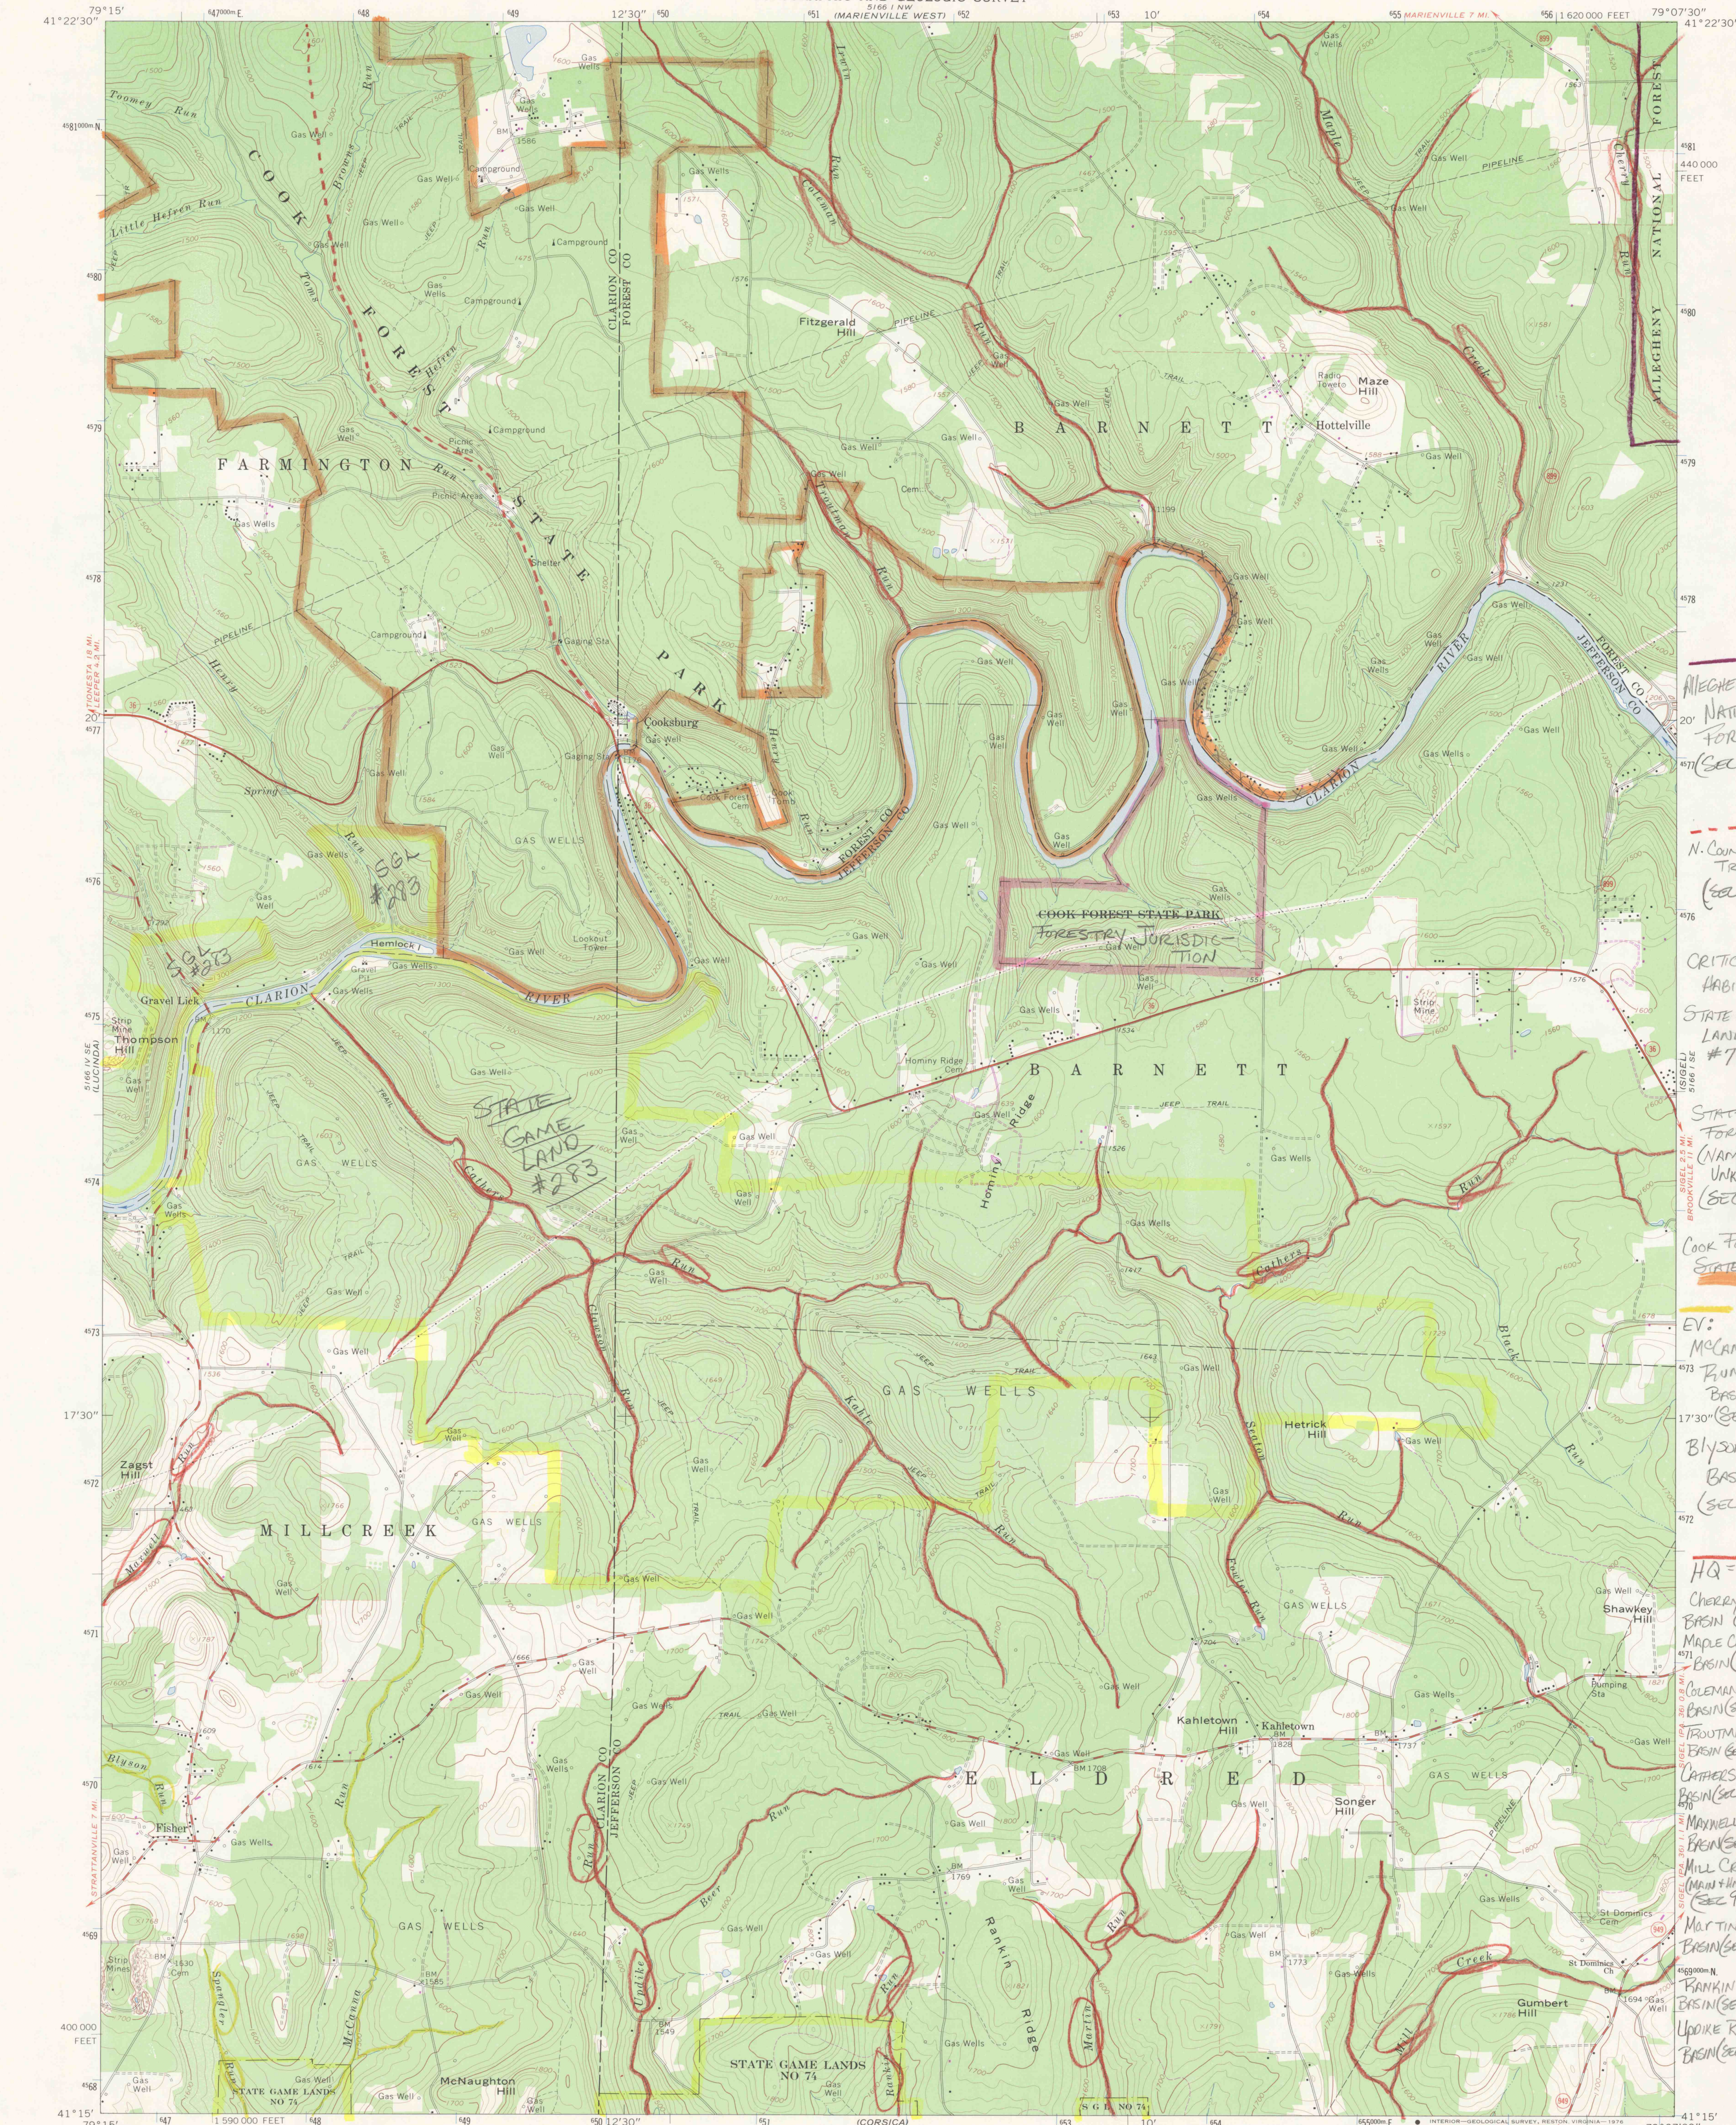



Mapped, edited, and published by the Geological Survey
Control by USGS and USC&GS

Topography by photogrammetric methods from aerial
photographs taken 1967 and 1968. Field checked 1967

Polyconic projection. 1927 North American datum
10,000-foot grid based on Pennsylvania coordinate system,
north zone
1000-metre Universal Transverse Mercator grid ticks,
zone 17, shown in blue

Fine red dashed lines indicate selected fence and field lines where
generally visible on aerial photographs. This information is unchecked

Revisions shown in purple compiled in cooperation with
State of Pennsylvania agencies from aerial photographs
taken 1973. This information not field checked

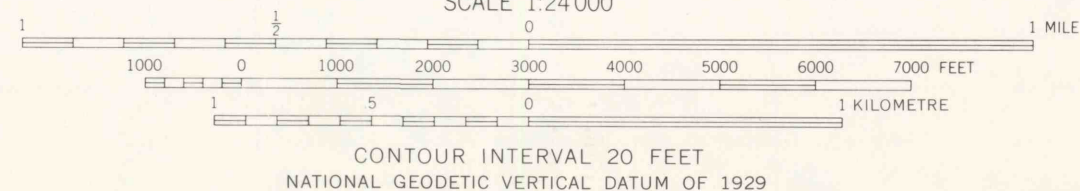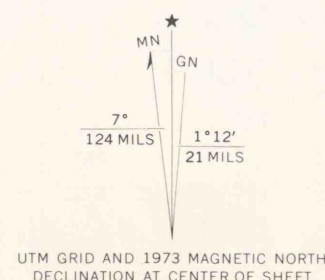

THIS MAP COMPLIES WITH NATIONAL MAP ACCURACY STANDARDS
FOR SALE BY U.S. GEOLOGICAL SURVEY, RESTON, VIRGINIA 22092
A FOLDER DESCRIBING TOPOGRAPHIC MAPS AND SYMBOLS IS AVAILABLE ON REQUEST

ROAD CLASSIFICATION
Primary highway, all weather, hard surface
Secondary highway, all weather, hard surface
Light-duty road, all weather, improved surface
Unimproved road, fair or dry weather
State Route

COOKSBURG, PA.

N4115—W7907.5/7.5

1967
PHOTOREVISED 1973
AMS 5166 I SW—SERIES V851

Allegheny National Forest (Sec. 3)

N. Country Trail (Sec. 1)

CRITICAL HABITAT:
STATE GAME LANDS #74+283

STATE FOREST (NAME UNKNOWN) (Sec. 5)

COOK FOREST STATE PARK

EV:
McANNA RUN BASIN (Sec. 7)

BLISSON RUN BASIN (Sec. 7)

HQ =
CHERRY RUN BASIN (Sec. 3)
MAPLE CREEK BASIN (Sec. 3)
COLEMAN RUN BASIN (Sec. 2)
TROUTMAN RUN BASIN (Sec. 2)
CATHERS RUN BASIN (Sec. 4, 5, 6)
MAXWELL RUN BASIN (Sec. 7)
MILL CREEK (MAIN TRIBUTES) (Sec. 9)
MARTIN RUN BASIN (Sec. 8)
FRANKLIN RUN BASIN (Sec. 8)
UPDIKE RUN BASIN (Sec. 8)

DRAWING NUMBER

DRAWING NUMBER

DRAWING NUMBER
SAM 3-7.3

0812