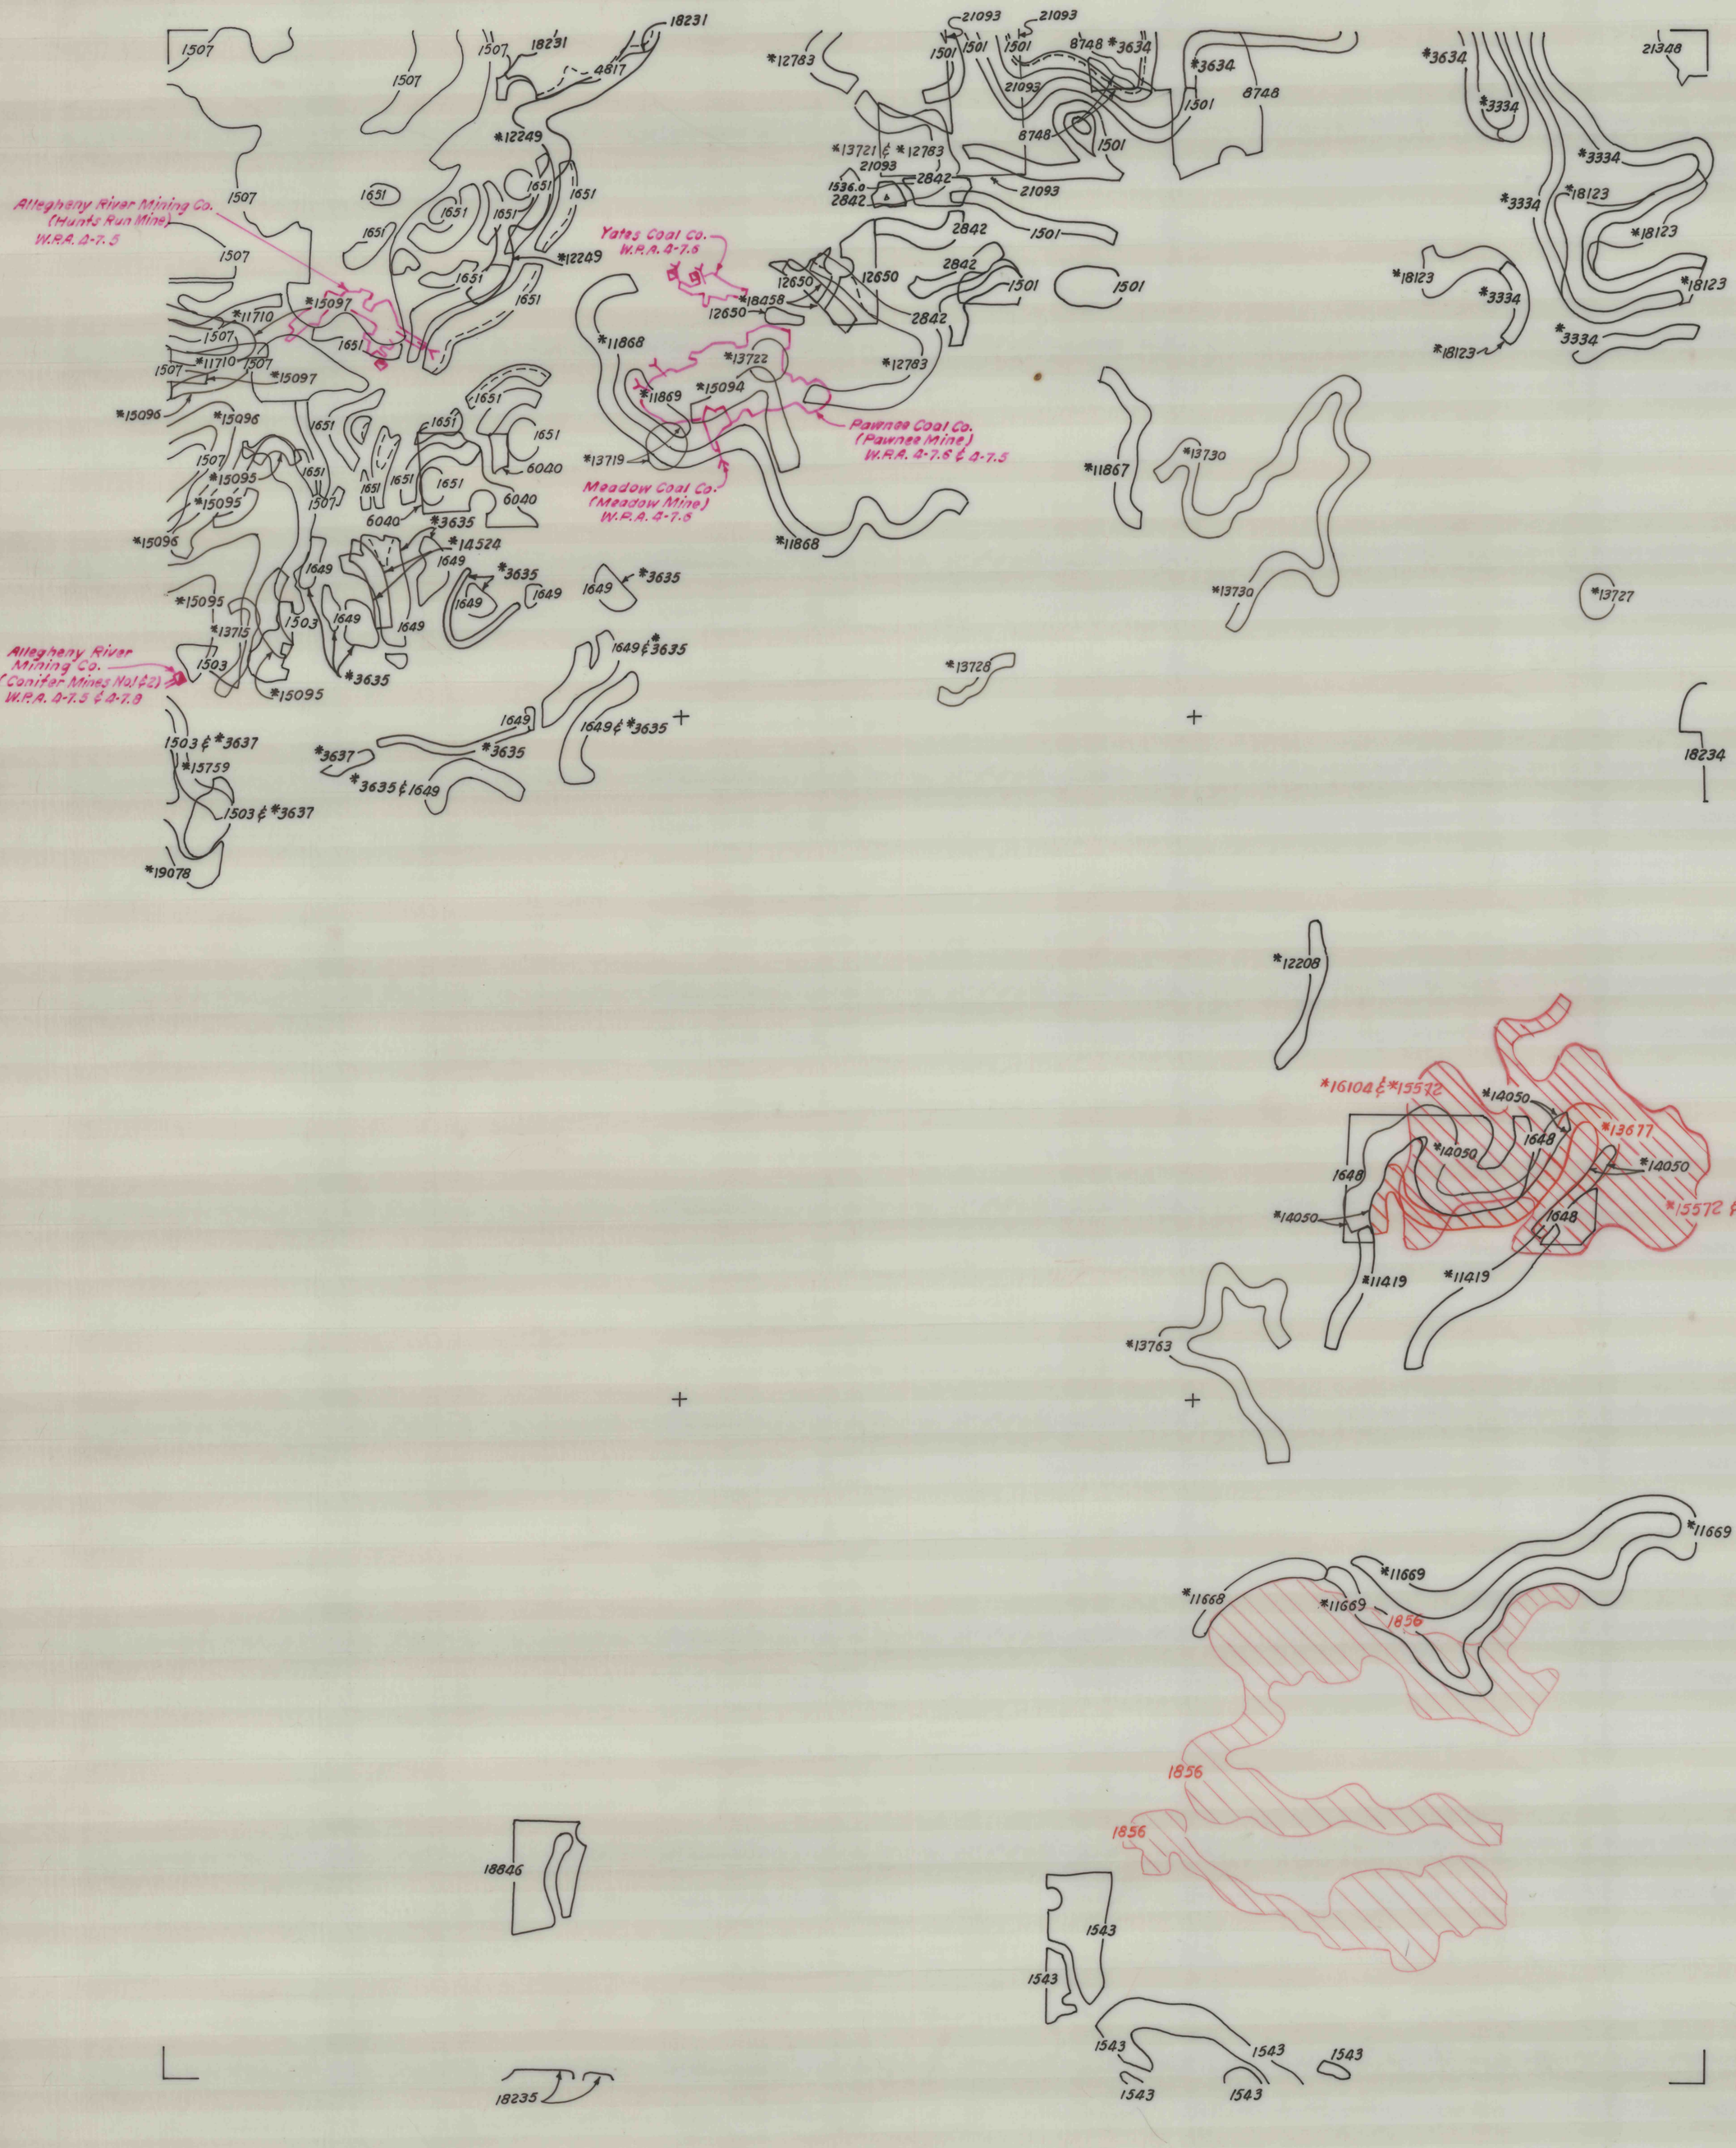

COAL104

A/4-7.2 (Sheet 1 of 2)
1013

DRAWING NUMBER
A/4-7.2
PLAN HOLD CORPORATION • IRVINE, CALIFORNIA
REORDER BY NUMBER 07DAR
POSITION EDGE OF PRINT ON THIS LINE

1013