

DRAWING NUMBER

PLAN HOLD CORPORATION • IRVINE, CALIFORNIA
REPORTER BY NUMBER 0704A

DRAWING NUMBER

PLAN HOLD CORPORATION • IRVINE, CALIFORNIA
REPORTER BY NUMBER 0704A

DRAWING NUMBER

PLAN HOLD CORPORATION • IRVINE, CALIFORNIA
REPORTER BY NUMBER 0704A

DRAWING NUMBER




PLAN HOLD CORPORATION • IRVINE, CALIFORNIA
REPORTER BY NUMBER 0704A

PROVISIONAL TITLE OF PLAN OR PROJECT

PROVISIONAL TITLE OF PLAN OR PROJECT

PROVISIONAL TITLE OF PLAN OR PROJECT

PROVISIONAL TITLE OF PLAN OR PROJECT

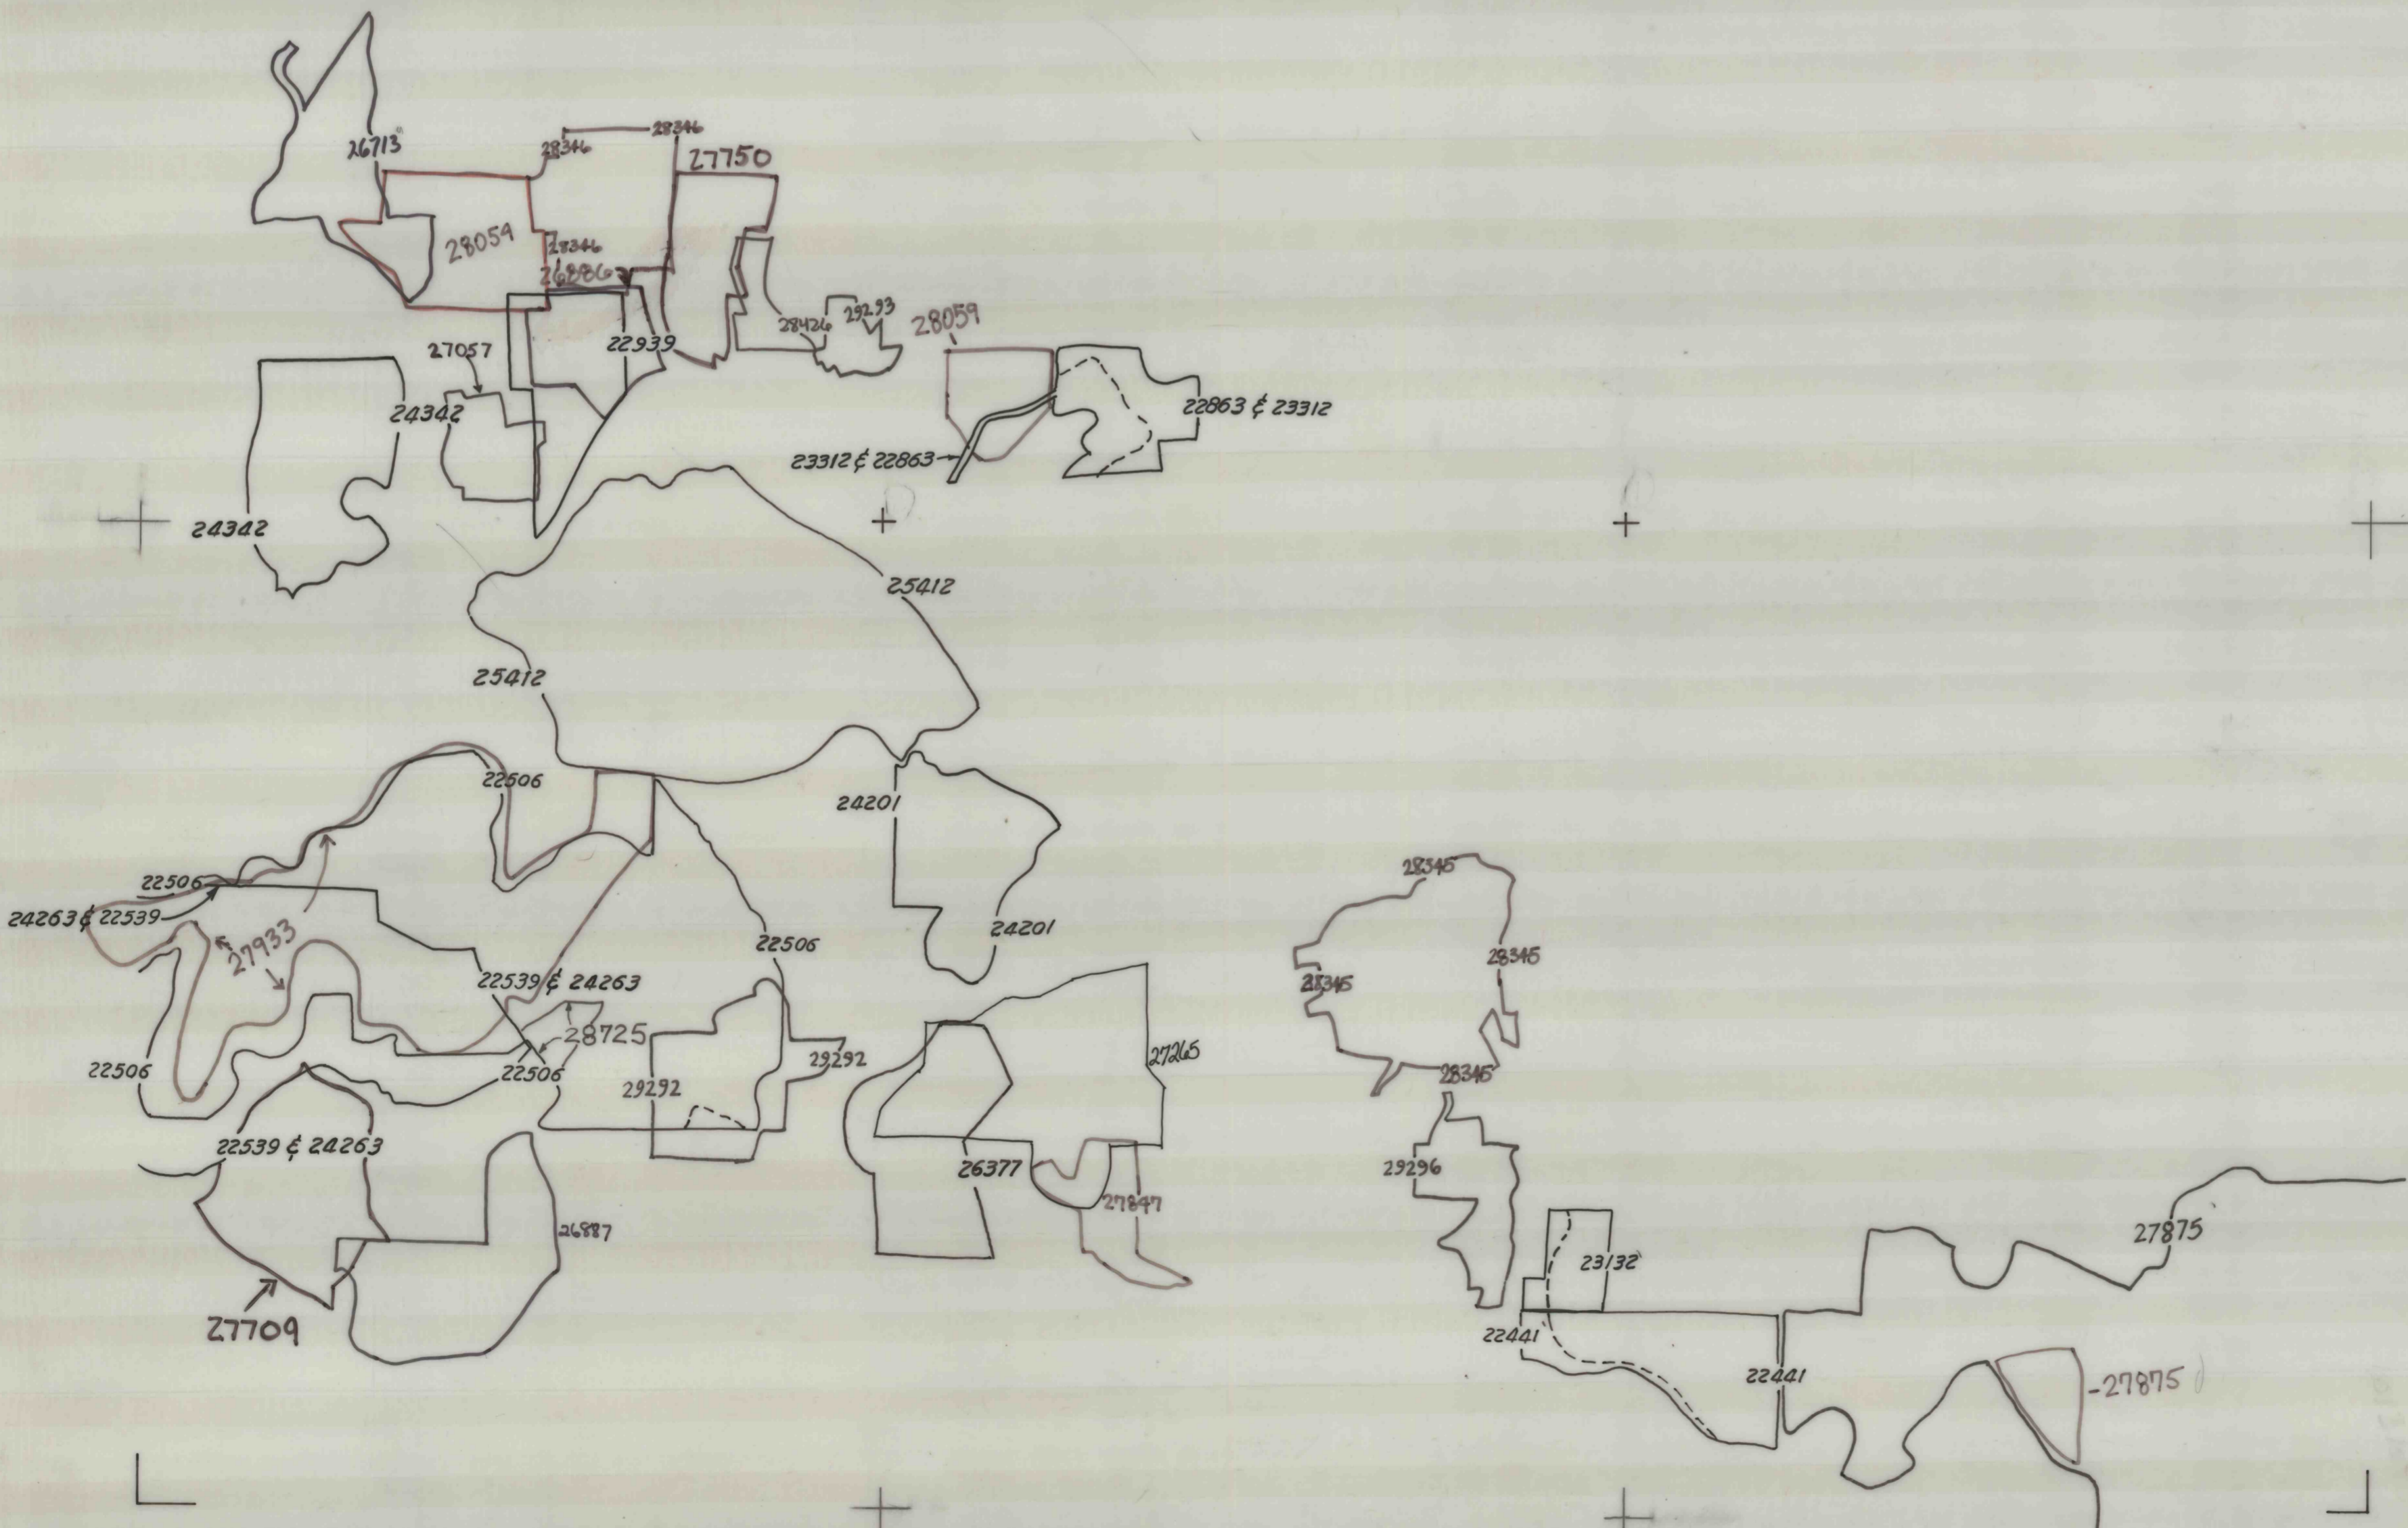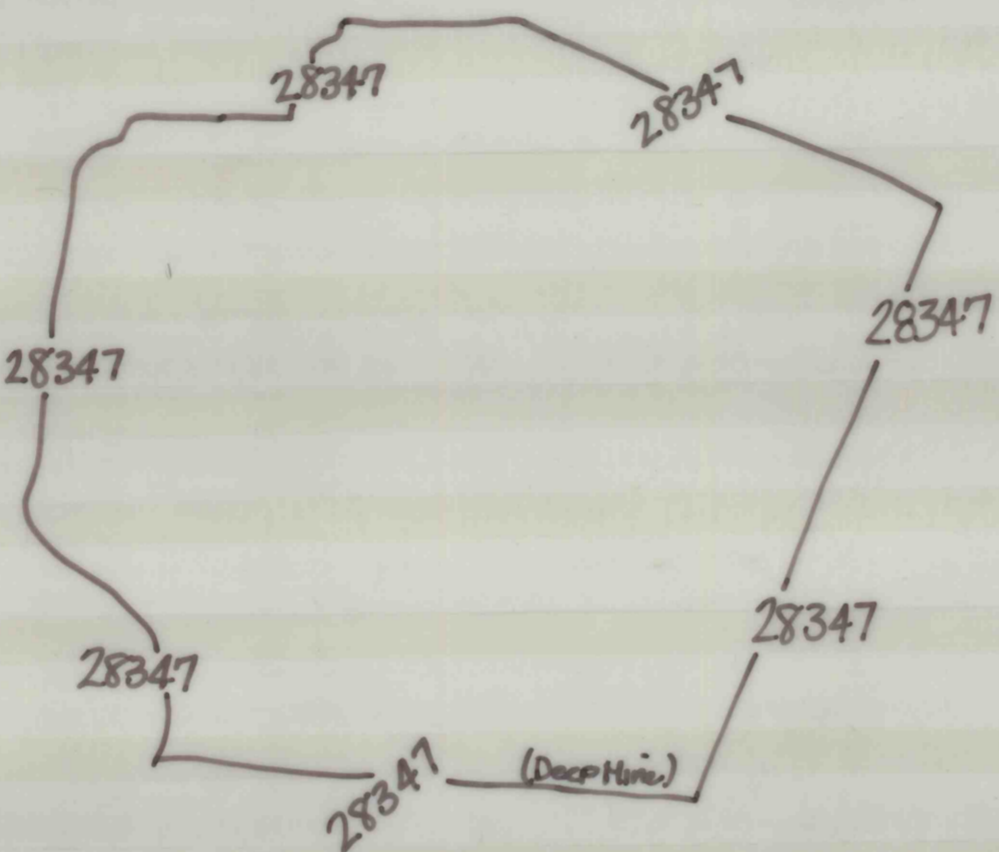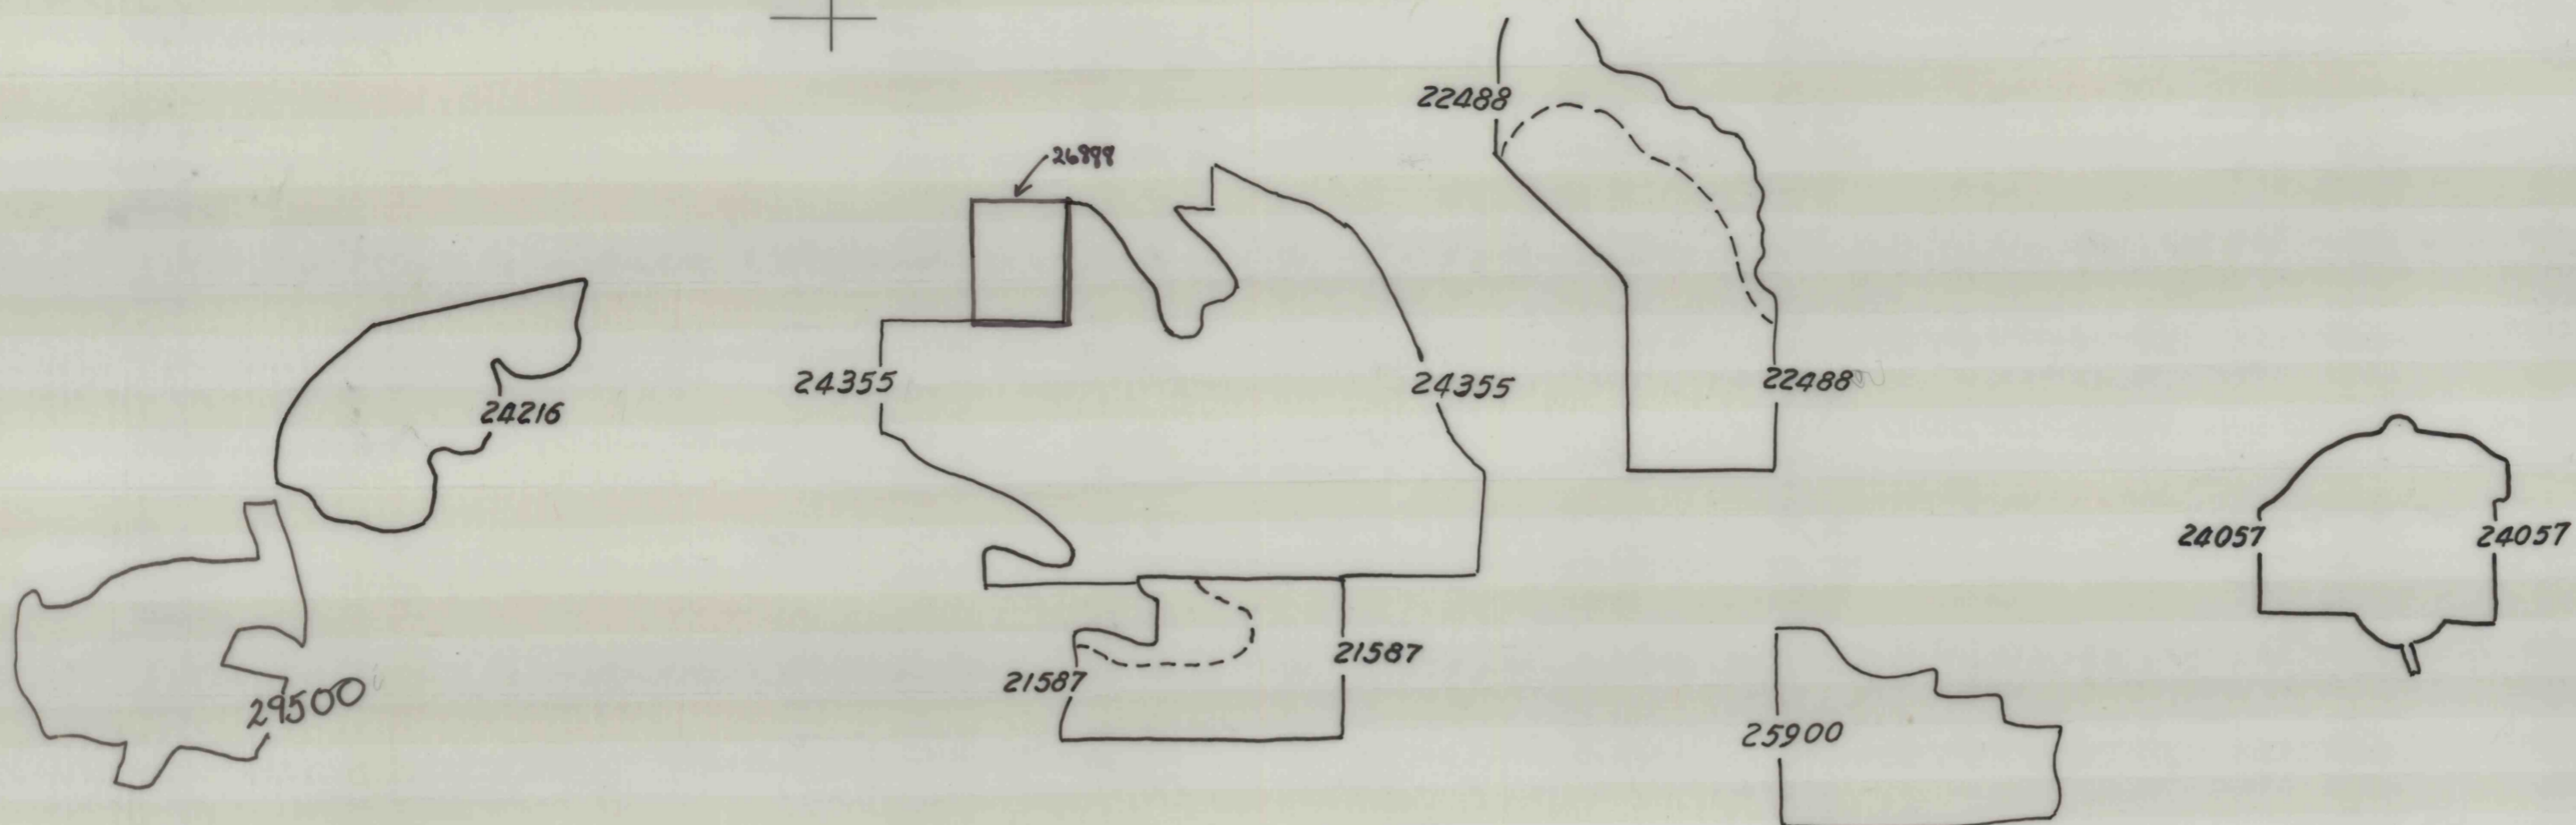

20A1107

B/4-7.2 (Sheet 2 of 2)
1013

1013