


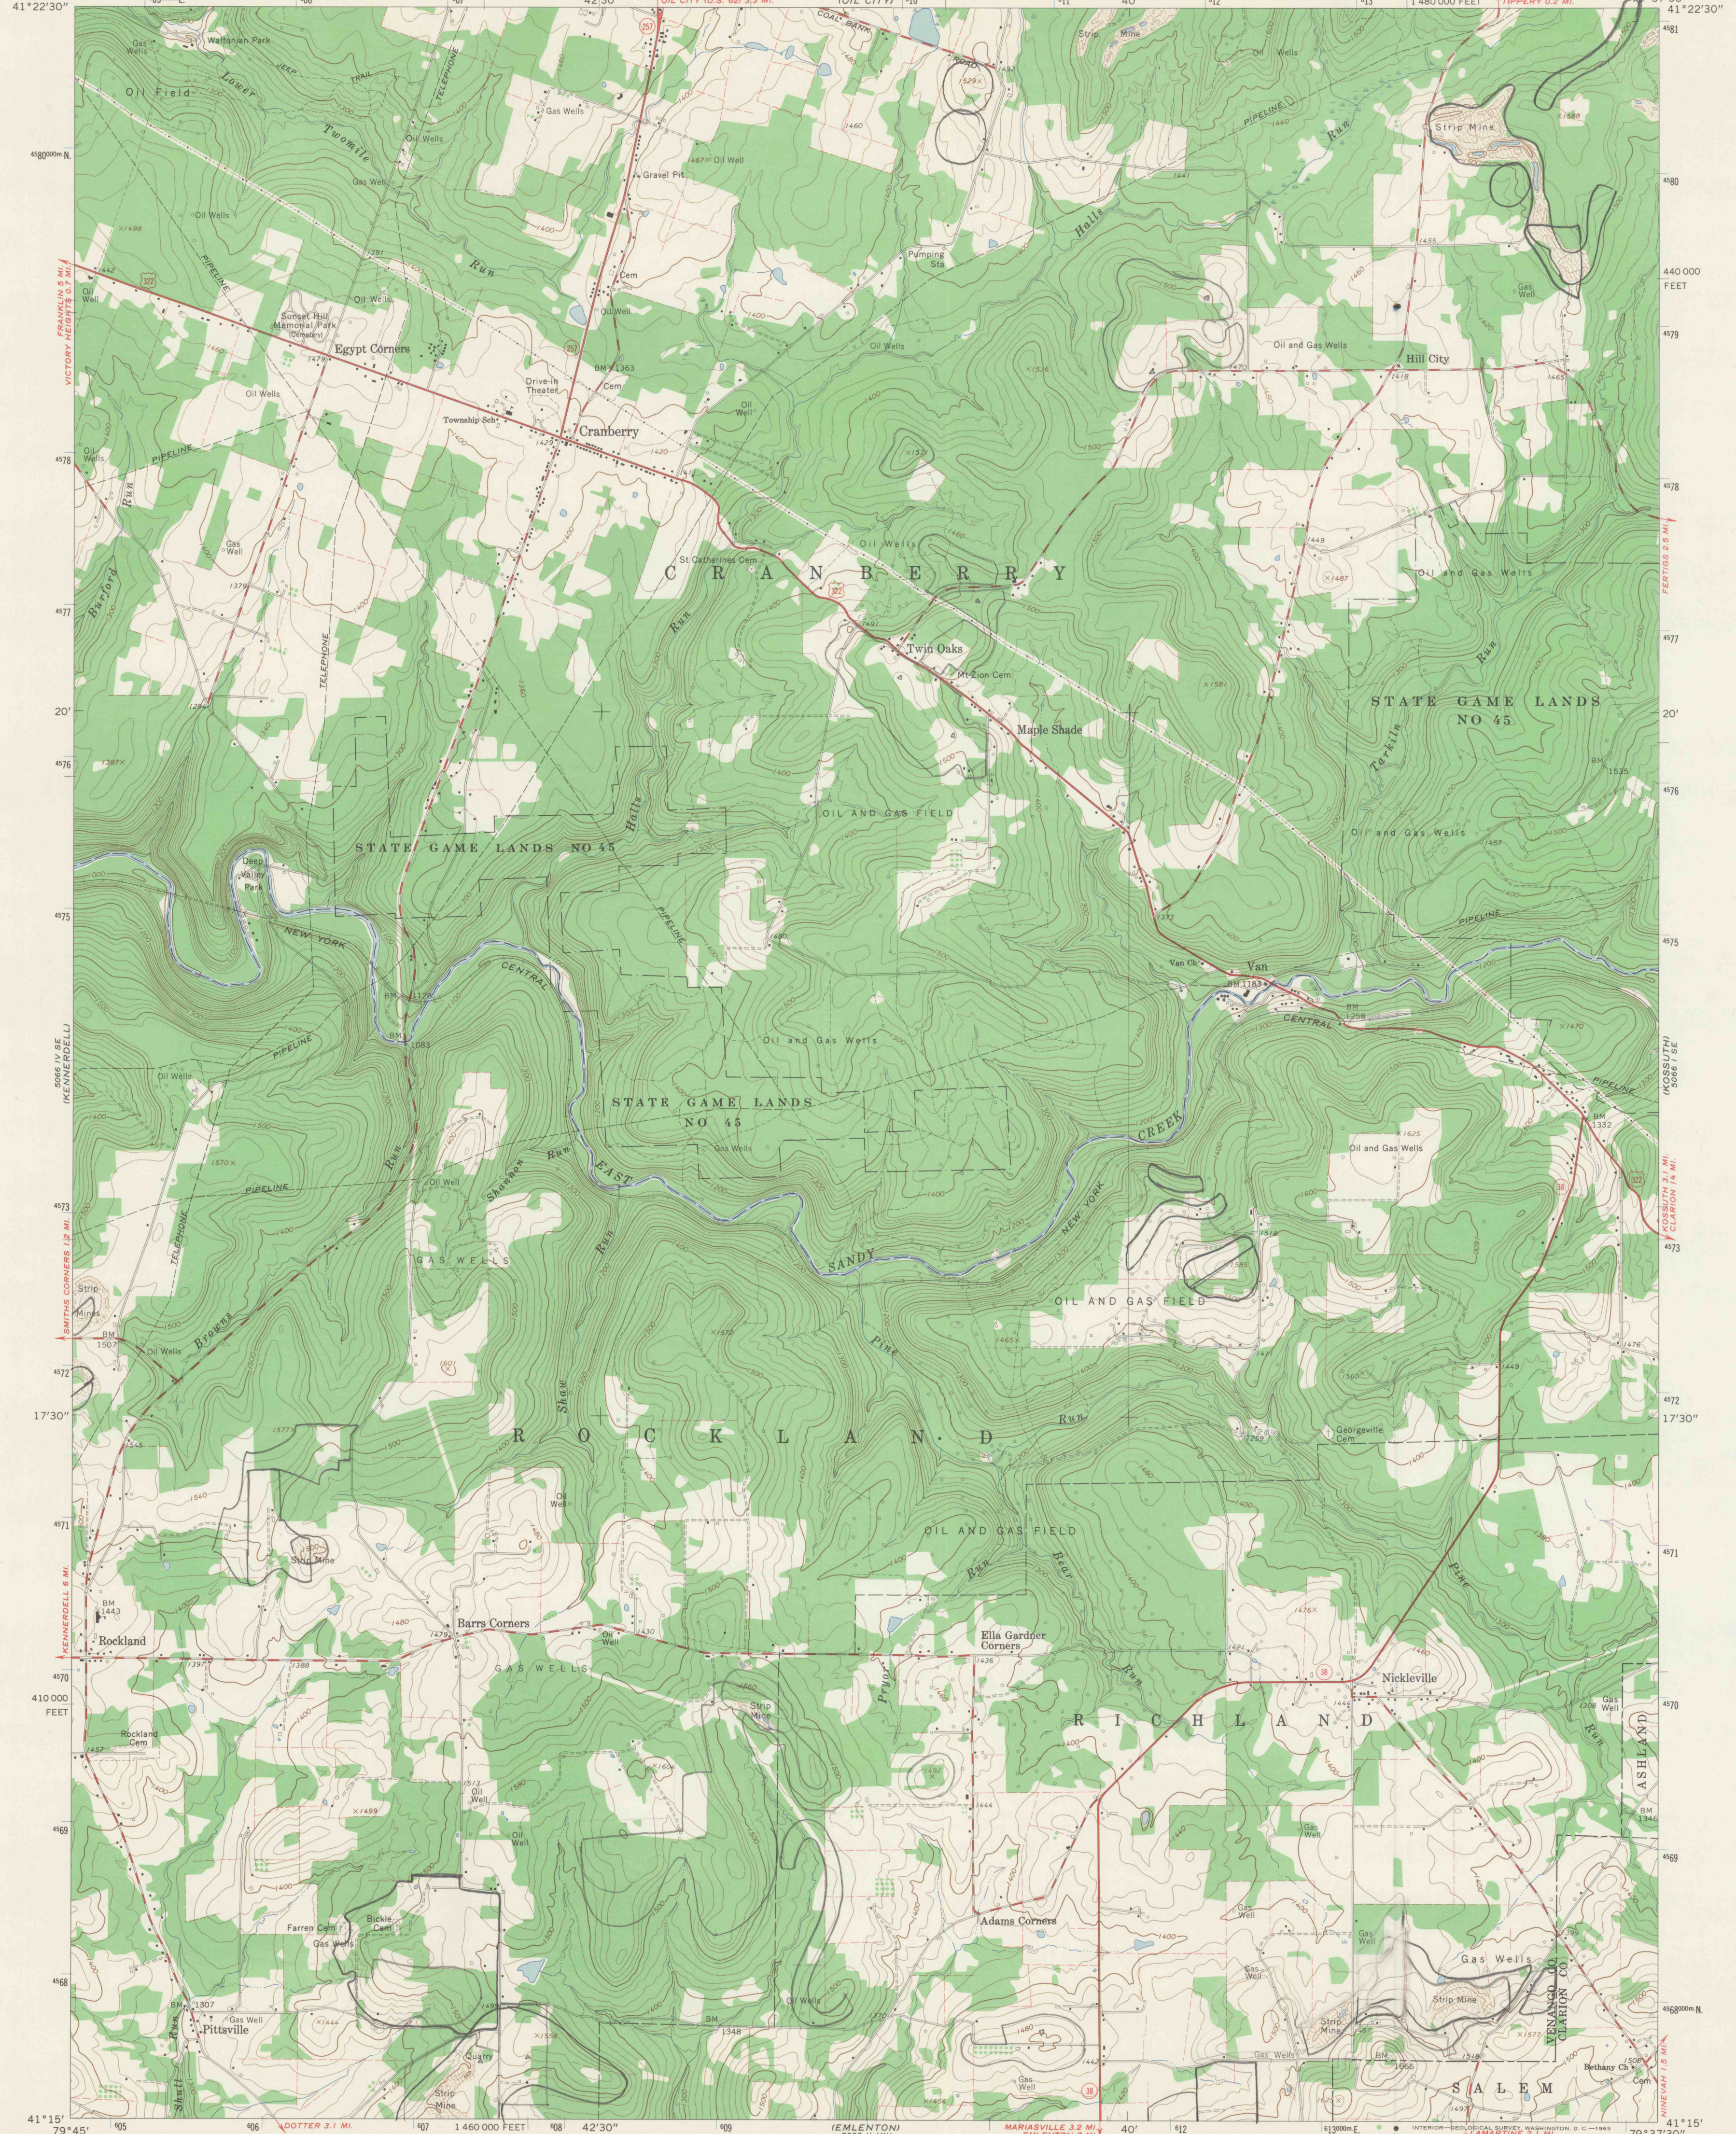

PLAN HOLD

DRAWING NUMBER
3-5.3

0808