



PLAN HOLD





PEEL PROTECTIVE STRIP TO EXPOSE ADHESIVE. POSITION EDGE OF PRINT ON THE LINE AND RUB TO ADHERE.

DRAWING NUMBER
MERCER/4-2.3
PLAN HOLD CORPORATION IRVINE CALIFORNIA
REORDER BY NO. 078A.24

CDAL 103

MERCER/4-2.3
1002

1002

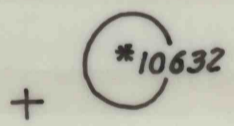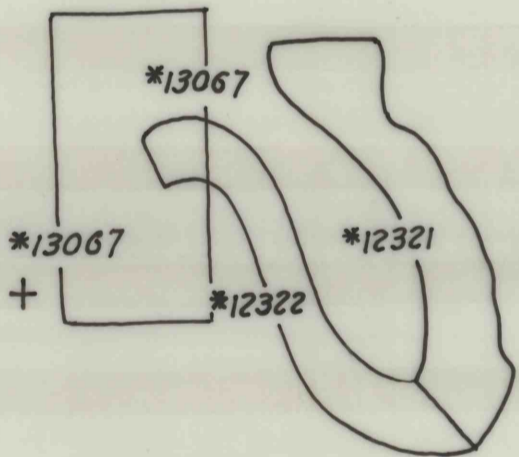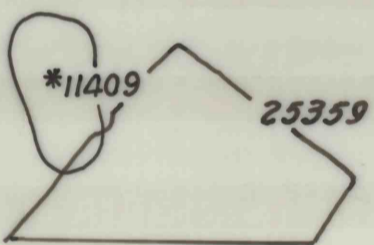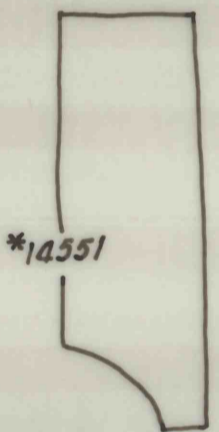

+

+

+

+