

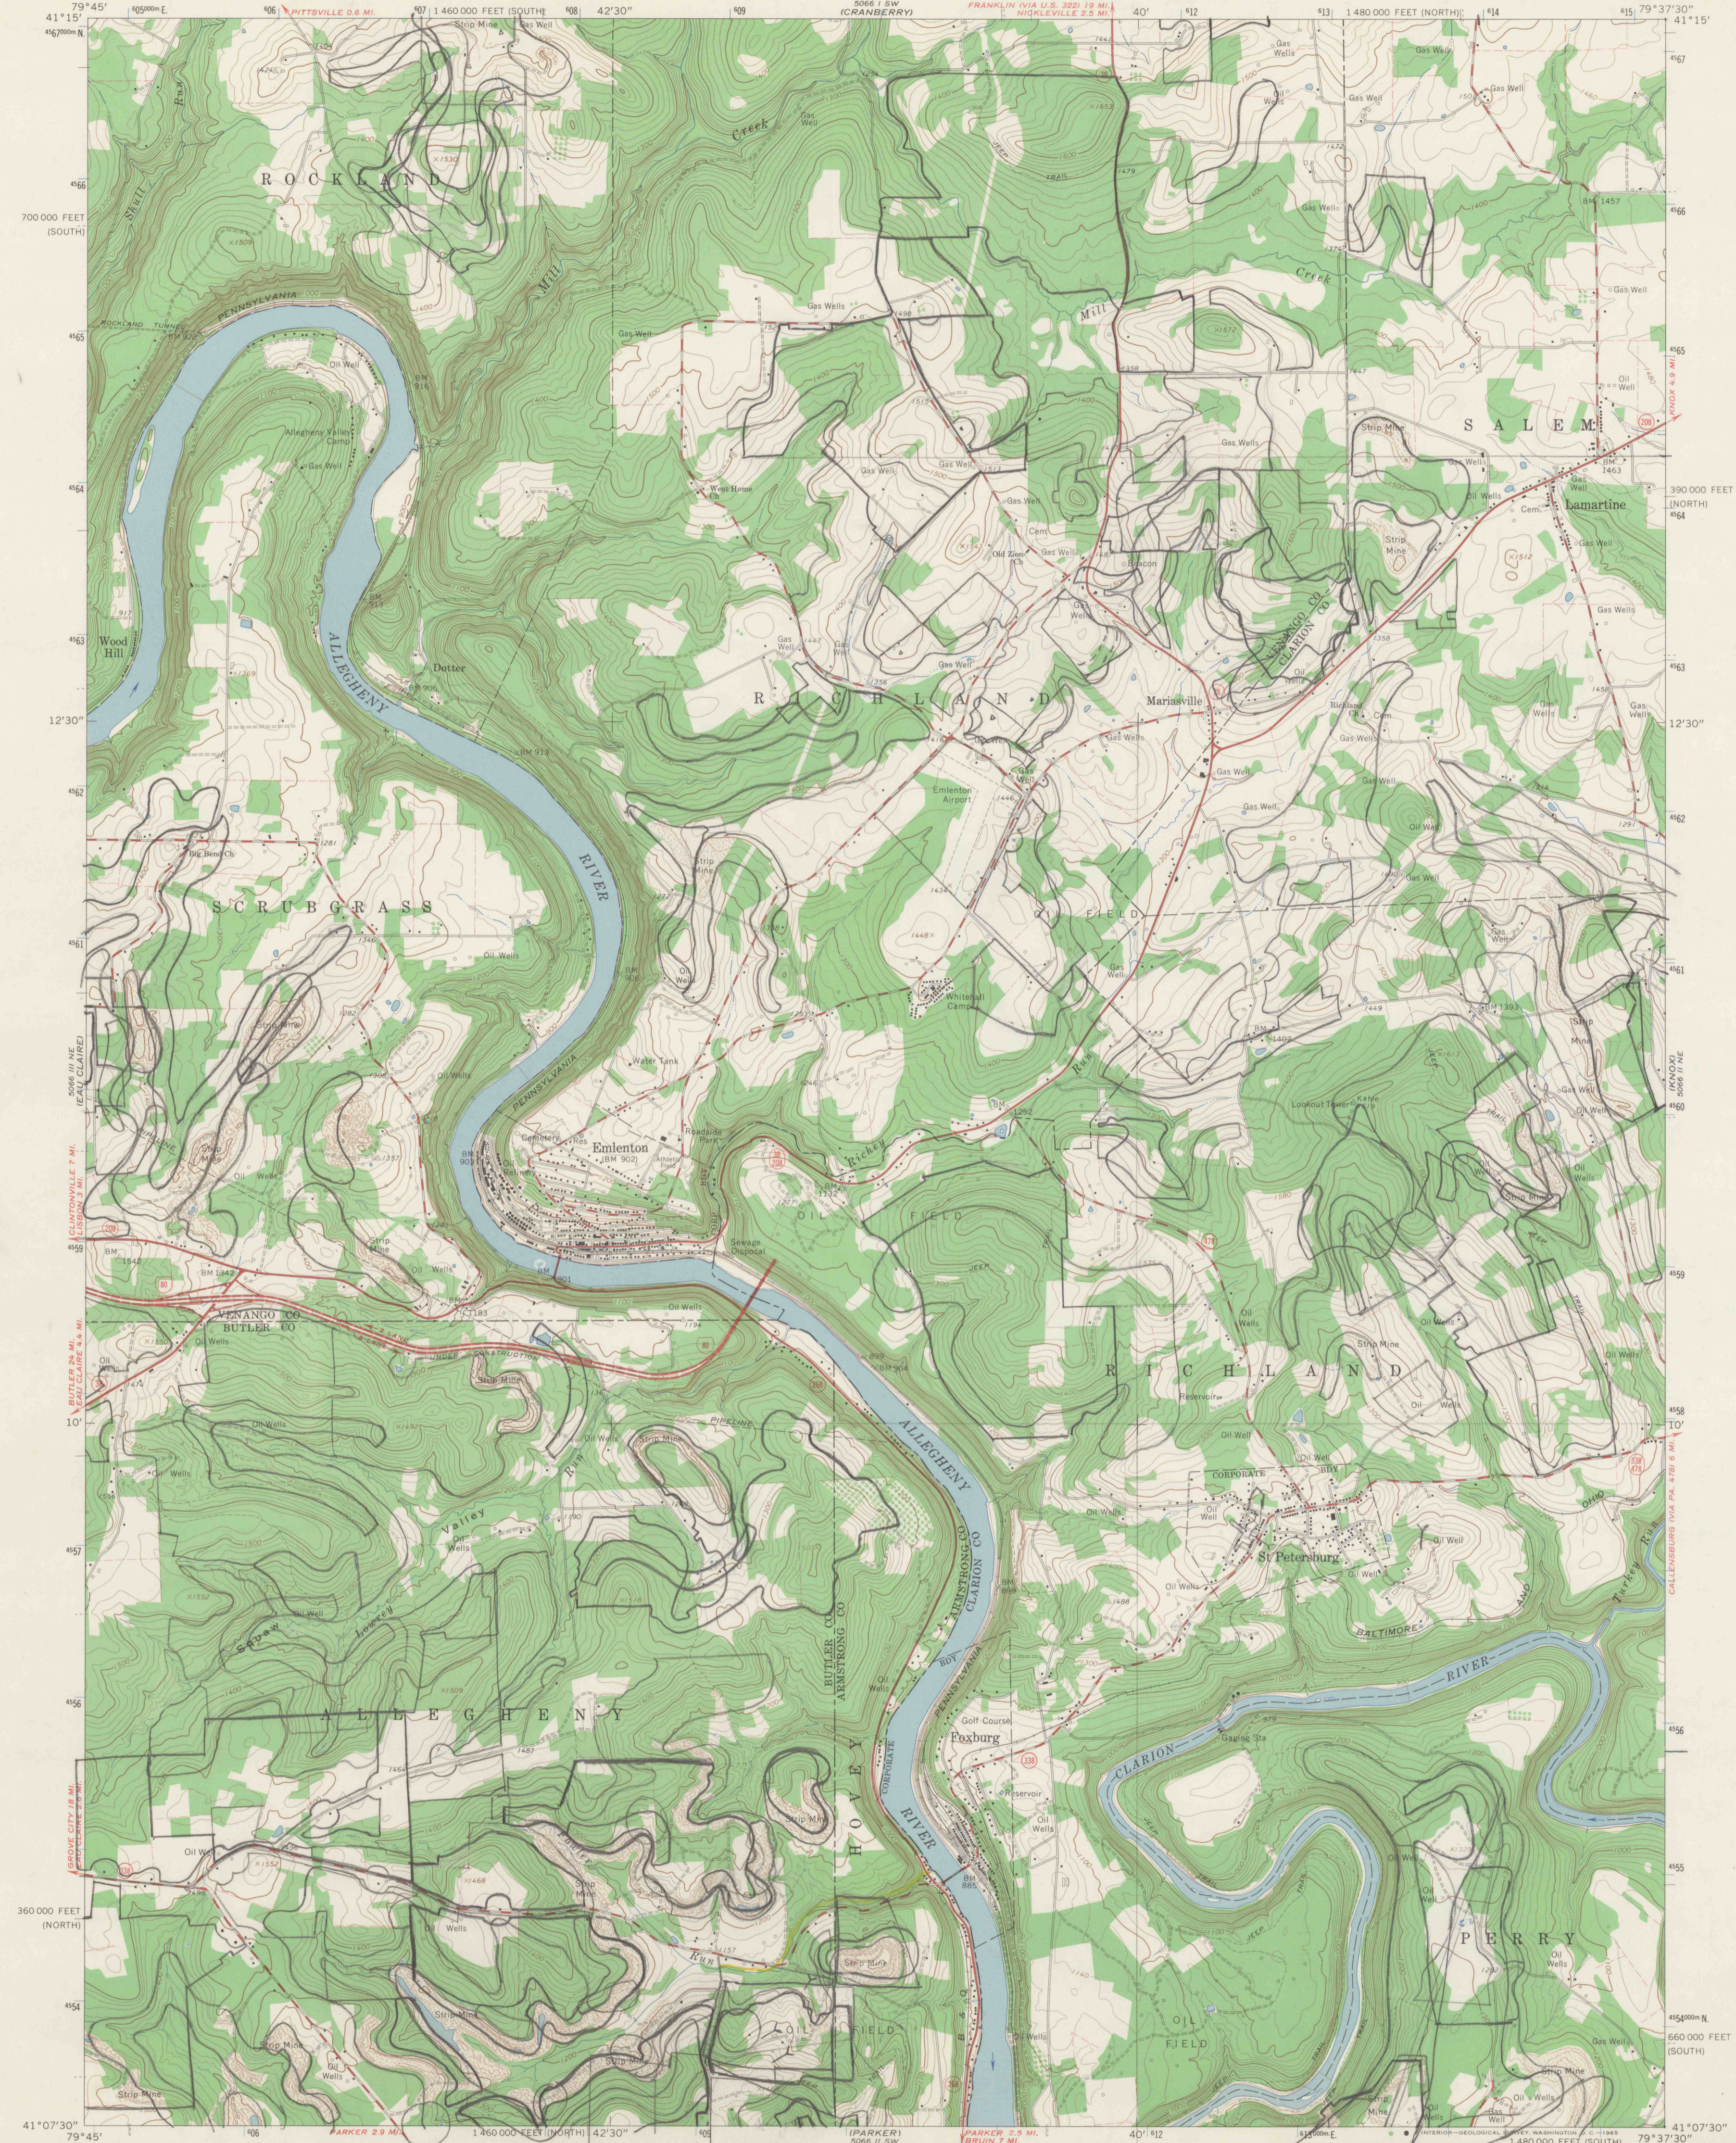
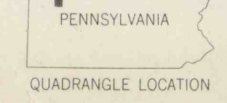
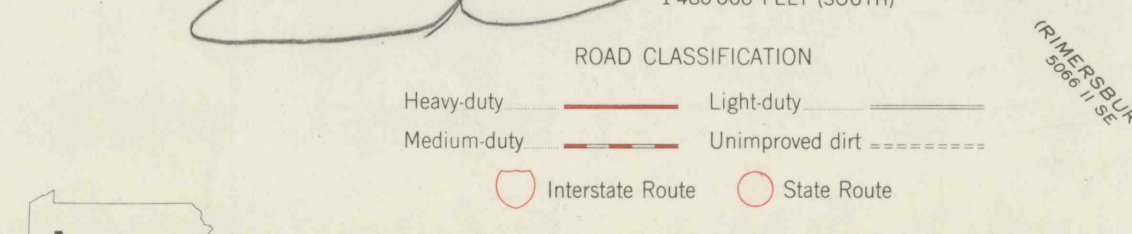


5066 I SW
(CRANBERRY)

5066 I SE
(KOSSTUTZ)

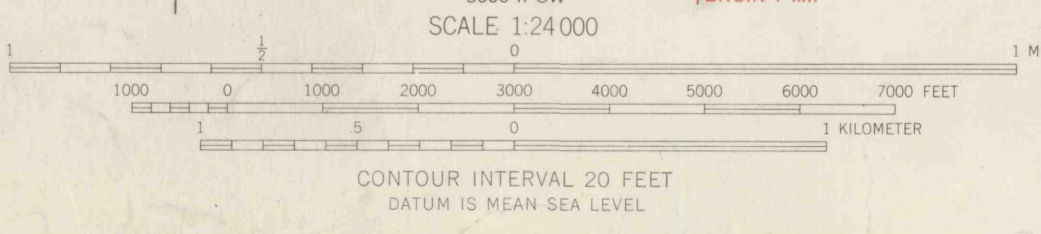

Mapped, edited, and published by the Geological Survey
Control by USGS, USC&GS, and USCE
Topography by photogrammetric methods from aerial
photographs taken 1962. Field checked 1963
Polyconic projection, 1927 North American datum
10,000-foot grids based on Pennsylvania coordinate system,
north and south zones
100-meter Universal Transverse Mercator grid ticks,
zone 17, shown in blue
Fine red dashed lines indicate selected fence and field lines where
generally visible on aerial photographs. This information is unchecked

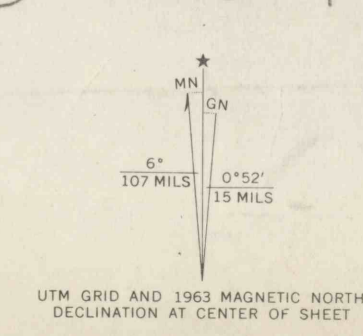

EMLENTON, PA.
NW/4 FOXBURG 15' QUADRANGLE
N4107.5—W7937.5/7.5

1963
AMS 5066 II NW—SERIES V831

PLAN HOLD

PEEL PROTECTIVE STRIP TO EXPOSE ADHESIVE. POSITION EDGE OF PRINT ON THIS LINE AND RUB TO ADHERE.

DRAWING NUMBER
4-5.4

PLAN HOLD CORPORATION • TORRANCE • CALIFORNIA
REORDER BY NO. 0709424

0908

4-5.4