

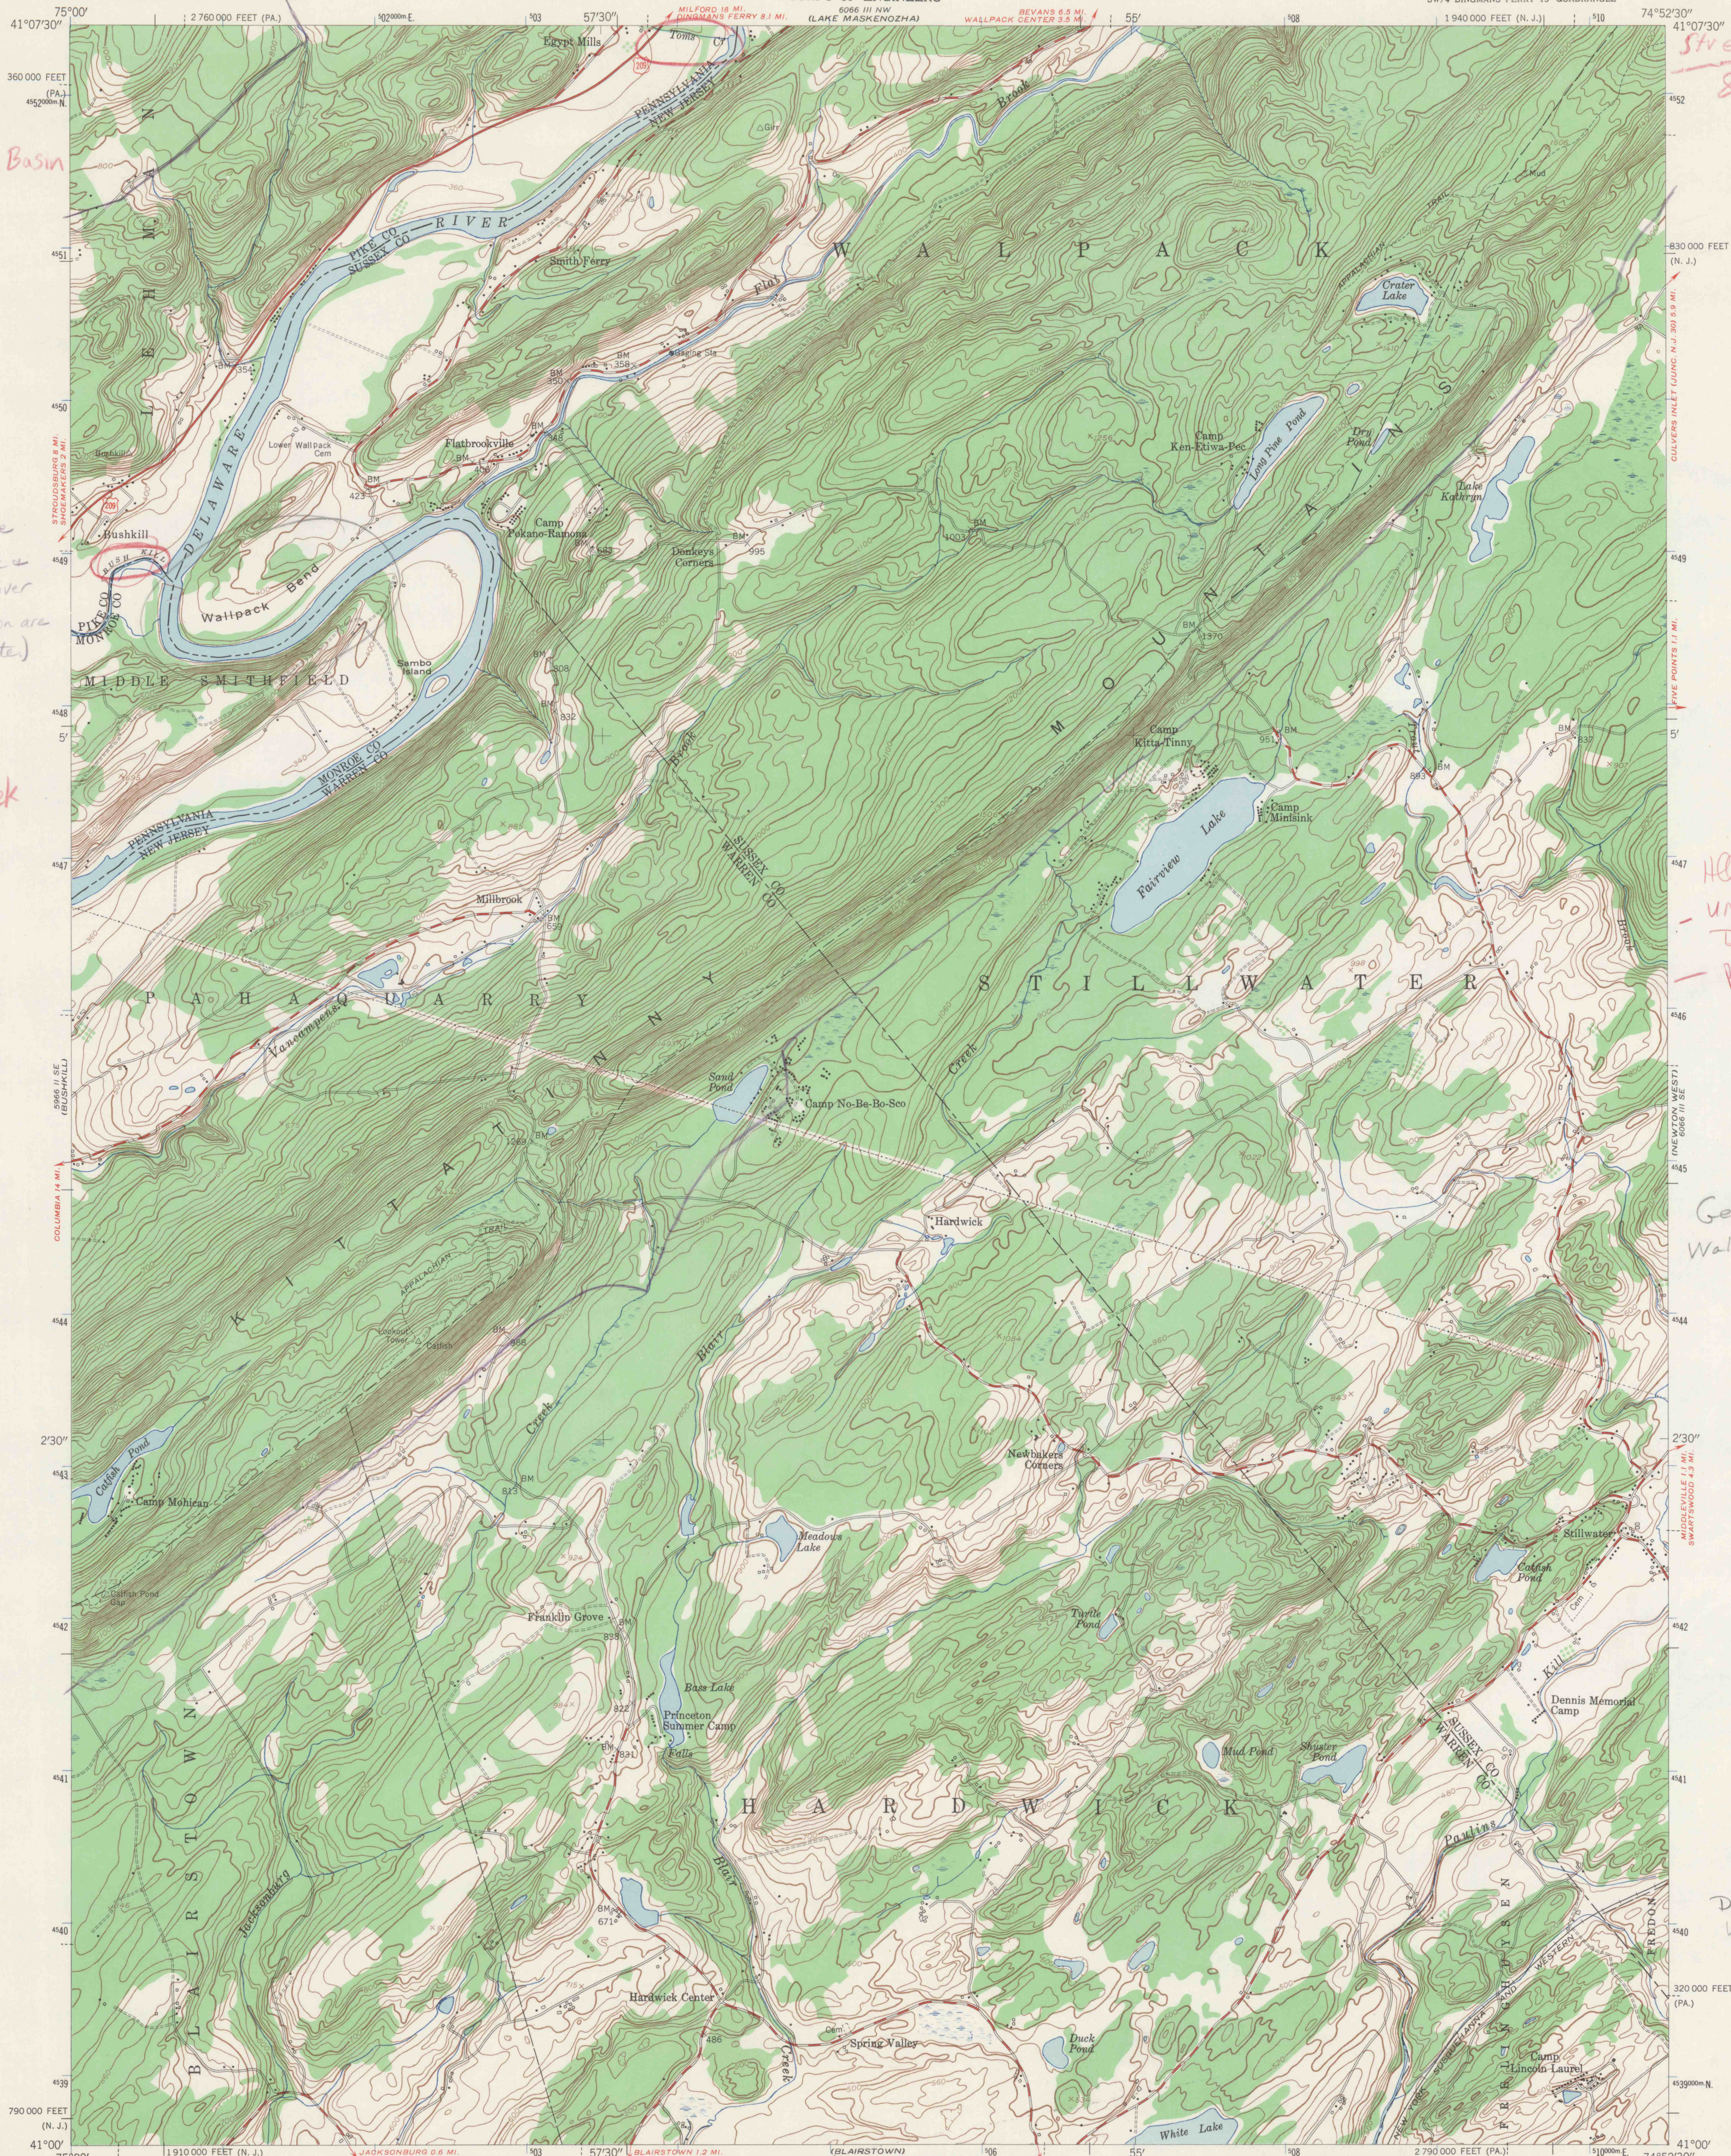


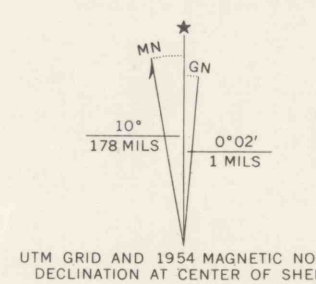

Mapped by the Army Map Service
Edited and published by the Geological Survey
Control by USC&GS and New Jersey Geodetic Survey
Topography from aerial photographs by stereophotogrammetric methods. Aerial photographs taken 1942.
Culture revised by the Geological Survey 1954
Polyconic projection. 1927 North American datum
10,000-foot grids based on New Jersey coordinate system,
and Pennsylvania coordinate system, north zone
1000-meter Universal Transverse Mercator grid ticks,
zone 18, shown in blue
Unchecked elevations are shown in brown

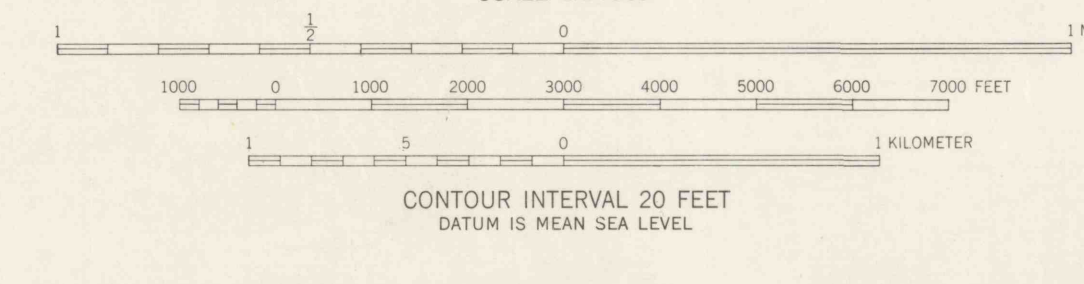

ROAD CLASSIFICATION	
Heavy-duty	Light-duty
Medium-duty	Unimproved dirt
	U.S. Route

FLATBROOKVILLE, N. J.-PA.
SW/4 DINGMANS FERRY 15' QUADRANGLE
N4100-W7452.5/7.5

1954
AMS 6066 III SW-SERIES V822

Streams Update
8/21/97

HO streams
- UNITS to
Delaware R
- Bushkill

Geol. Feat.
Wallpack Bend
(Sec 1)

Delaware
Water Gap
NRA

DRAWING NUMBER

DRAWING NUMBER

SAM
4-24.3
DRAWING NUMBER

4-24.3