



PLAN HOLD


PEEL PROTECTIVE STRIP TO EXPOSE ADHESIVE. POSITION EDGE OF PRINT ON THIS LINE AND RUB TO ADHERE.

PLAN HOLD CORPORATION IRVINE, CALIFORNIA
REORDER BY NO. 0703424

DRAWING NUMBER
WS/4-20.3

1038

WS/4-20.3
1038

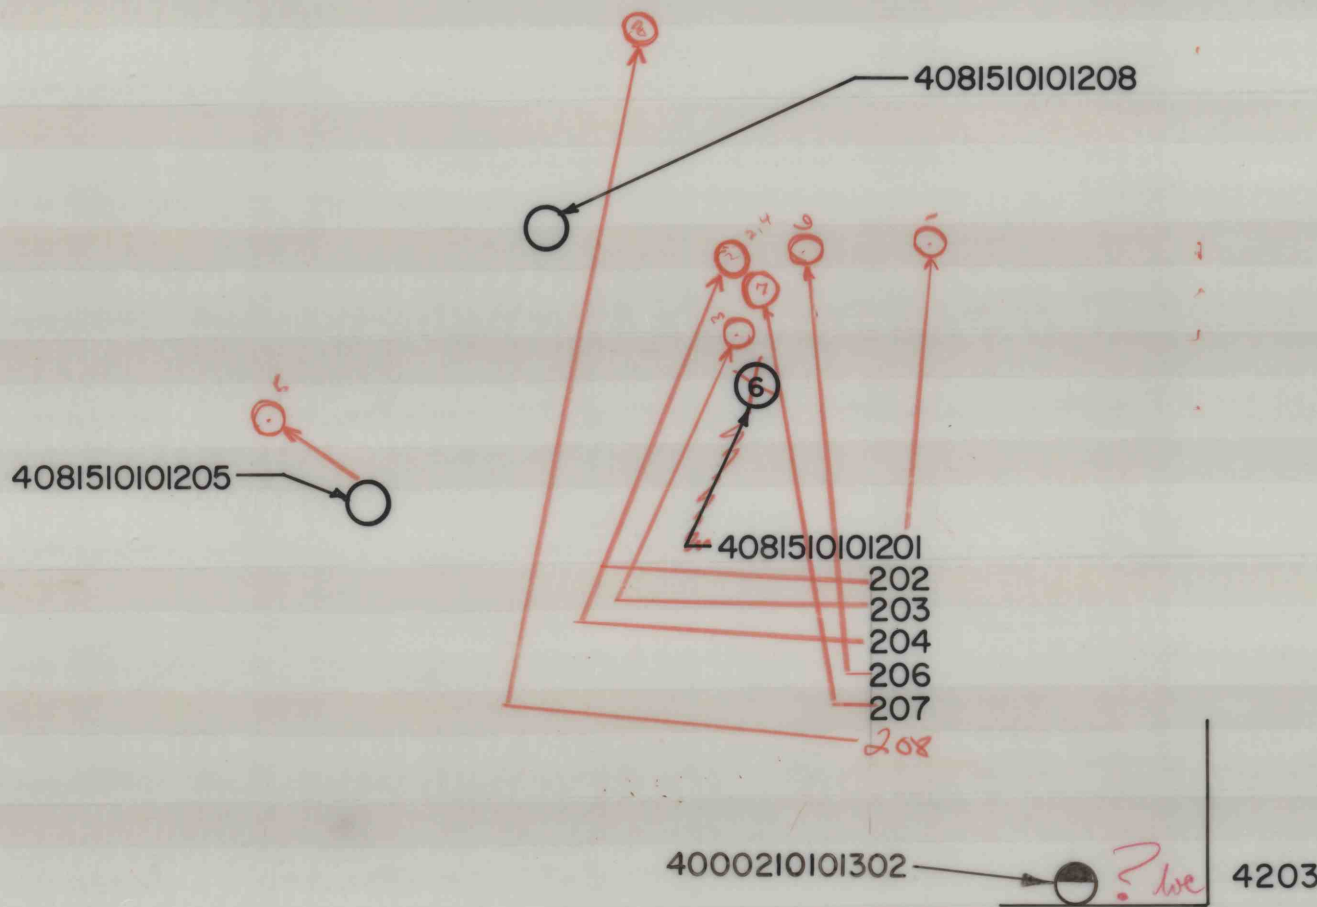

FREE-LAND