
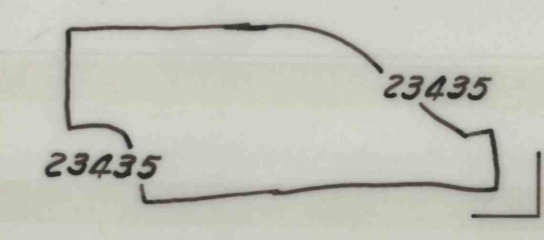


CoAL 107

B/14-11.3 (Sheet 2 of 2)
1020

22528 & 23554

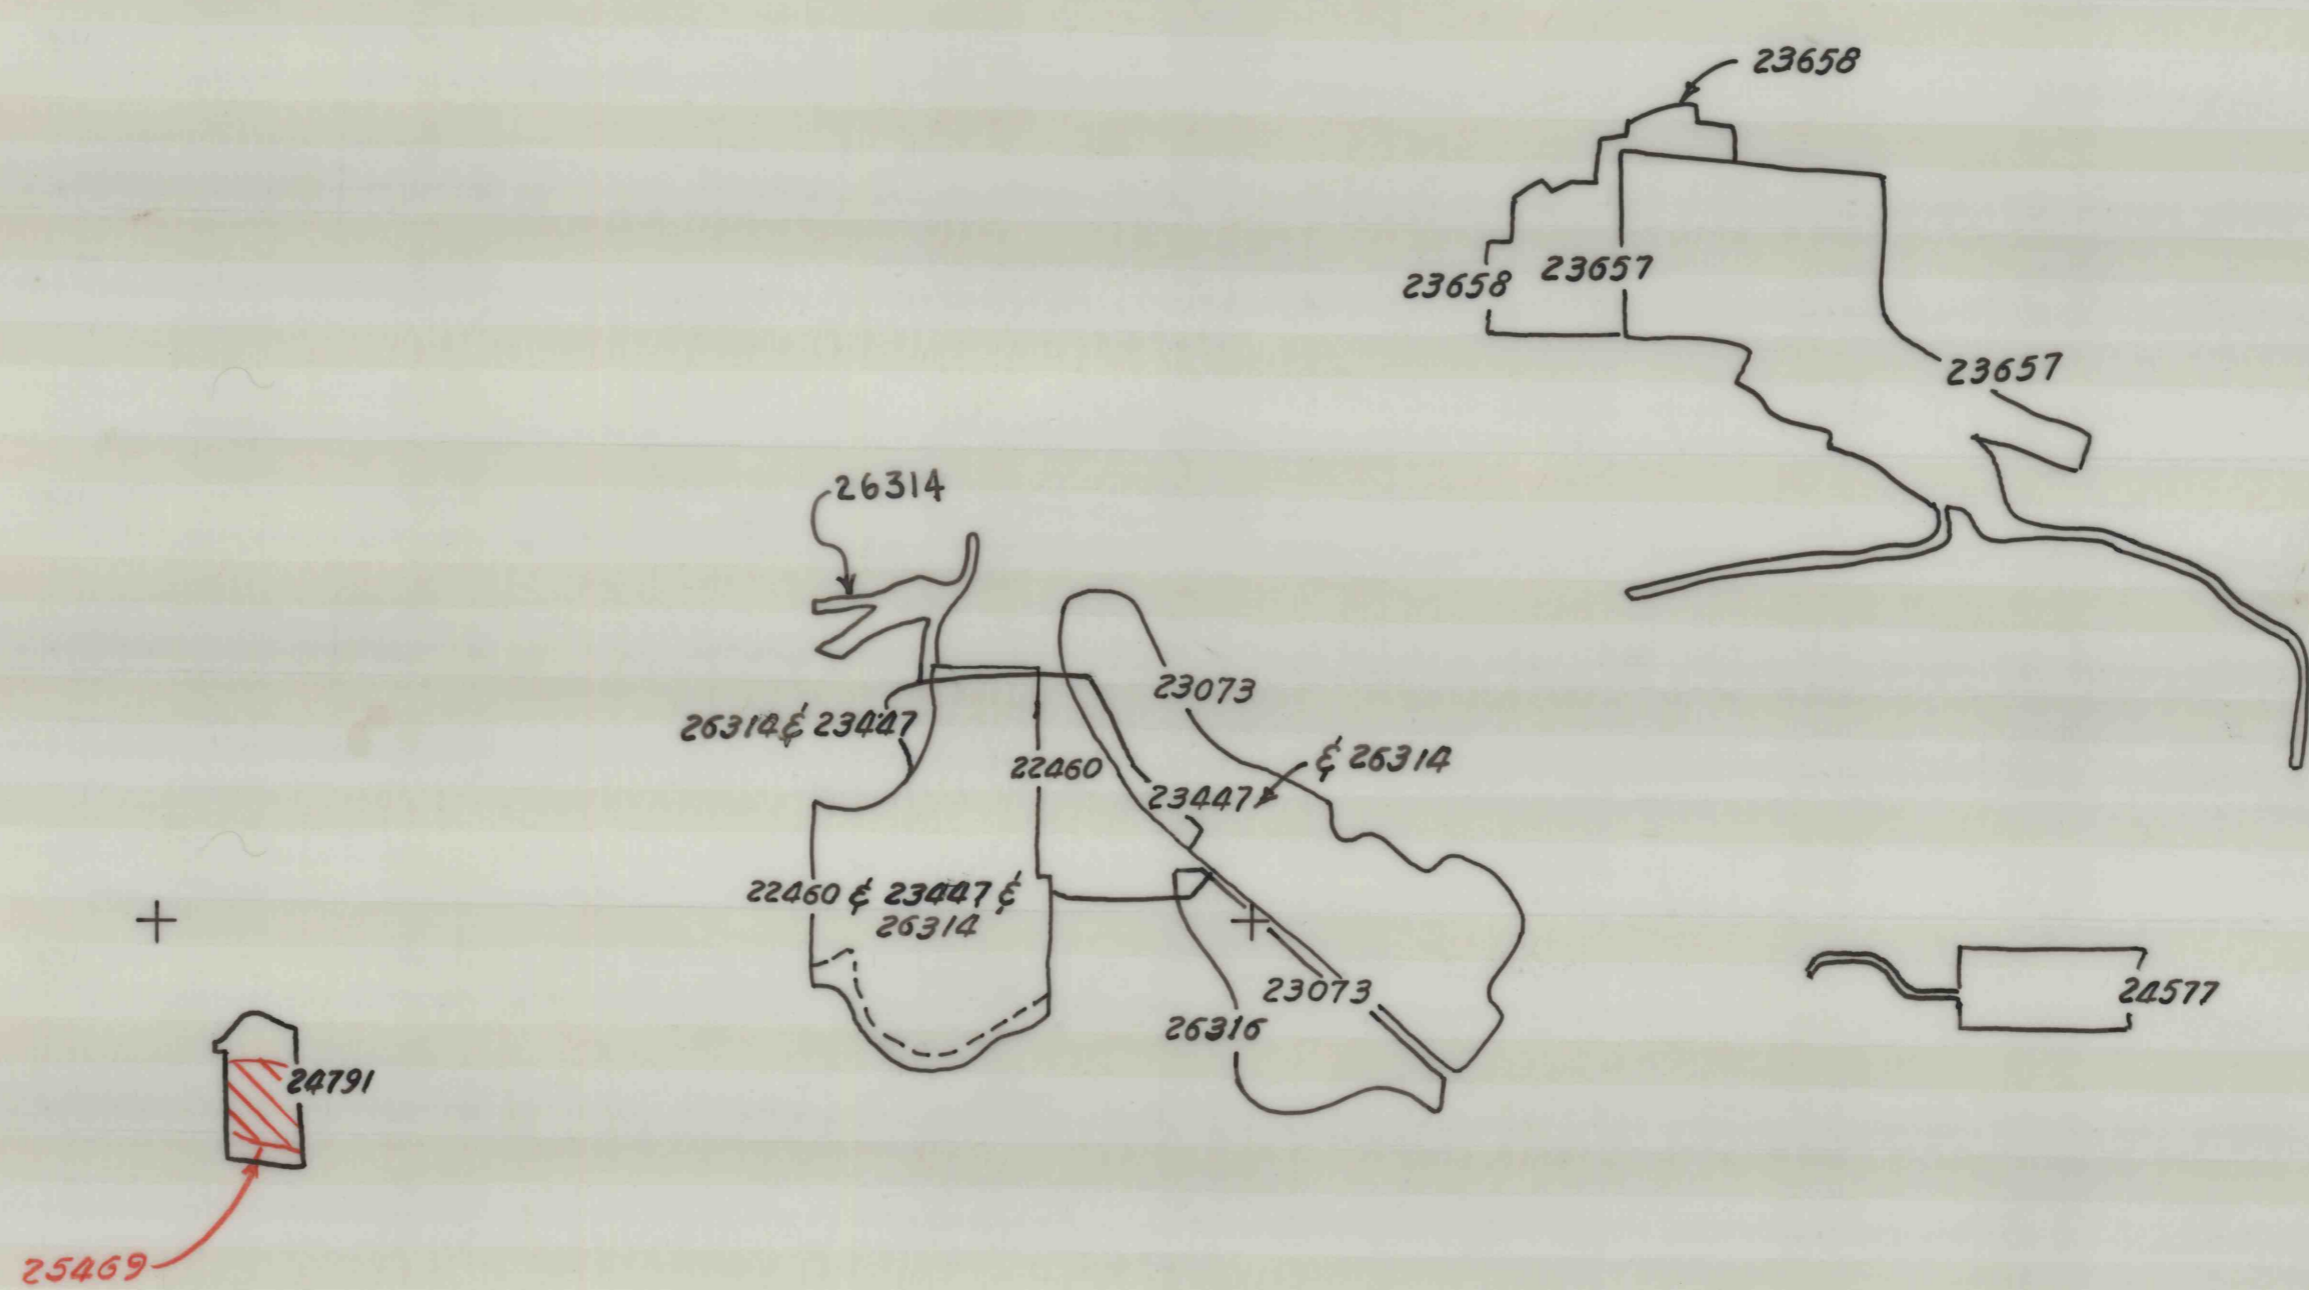

+

+