DRAWING NUMBER
PLAN HOLD CORPORATION • IRVINE, CALIFORNIA
REORDER BY NUMBER 07549

C'/4-11.3

1020

COAL 109
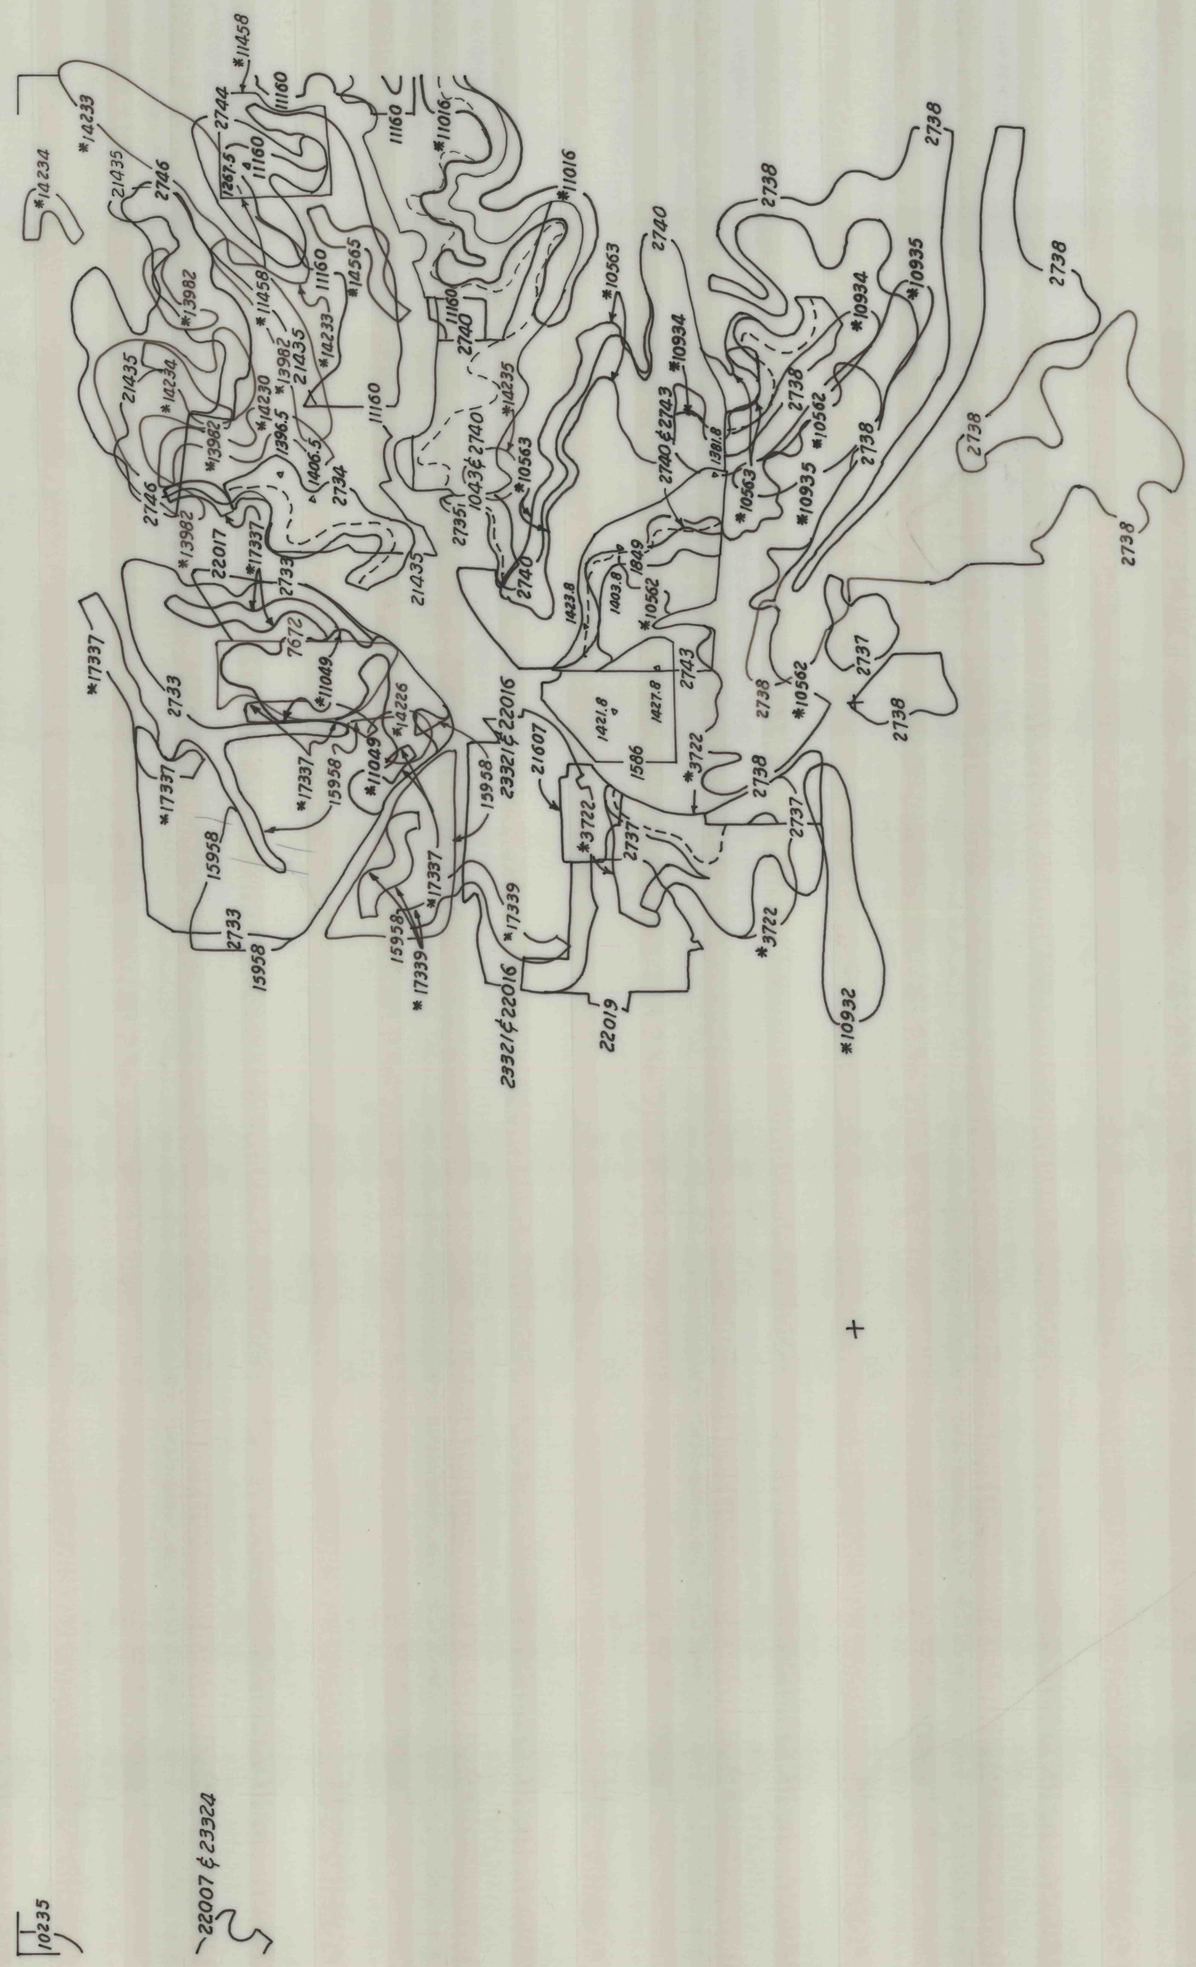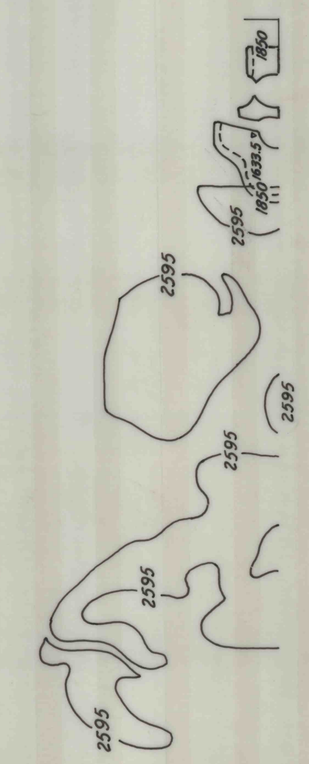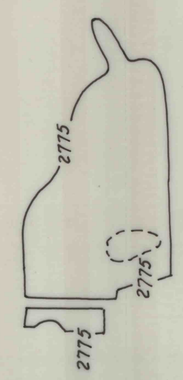
C'/4-11.3 (Sheet 1 of 2)
1020