




PLAN HOLD

PEEL PROTECTIVE STRIP TO EXPOSE ADHESIVE. POSITION EDGE OF PRINT ON THIS LINE AND RUB TO ADHERE.


PLAN HOLD CORPORATION - TORRANCE - CALIFORNIA
REORDER BY NO. 078A24

DRAWING NUMBER
C/4-3.3

1004 2

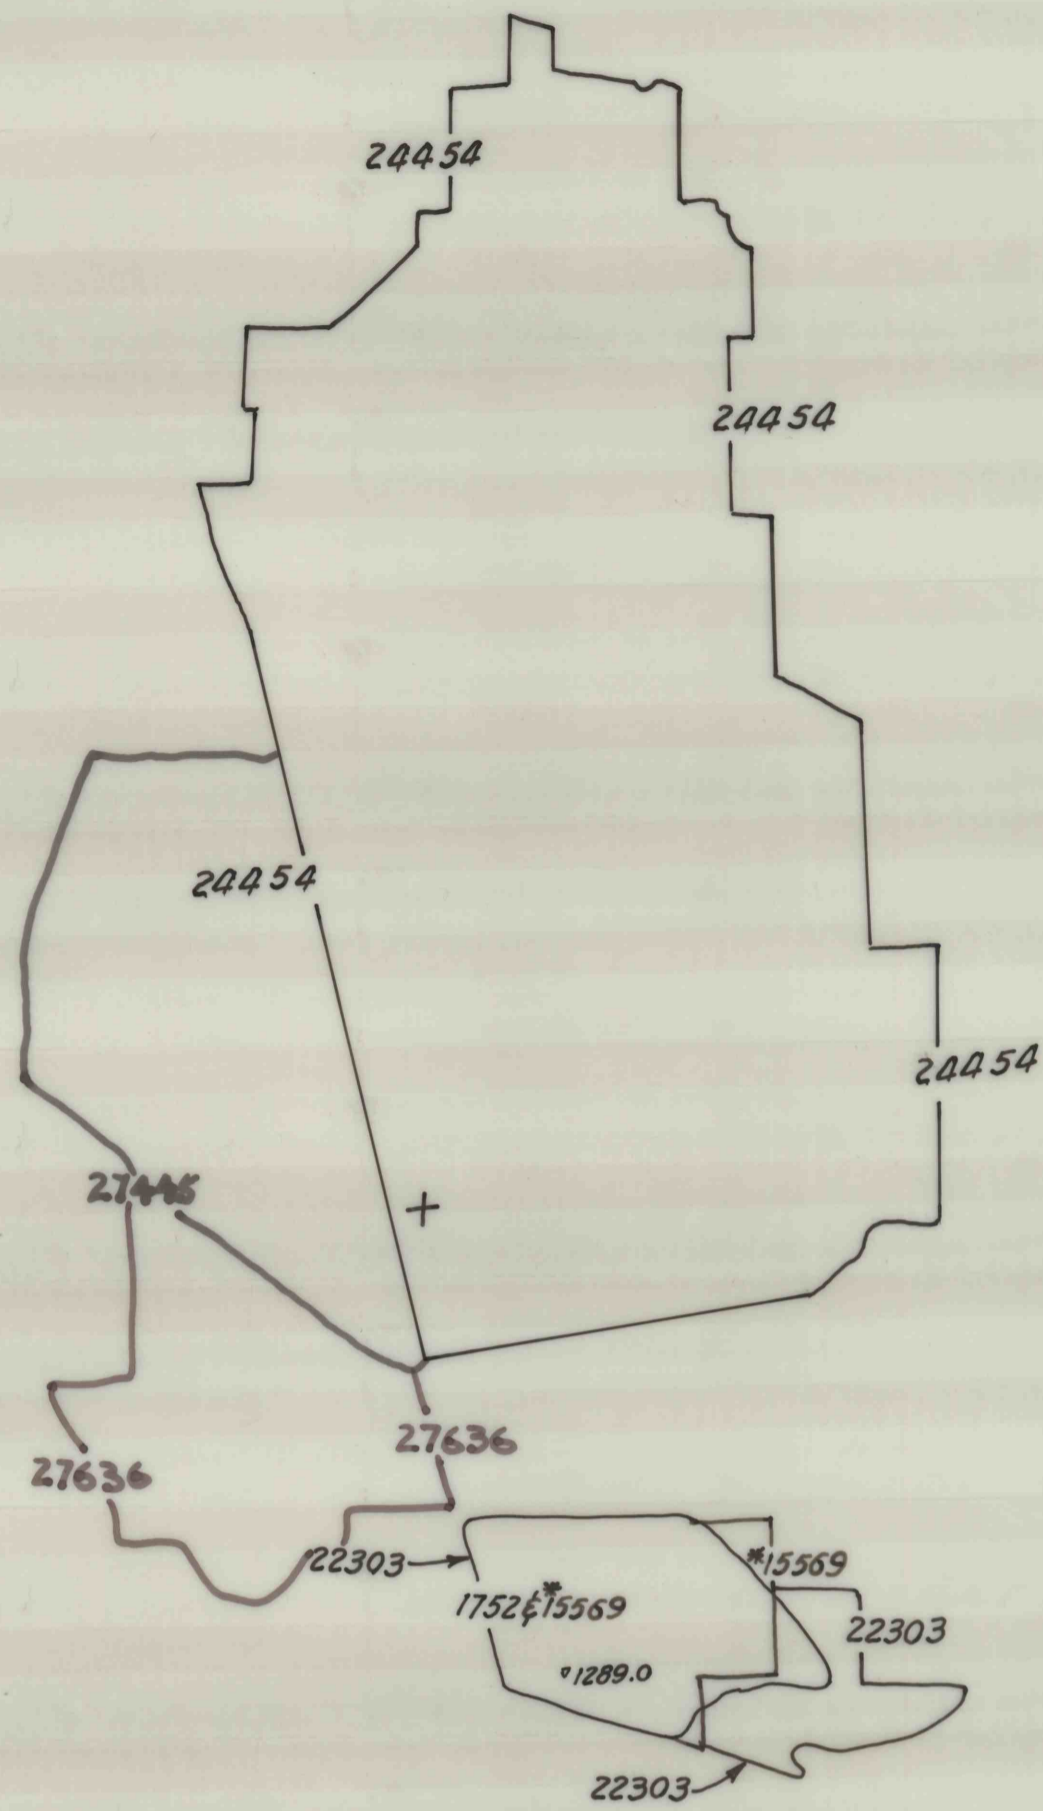

*13094

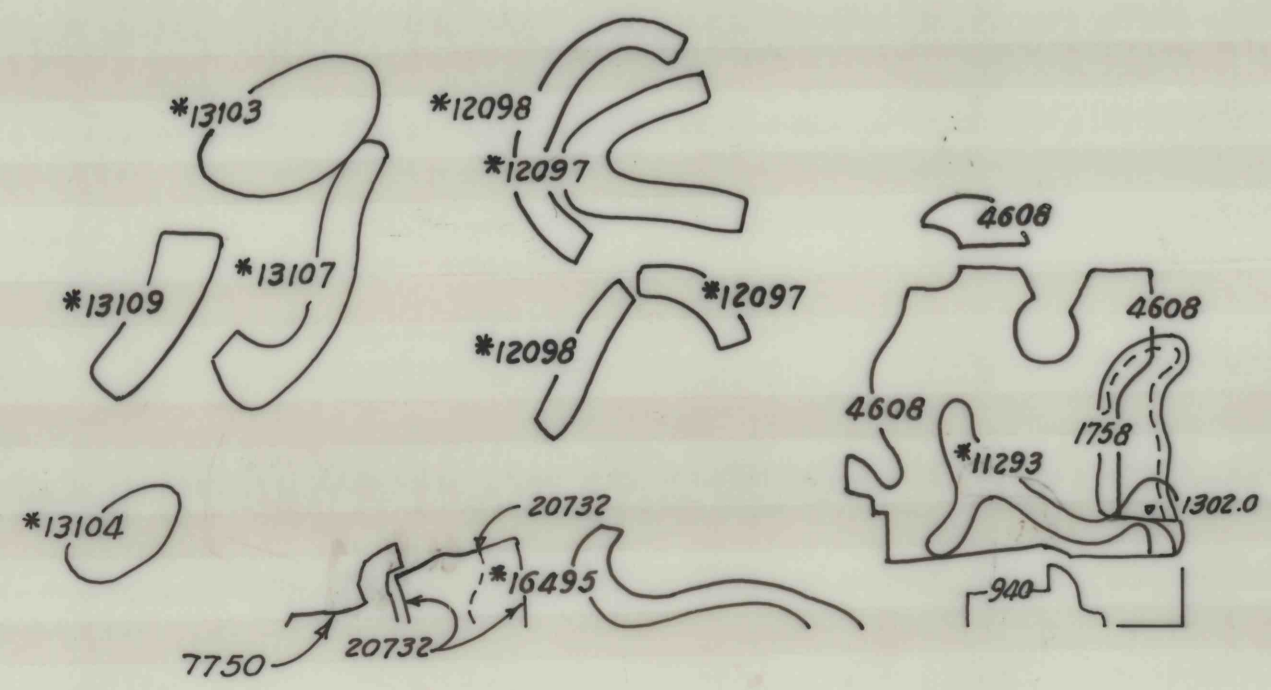

C/4-3.3
1004

COAL108