

*Stream Update
8/21/97*

*HQ-CWF
Tinkwing Creek
Swamp Brook*

*Wallenpaupack Creek B
HQ-WWF From
Lake W. Dam to mouth
HQ-CWF: source to Dam*


*SG.L.
#183*

*STATE
FOREST*




DRAWING NUMBER

DRAWING NUMBER

SAM 3-23.4
DRAWING NUMBER

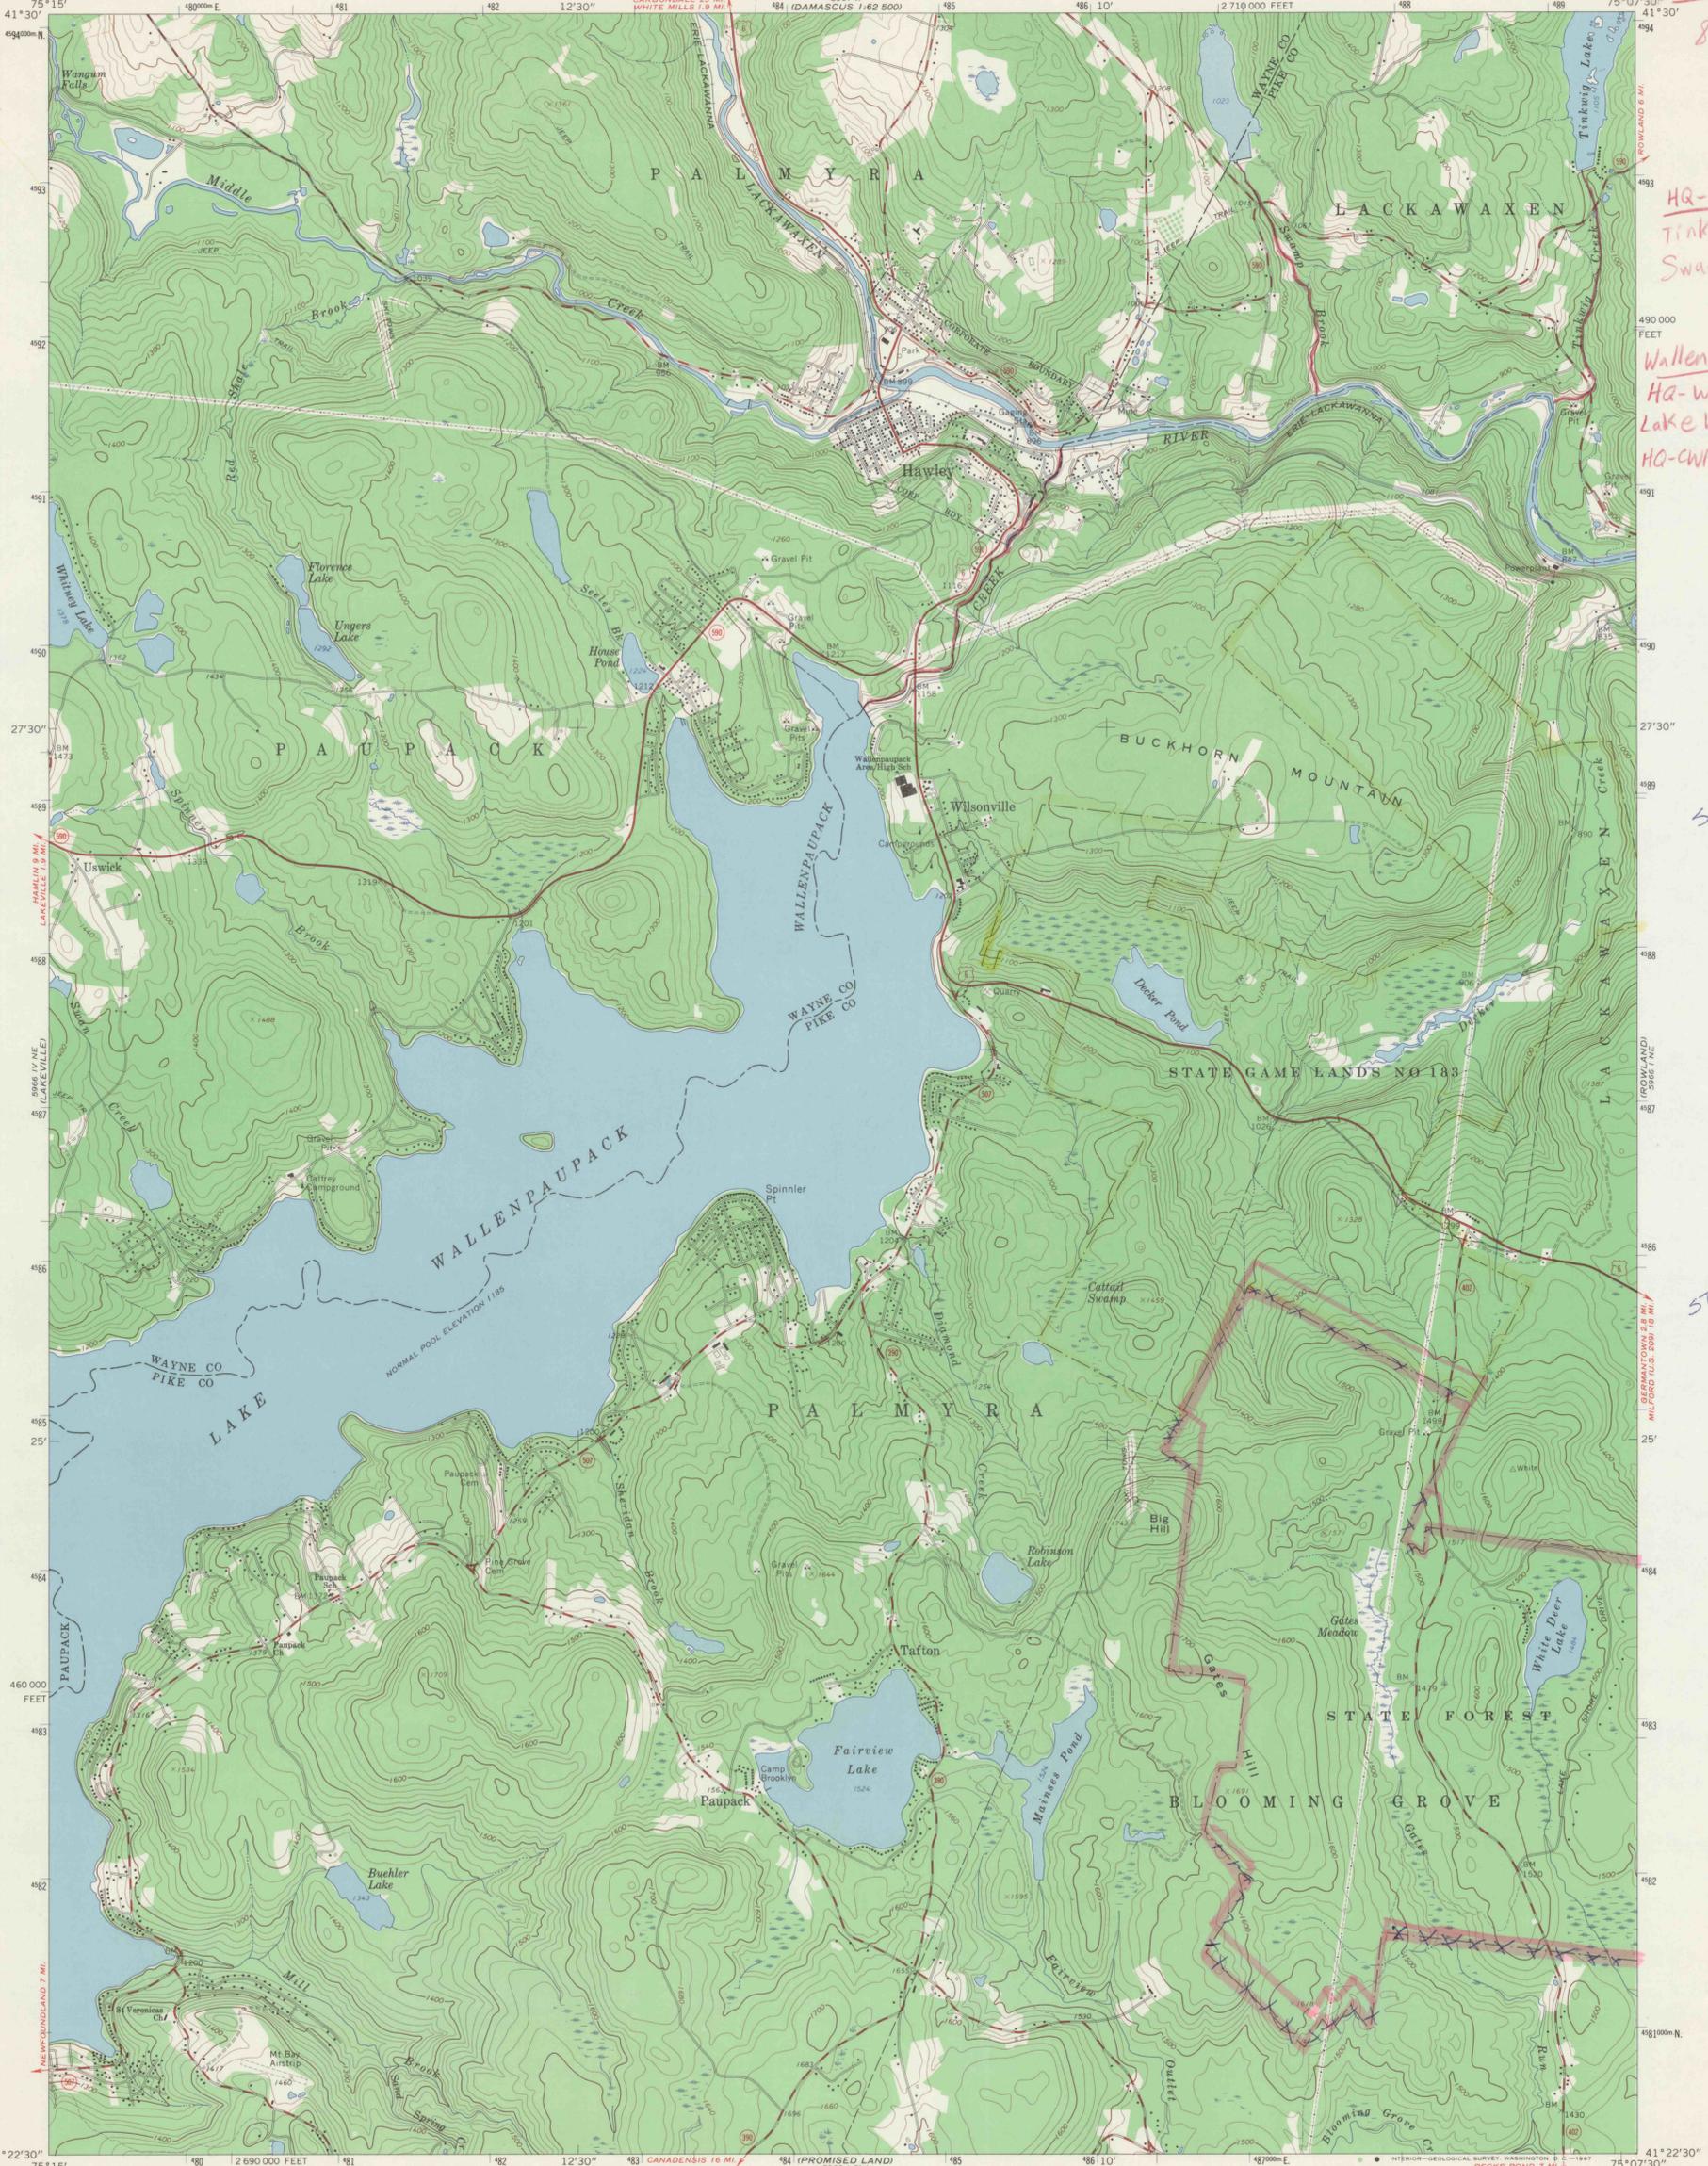

Mapped, edited, and published by the Geological Survey
Control by USGS and USC&GS
Topography by photogrammetric methods from aerial photographs
taken 1963. Field checked 1966
Polyconic projection. 1927 North American datum
10,000-foot grid based on Pennsylvania coordinate system, north zone
1000-meter Universal Transverse Mercator grid ticks, zone 18,
shown in blue
Fine red dashed lines indicate selected fence and field lines where
generally visible on aerial photographs. This information is unchecked

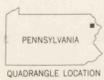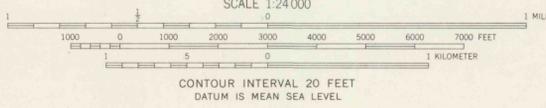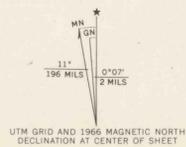

ROAD CLASSIFICATION

Heavy-duty	Light-duty
Medium-duty	Unimproved dirt
U.S. Route	State Route

HAWLEY, PA.
NW/4 HAWLEY 15' QUADRANGLE
N4122.5-W7507.5/7.5

3-23.4