



PLAN HOLD

PEEL PROTECTIVE STRIP TO EXPOSE ADHESIVE. POSITION EDGE OF PRINT ON THIS LINE AND RUB TO ADHERE.

PLAN HOLD CORPORATION IRVINE CALIFORNIA
REORDER BY NO. 07084-24


DRAWING NUMBER
C/4-8.4

0914

CDAL108




C/4-8.4 (Sheet 2 of 2)
0914

23191








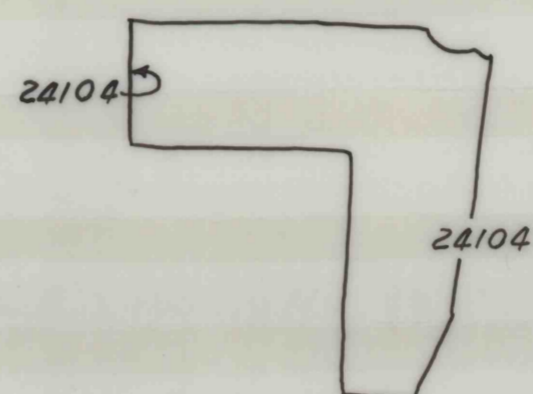


+

+

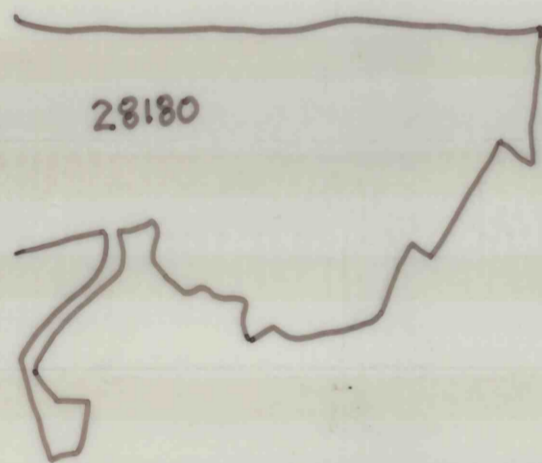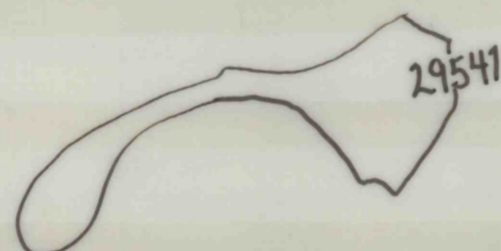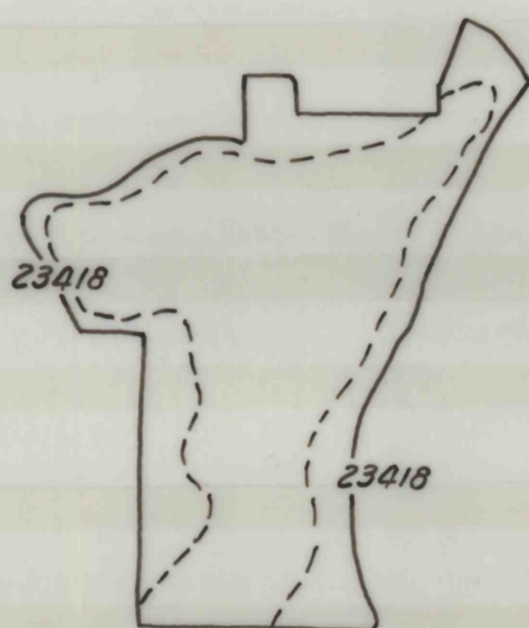

+

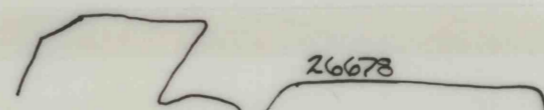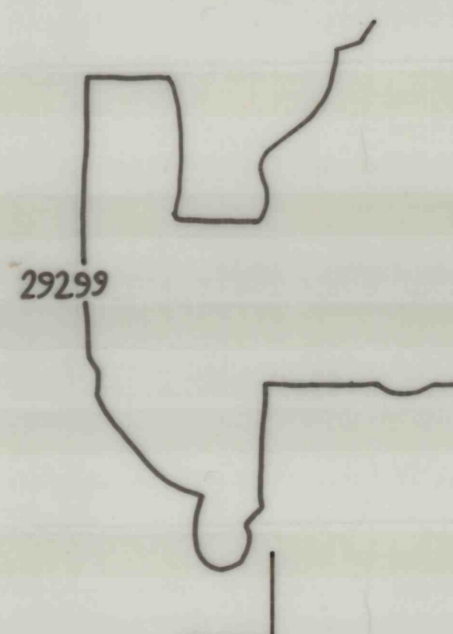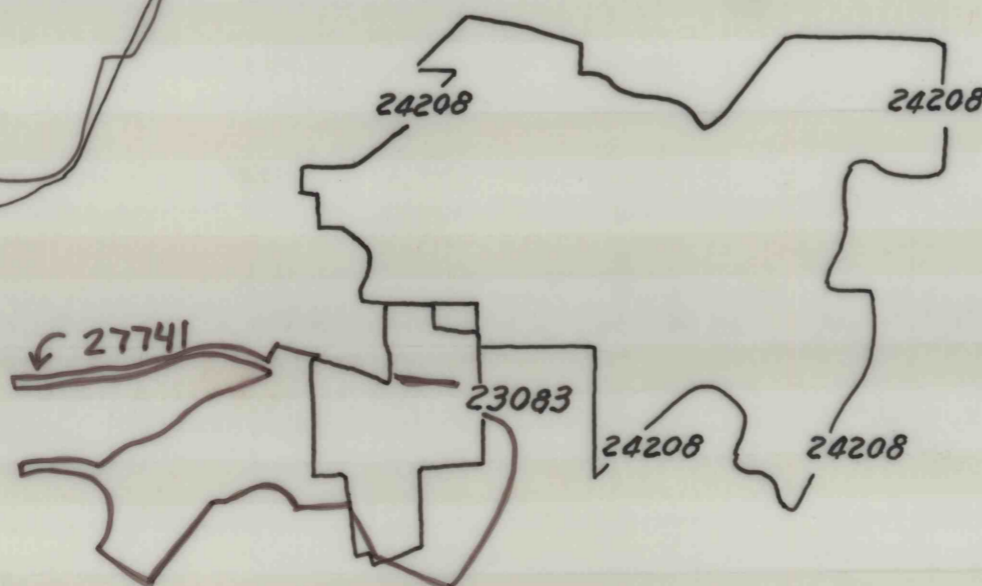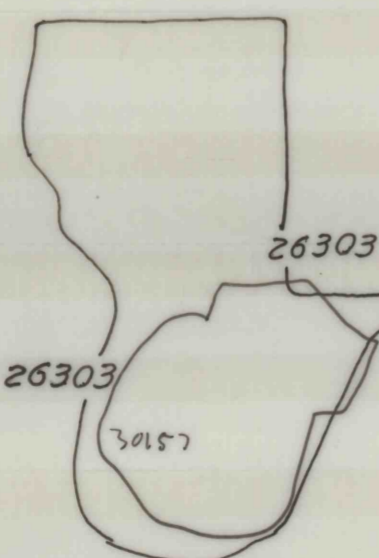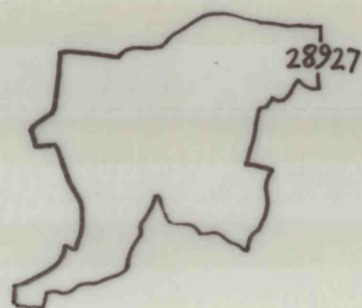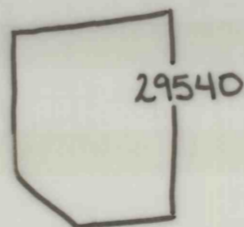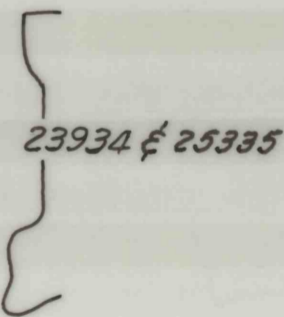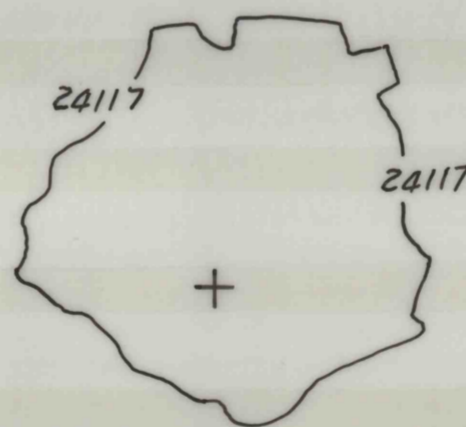

24492