



UNITED STATES
DEPARTMENT OF THE INTERIOR
GEOLOGICAL SURVEY


HILLIARDS QUADRANGLE
PENNSYLVANIA—BUTLER CO.
7.5 MINUTE SERIES (TOPOGRAPHIC)
SE/4 HILLIARDS 15' QUADRANGLE

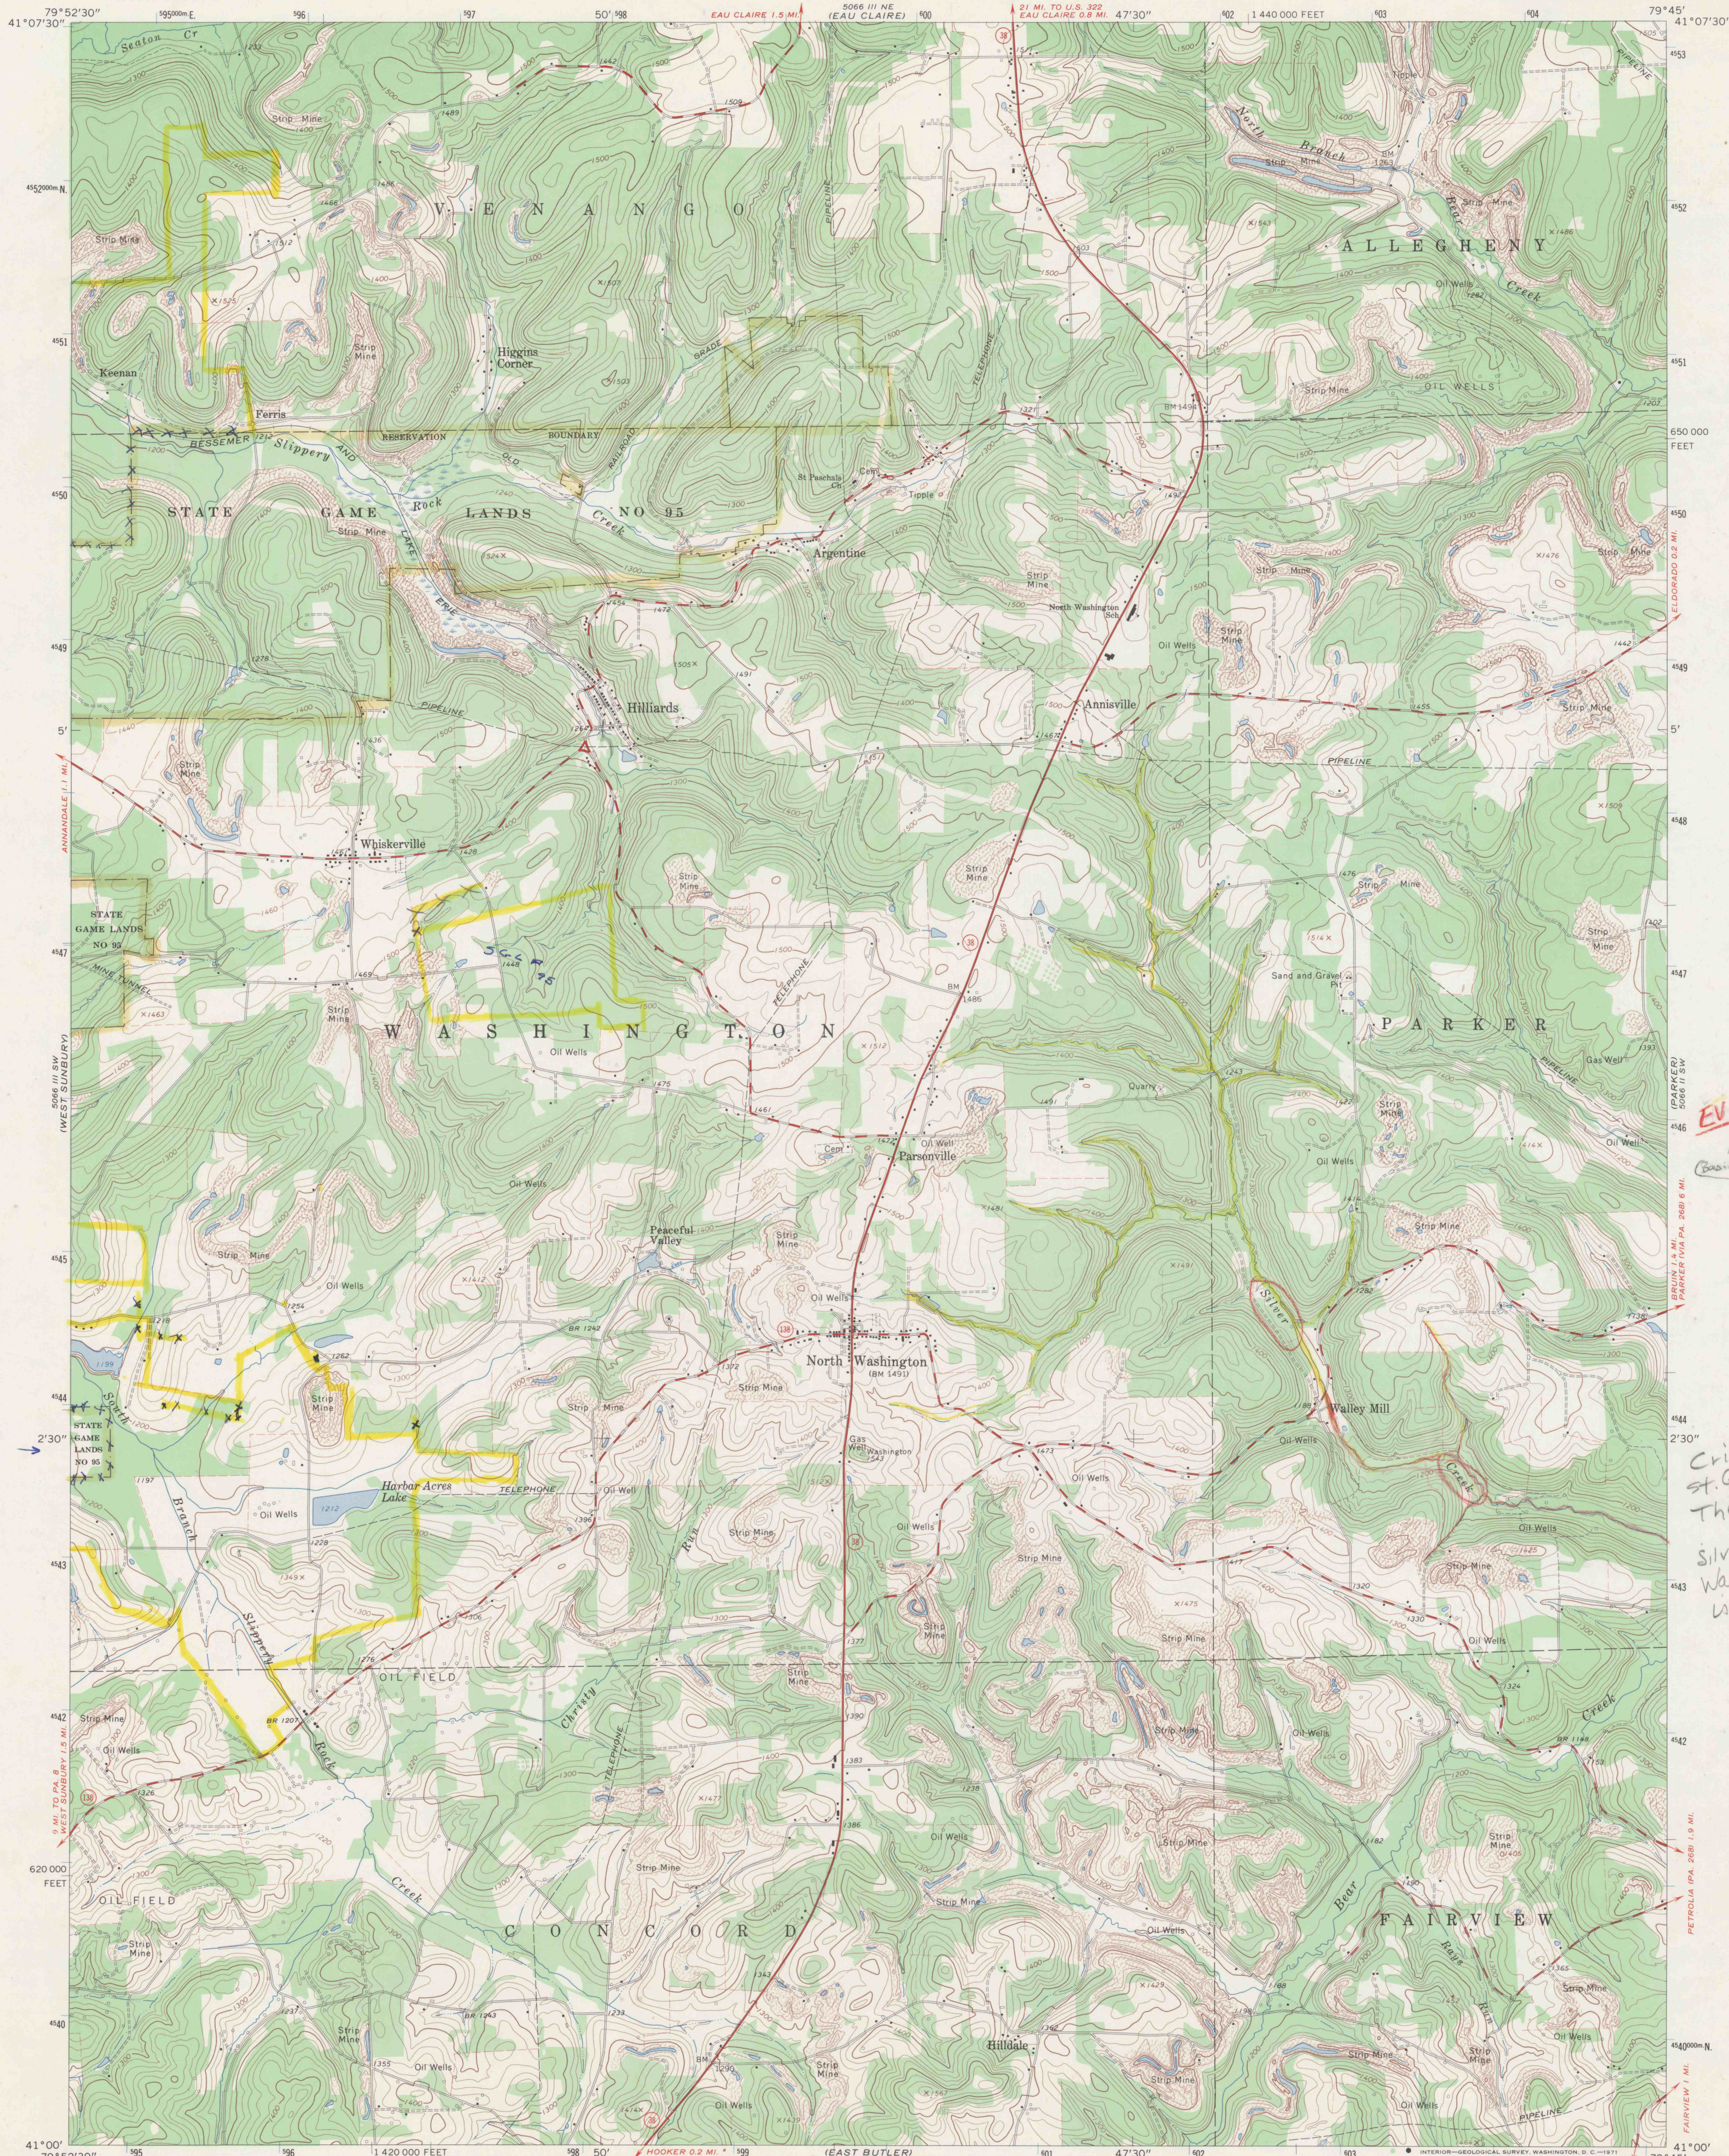

Mapped, edited, and published by the Geological Survey
Control by USGS and USC&GS
Topography by photogrammetric methods from aerial
photographs taken 1962. Field checked 1963
Polyconic projection. 1927 North American datum
10,000-foot grid based on Pennsylvania coordinate system, south zone
1000-meter Universal Transverse Mercator grid ticks,
zone 17, shown in blue
Fine red dashed lines indicate selected fence and field lines where
generally visible on aerial photographs. This information is unchecked

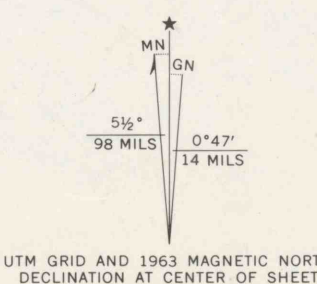

THIS MAP COMPLIES WITH NATIONAL MAP ACCURACY STANDARDS
FOR SALE BY U.S. GEOLOGICAL SURVEY, WASHINGTON, D.C. 20242
A FOLDER DESCRIBING TOPOGRAPHIC MAPS AND SYMBOLS IS AVAILABLE ON REQUEST

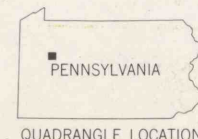

ROAD CLASSIFICATION	
Heavy-duty	Light-duty
Medium-duty	Unimproved dirt
State Route	

HILLIARDS, PA.
SE/4 HILLIARDS 15' QUADRANGLE
N4100—W7945/7.5

1963

AMS 5066 III SE—SERIES V831

DRAWING NUMBER

DRAWING NUMBER

DRAWING NUMBER
4-4.2

EV. SILVER CREEK + TRAILS
LISTS
Basin: source to CR10079
Bridge at Walley Mill

Crit. Habi.
St. G.L. #95
The Glades
Silver Creek from
Walley Mill to Mouth
is HQ
in red

SAM