

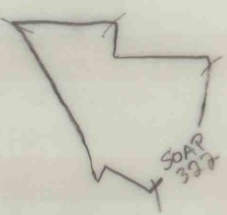


1539


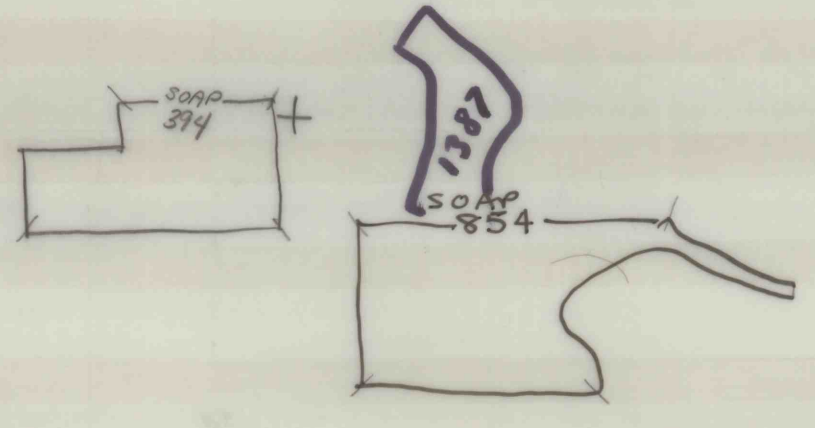


+

+

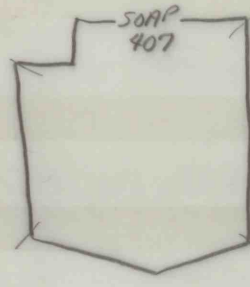

+

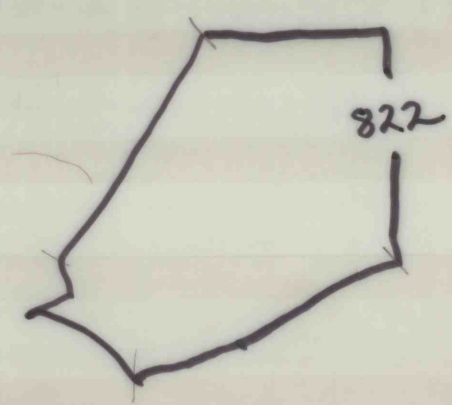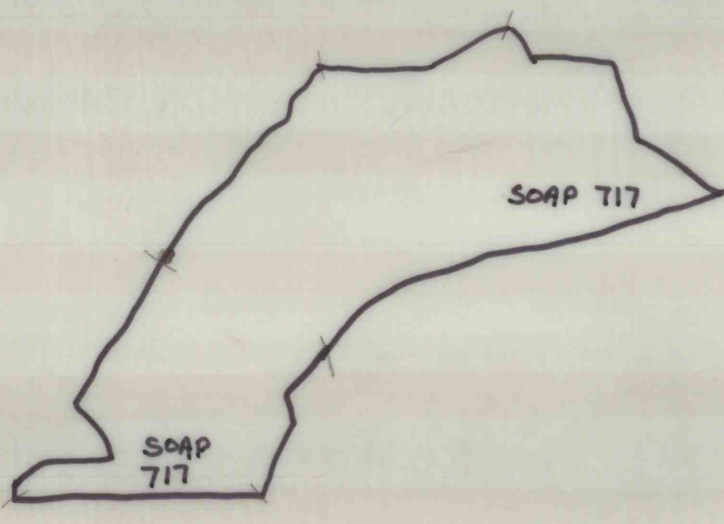

DRAWING NUMBER
PLAN HOLD CORPORATION • FINE, CALIFORNIA
MEMBER BY NUMBER 07348

DRAWING NUMBER
PLAN HOLD CORPORATION • FINE, CALIFORNIA
MEMBER BY NUMBER 07348

DRAWING NUMBER
SOAP 4-4.2
PLAN HOLD CORPORATION • FINE, CALIFORNIA
MEMBER BY NUMBER 07348

SOAP