PLAN HOLD

PEEL PROTECTIVE STRIP TO EXPOSE ADHESIVE. POSITION EDGE OF PRINT ON THIS LINE AND RUB TO ADHERE.

DRAWING NUMBER
E/4-4.2

1007

PLAN HOLD CORPORATION · TORRANCE · CALIFORNIA
REORDER BY NO. 0705A-24

COAL III
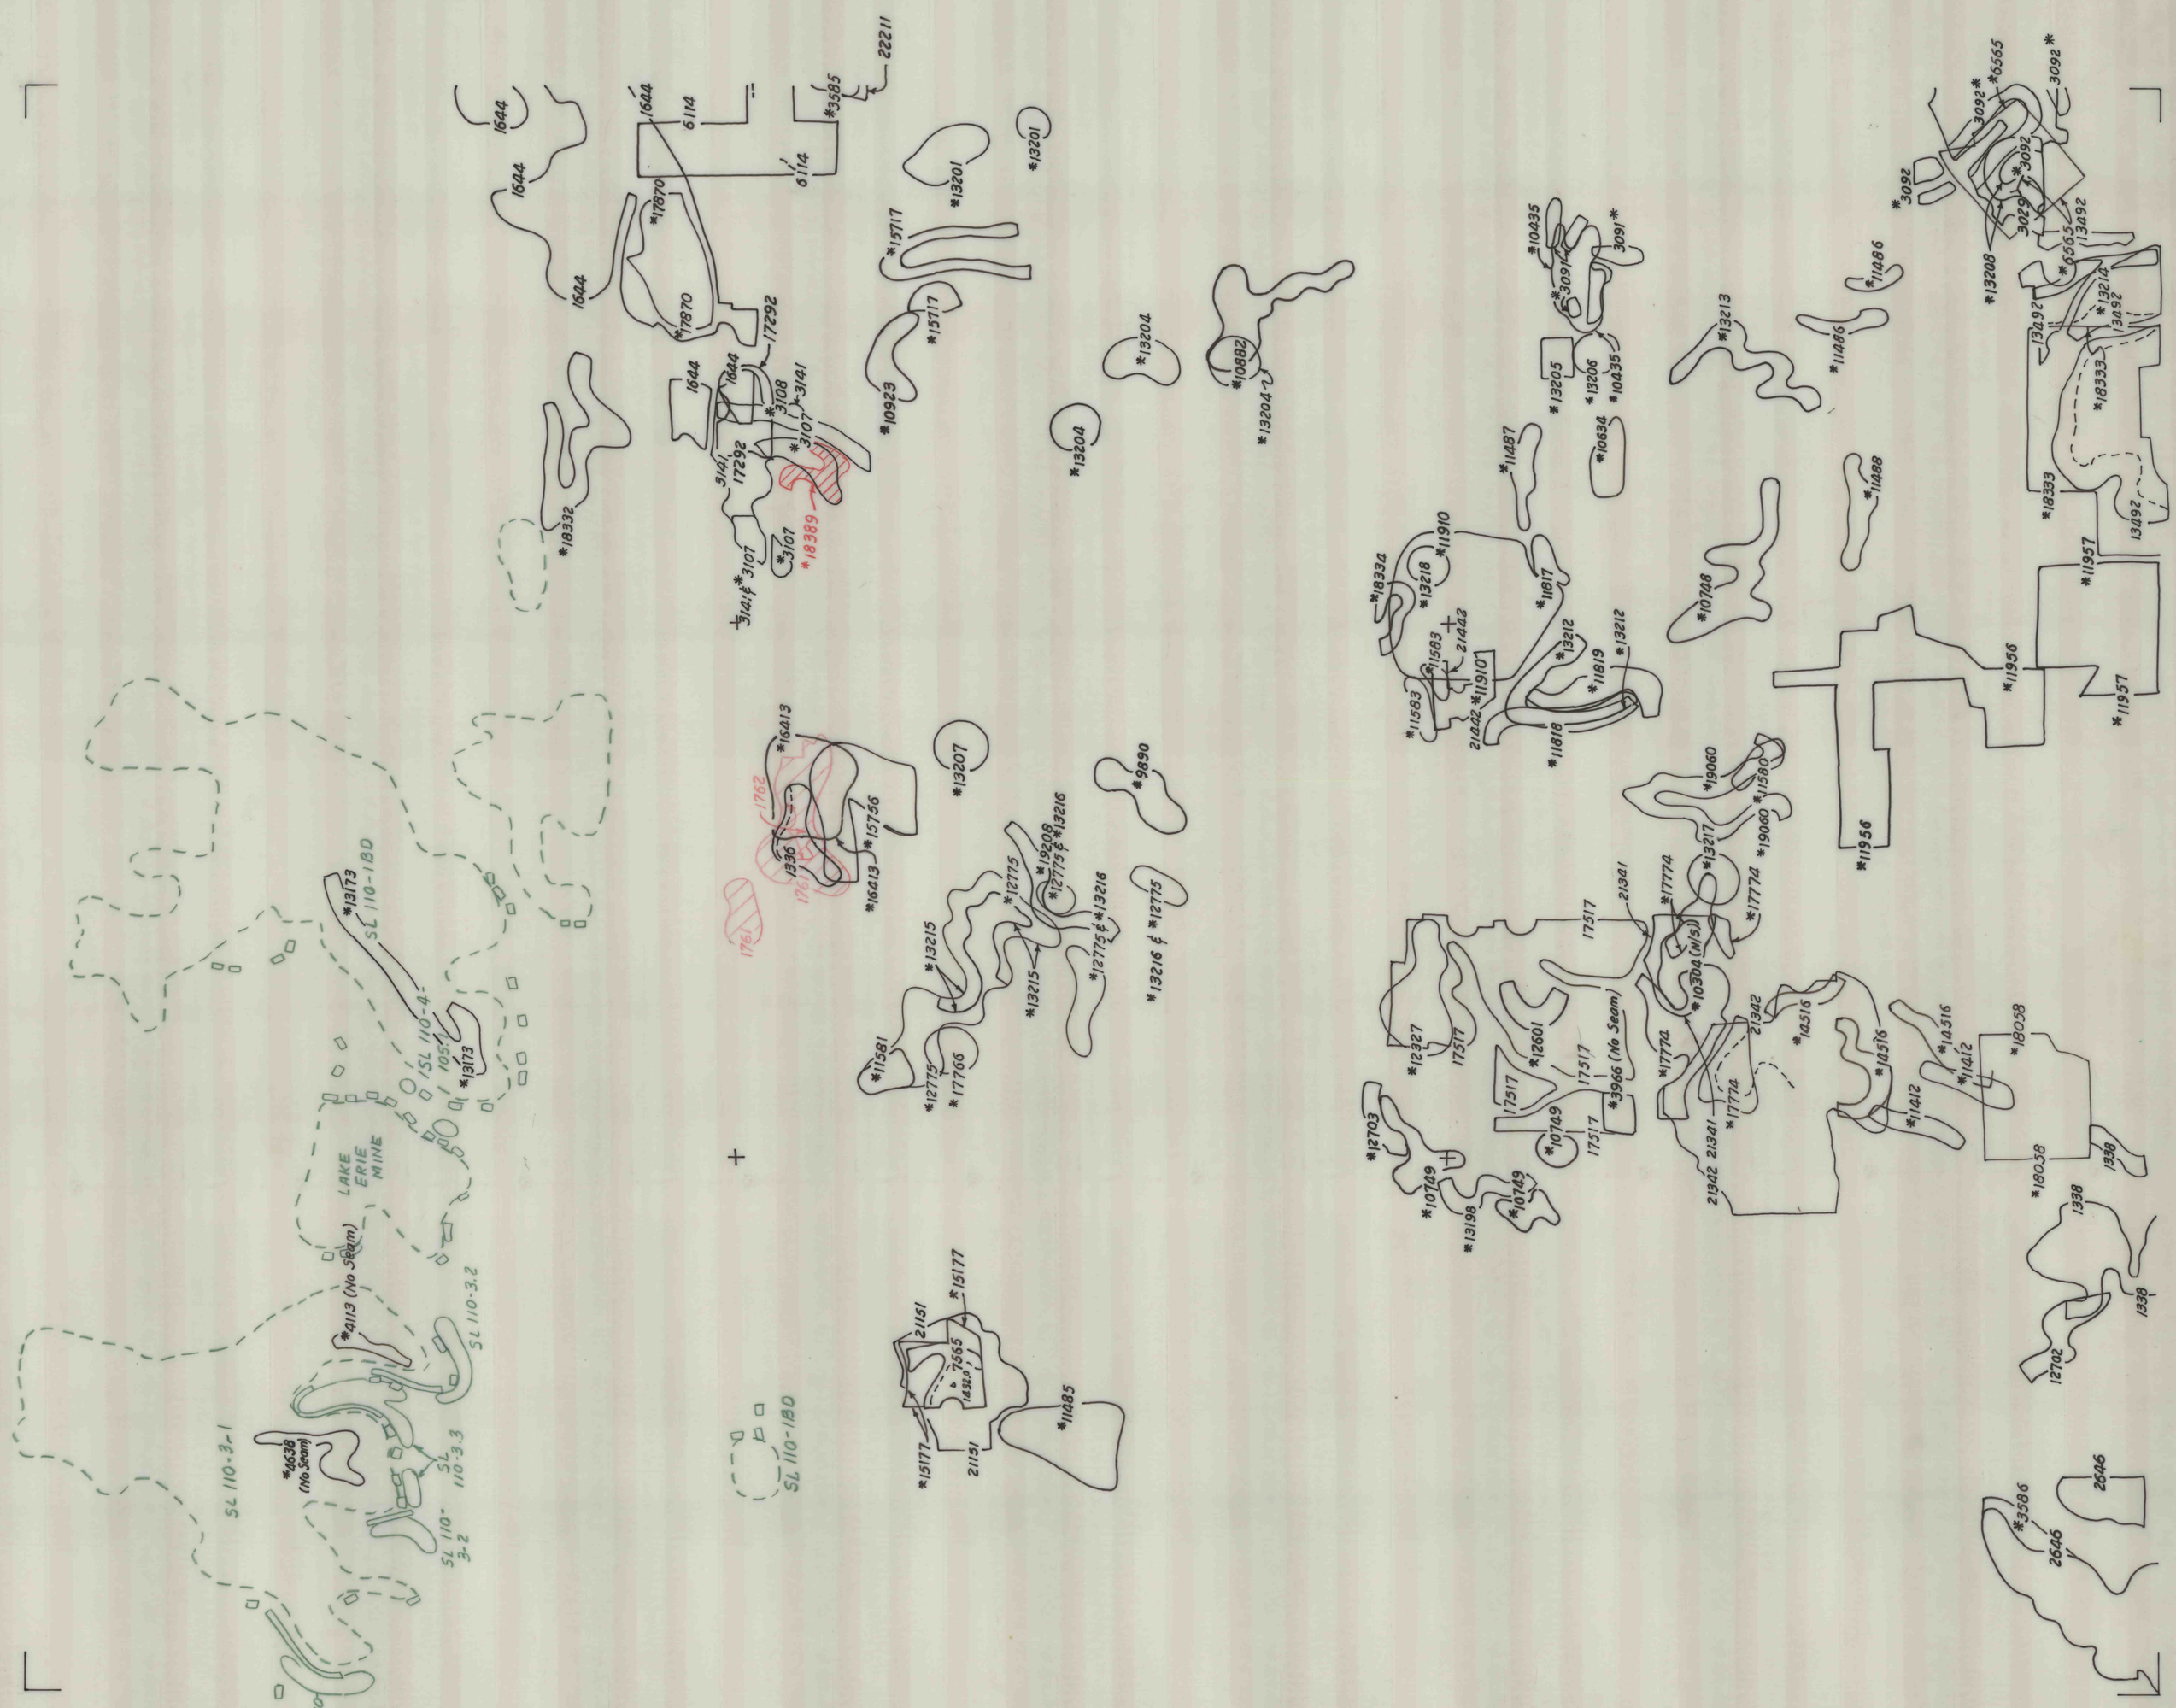
E/4-4.2 (Sheet 1 of 2)
1007