



PLAN HOLD

PEEL PROTECTIVE STRIP TO EXPOSE ADHESIVE. POSITION EDGE OF PRINT ON THIS LINE AND RUB TO ADHERE.


PLAN HOLD CORPORATION IRVINE CALIFORNIA  

DRAWING NUMBER  
**WS/4-13.3**

1024

WS/4-13.3  
1024

4133

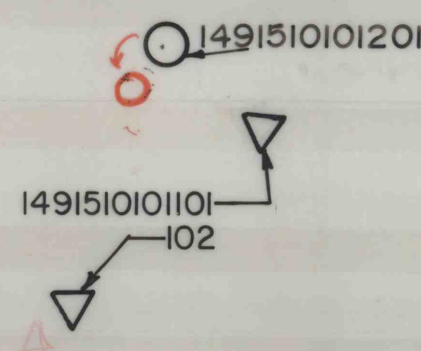

HOWARD