

UNITED STATES
DEPARTMENT OF THE INTERIOR
GEOLOGICAL SURVEY

STATE OF PENNSYLVANIA
DEPARTMENT OF INTERNAL AFFAIRS
TOPOGRAPHIC AND GEOLOGIC SURVEY

KANE QUADRANGLE
PENNSYLVANIA—MC KEAN CO.
7.5 MINUTE SERIES (TOPOGRAPHIC)
NE 1/4 KANE 15' QUADRANGLE

S. BR. KINZUA CK (1-3)
MUDLUCK RN (1)
GLAD RN (6)
WATERMILL RN (6)
MEADE RUN (2,3)
E. BR. TIONESTA (7)
TWO MILE RN (4)
MARTIN RN (7)
ALLEGHENY NATIONAL FOREST

SEE LEFT MARGIN
←
HQ -
South Branch Kinzua
Main St & UNTS.
Mudluck Run - B
Glad Run - B
Watermill Run - B
Meade Run - B
East Branch Tionesta
Basin
Twomile Run
Martin Run


Allegheny
National
Forest

North Country
Trail
AKB




DRAWING NUMBER

DRAWING NUMBER

DRAWING NUMBER
SAM 2-8.1

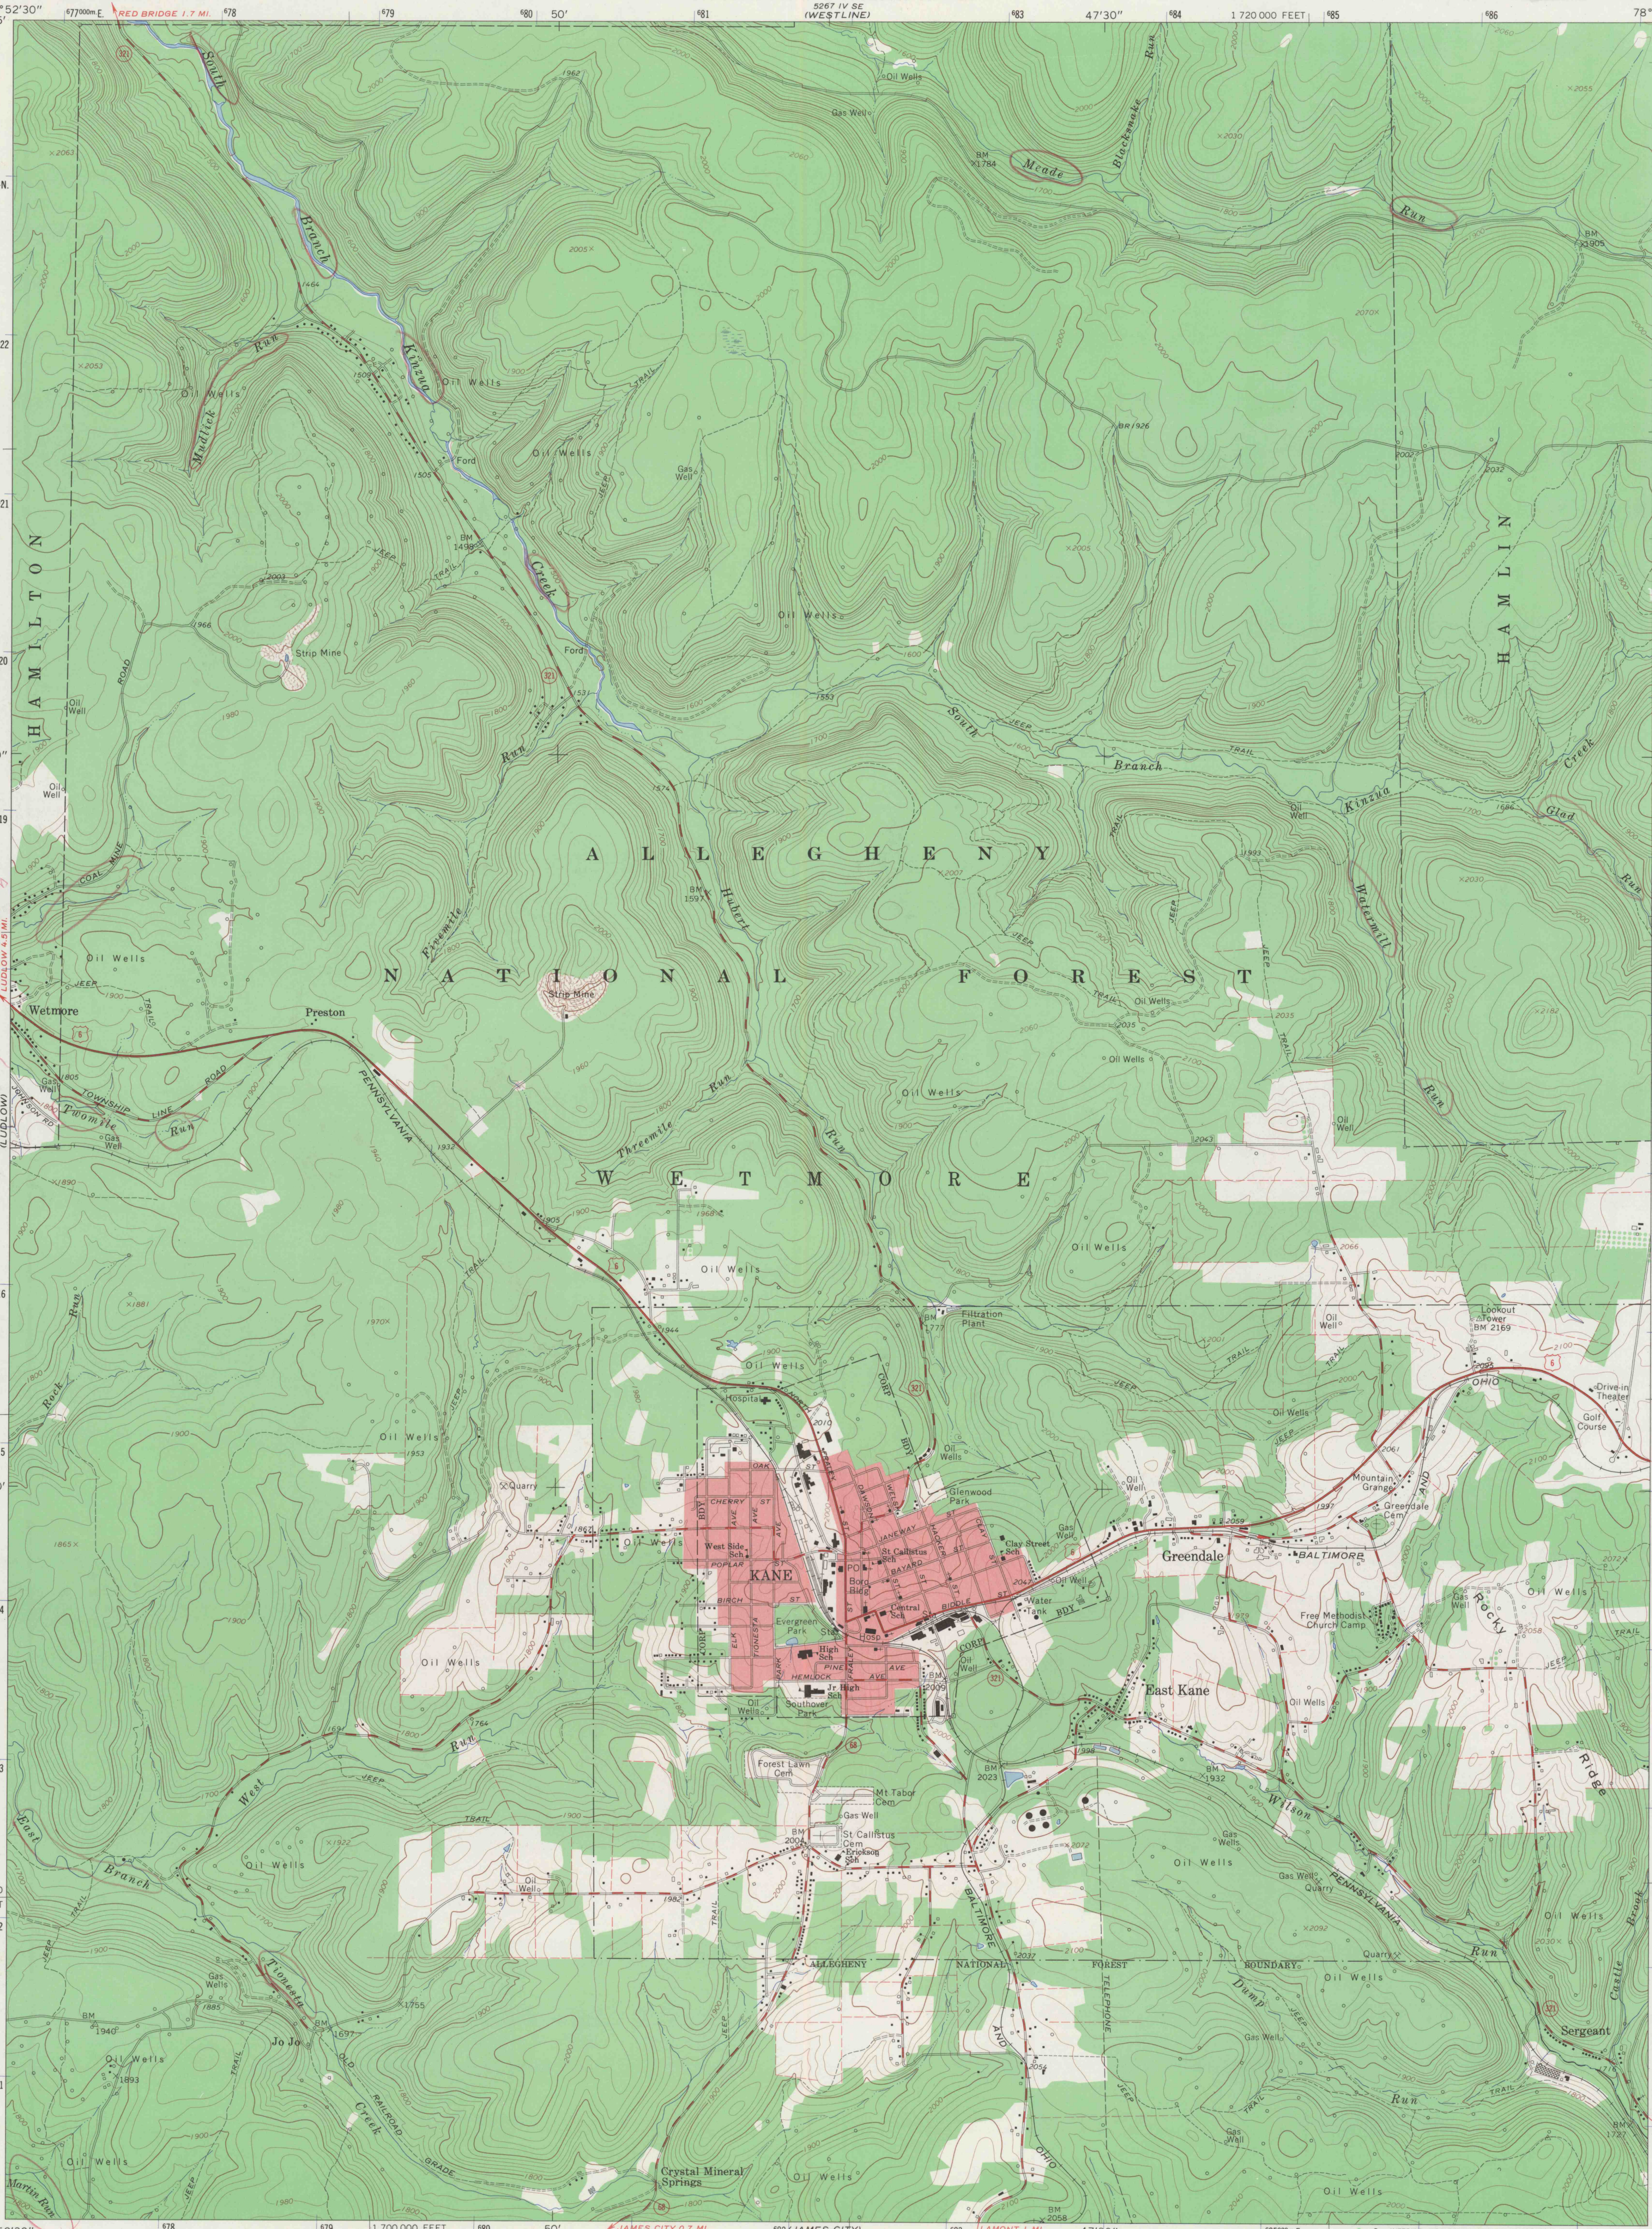

Mapped, edited, and published by the Geological Survey
Control by USGS and USC&GS
Topography by photogrammetric methods from aerial photographs
taken 1964. Field checked 1966
Polyconic projection. 1927 North American datum
10,000-foot grid based on Pennsylvania coordinate system, north zone
1000-meter Universal Transverse Mercator grid ticks, zone 17,
shown in blue
Fine red dashed lines indicate selected fence and field lines where
generally visible on aerial photographs. This information is unchecked
Red tint indicates area in which only landmark buildings are shown

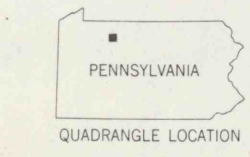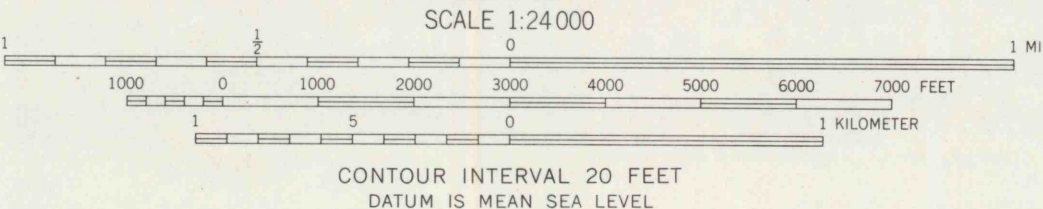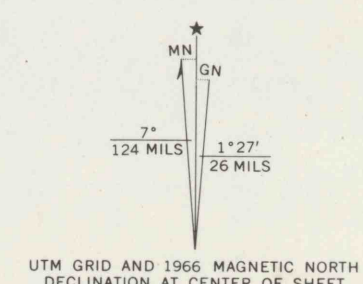

ROAD CLASSIFICATION
Heavy-duty ——— Light-duty ———
Medium-duty ——— Unimproved dirt ———
U.S. Route ——— State Route ———

KANE, PA.
NE 1/4 KANE 15' QUADRANGLE
N4137.5—W7845/7.5

1966

THIS MAP COMPLIES WITH NATIONAL MAP ACCURACY STANDARDS
FOR SALE BY U.S. GEOLOGICAL SURVEY, WASHINGTON, D. C. 20242
A FOLDER DESCRIBING TOPOGRAPHIC MAPS AND SYMBOLS IS AVAILABLE ON REQUEST