DRAWING NUMBER

C'/4-11.2

1021

COAL 109

C'/4-11.2 (Sheet 1 of 2)
1021
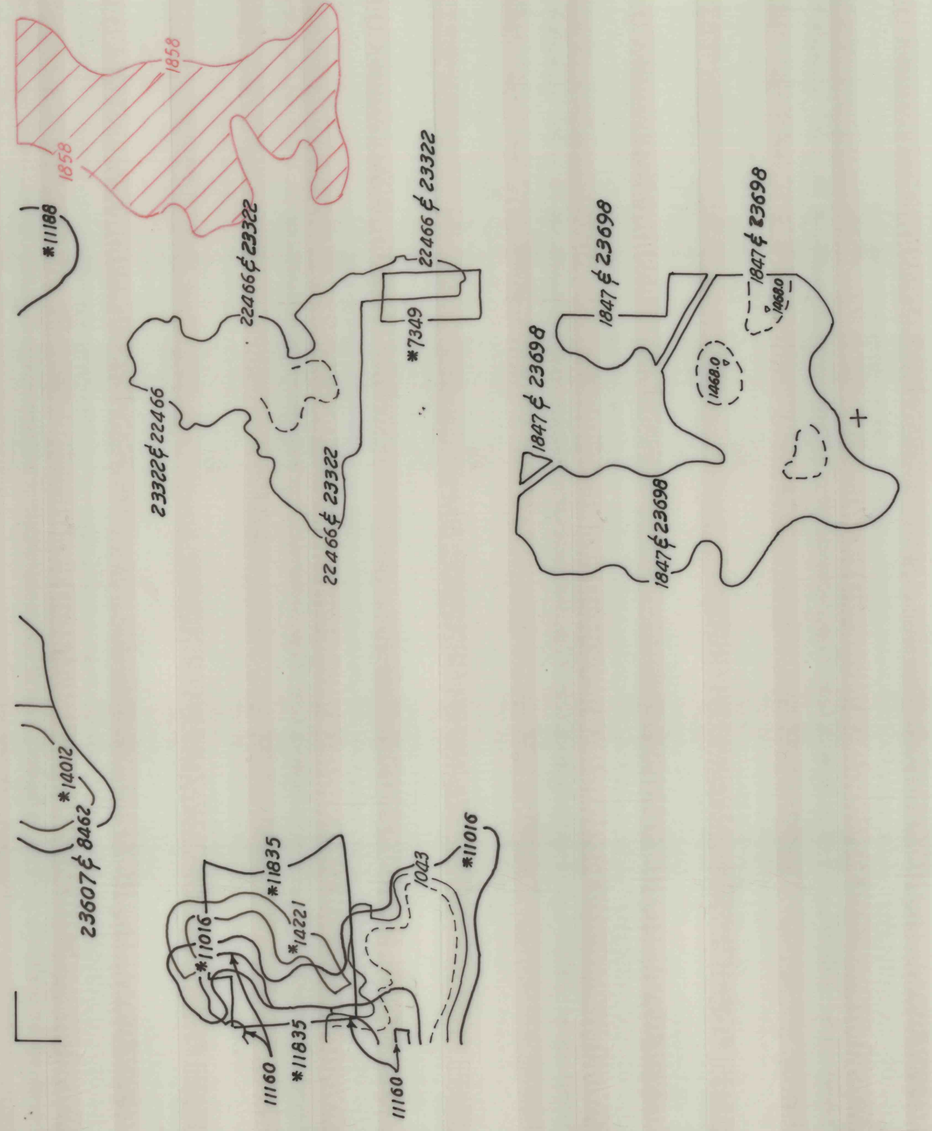
2778