

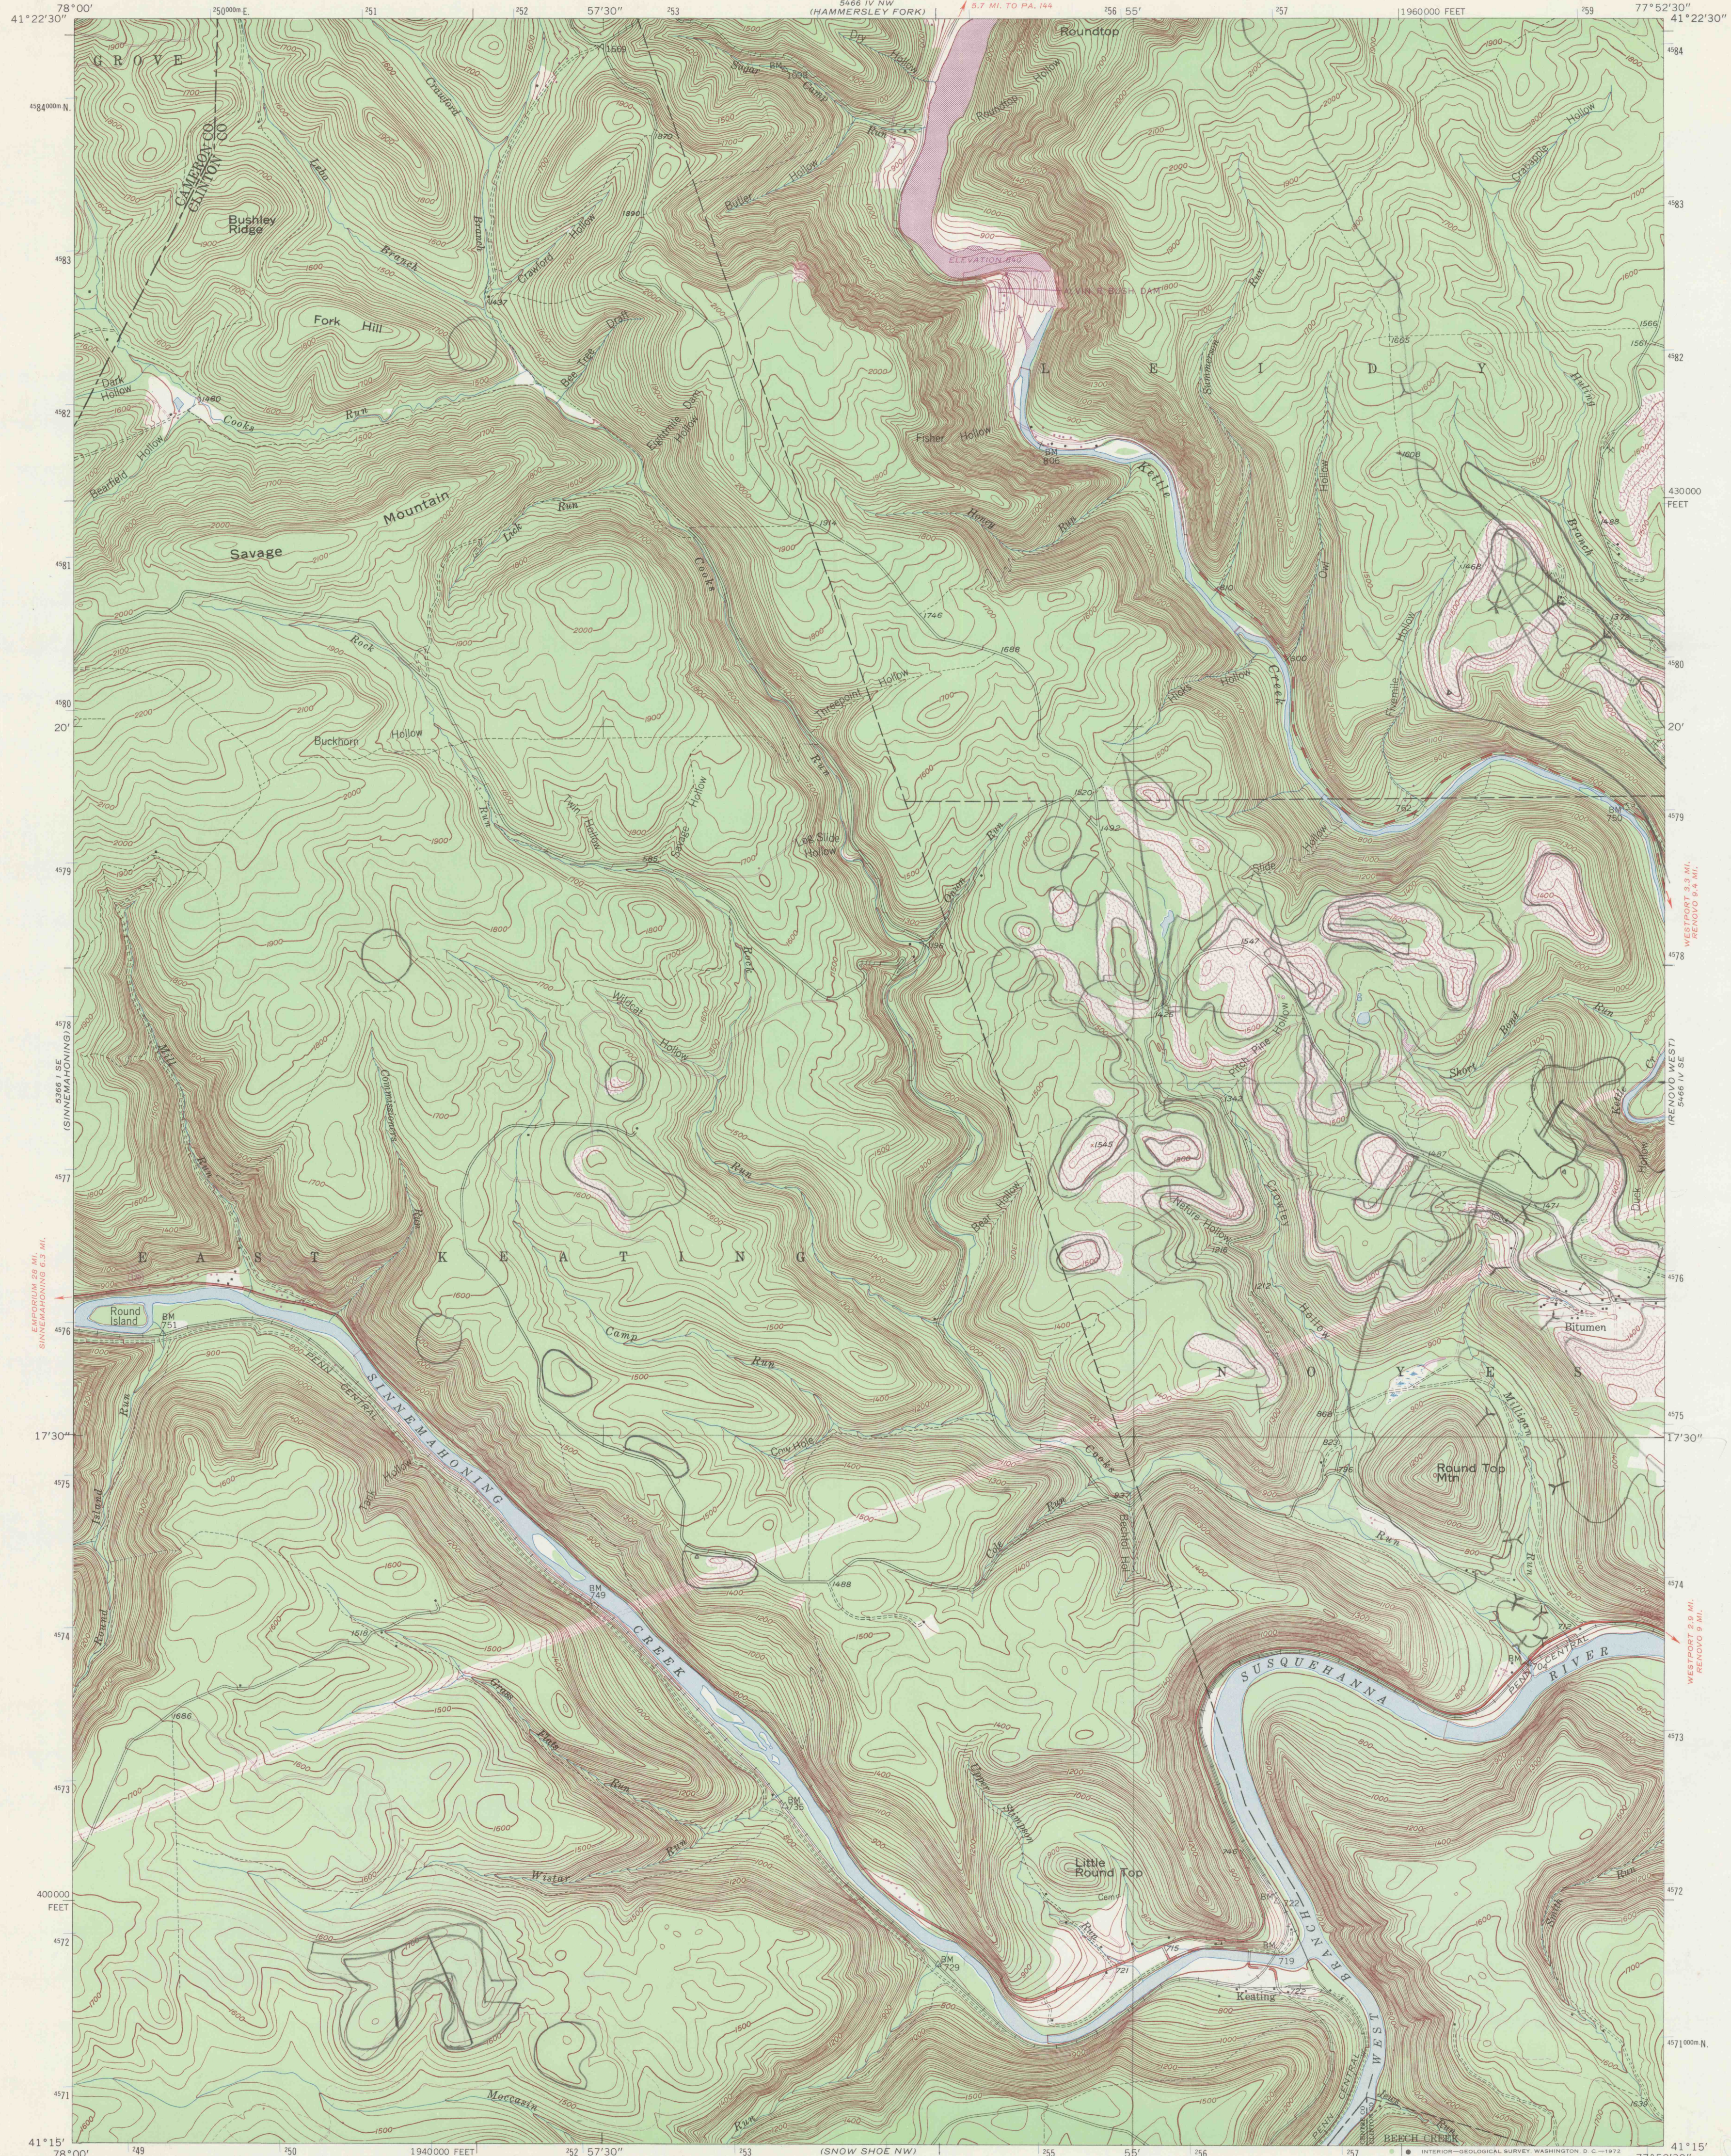
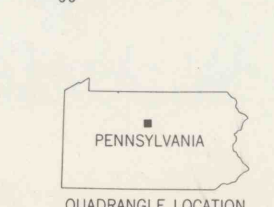


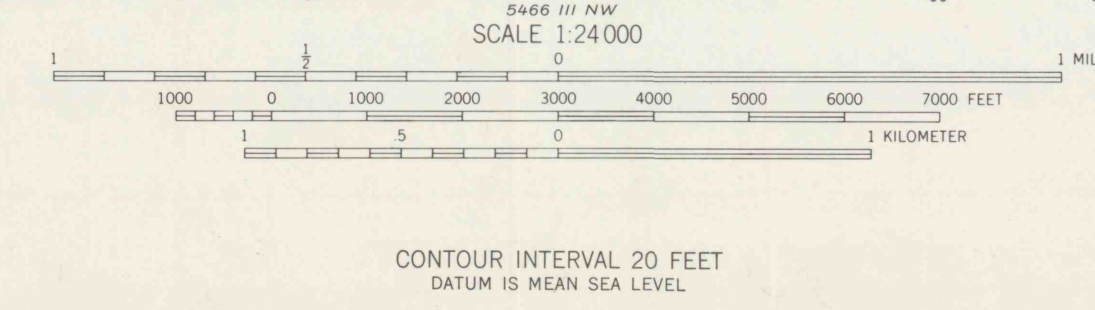

Mapped, edited, and published by the Geological Survey
Control by USGS and USC&GS
Topography from aerial photographs by multiplex methods
Aerial photographs taken 1944. Field check, 1946
Polyconic projection. 1927 North American datum
10 000-foot grid based on Pennsylvania coordinate system,
north zone
1000-meter Universal Transverse Mercator grid ticks,
zone 18, shown in blue
Area below elevation 937 is subject to controlled
inundation by Alvin R. Bush Dam
Revisions shown in purple compiled in cooperation with State of
Pennsylvania agencies from aerial photographs taken 1971. This
information not field checked

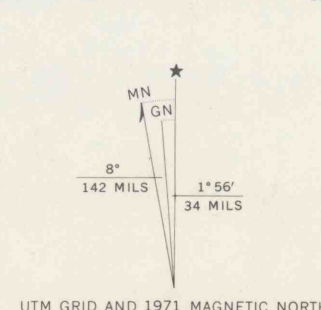

ROAD CLASSIFICATION

HARD-SURFACE ALL WEATHER ROADS	DRY WEATHER ROADS
Heavy-duty	Improved dirt
Medium-duty	Unimproved dirt
Loose-surface, graded, or narrow hard-surface	

State Route

KEATING, PA.
SW/4 RENOV WEST 15' QUADRANGLE
N4115-W7752.5/7.5
1946
PHOTOGRAPHED 1971
AMS 5466 IV SW-SERIES V831

PLAN HOLD

DRAWING NUMBER
3-12.3

0822

FEEL PROTECTIVE STRIP TO EXPOSE ADHESIVE. POSITION EDGE OF PRINT ON THIS LINE AND RUB TO ADHERE.

PLAN HOLD CORPORATION - TORRANCE, CALIFORNIA
REORDER BY NO. 0763-24