







PLAN HOLD

PEEL PROTECTIVE STRIP TO EXPOSE ADHESIVE. POSITION EDGE OF PRINT ON THIS LINE AND RUB TO ADHERE.

PLAN HOLD CORPORATION - TORRANCE - CALIFORNIA
REORDER BY NO. 075A.24

DRAWING NUMBER
C/3-9.2

0817

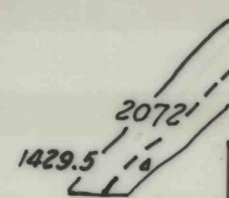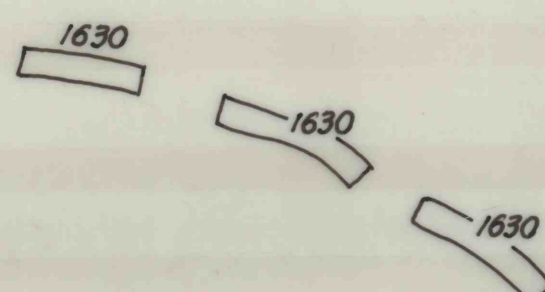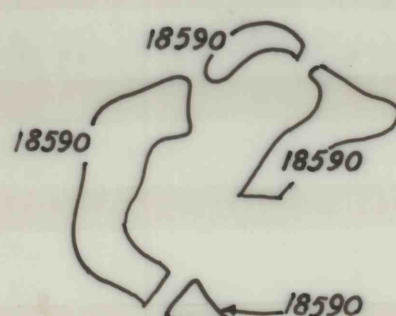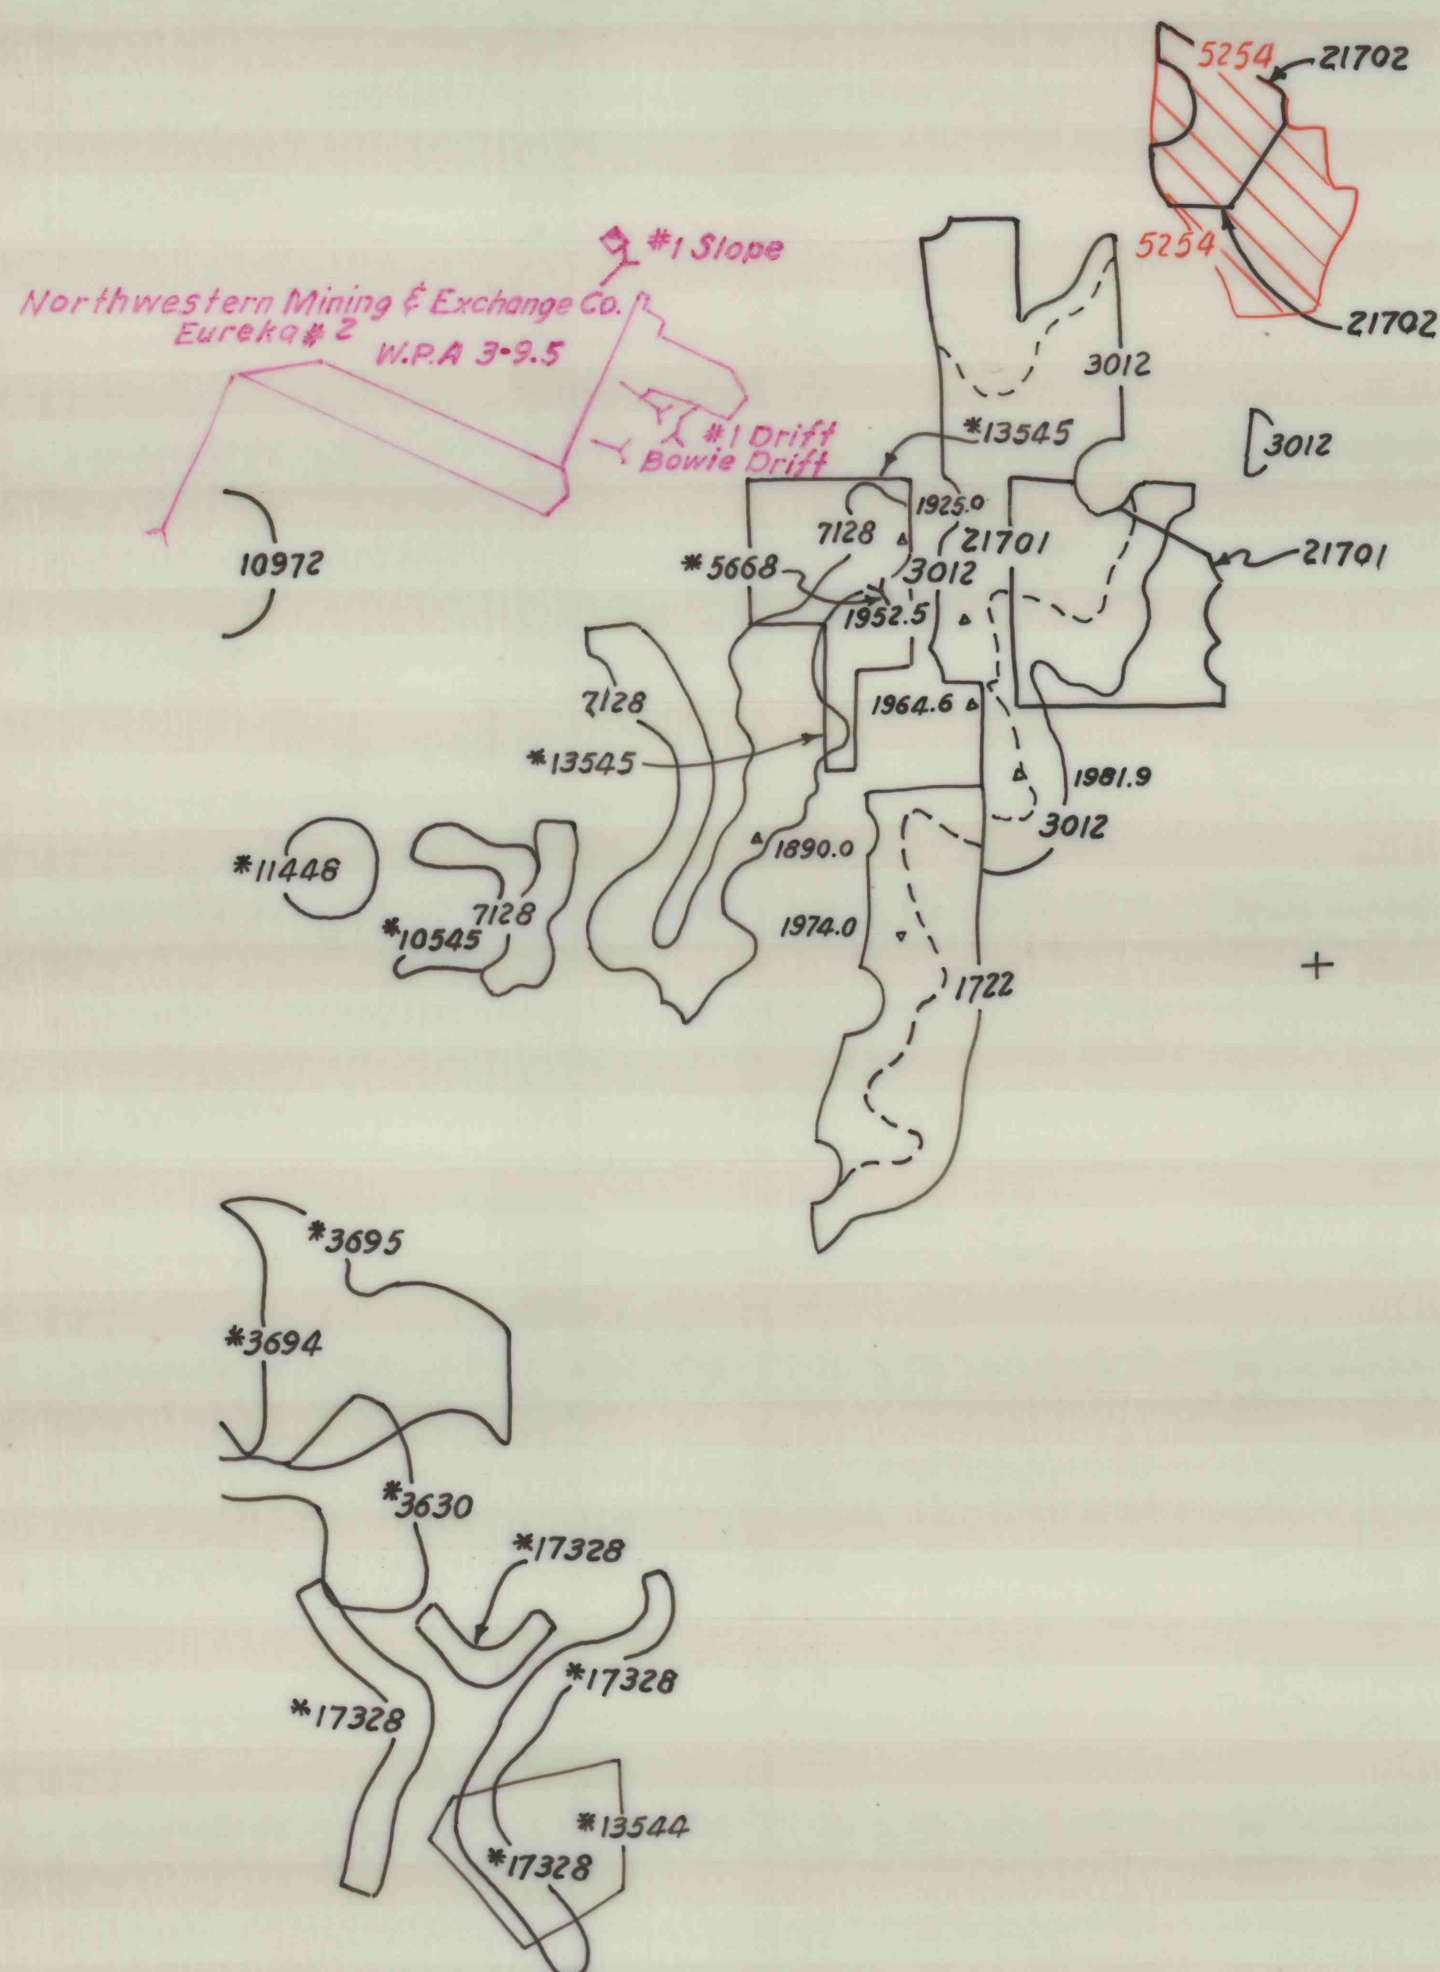

C/3-9.2 (Sheet 1 of 2)
0817