


UNITED STATES
DEPARTMENT OF THE INTERIOR
GEOLOGICAL SURVEY

KINGSTON QUADRANGLE
PENNSYLVANIA-LUZERNE CO.
7.5 MINUTE SERIES (TOPOGRAPHIC)

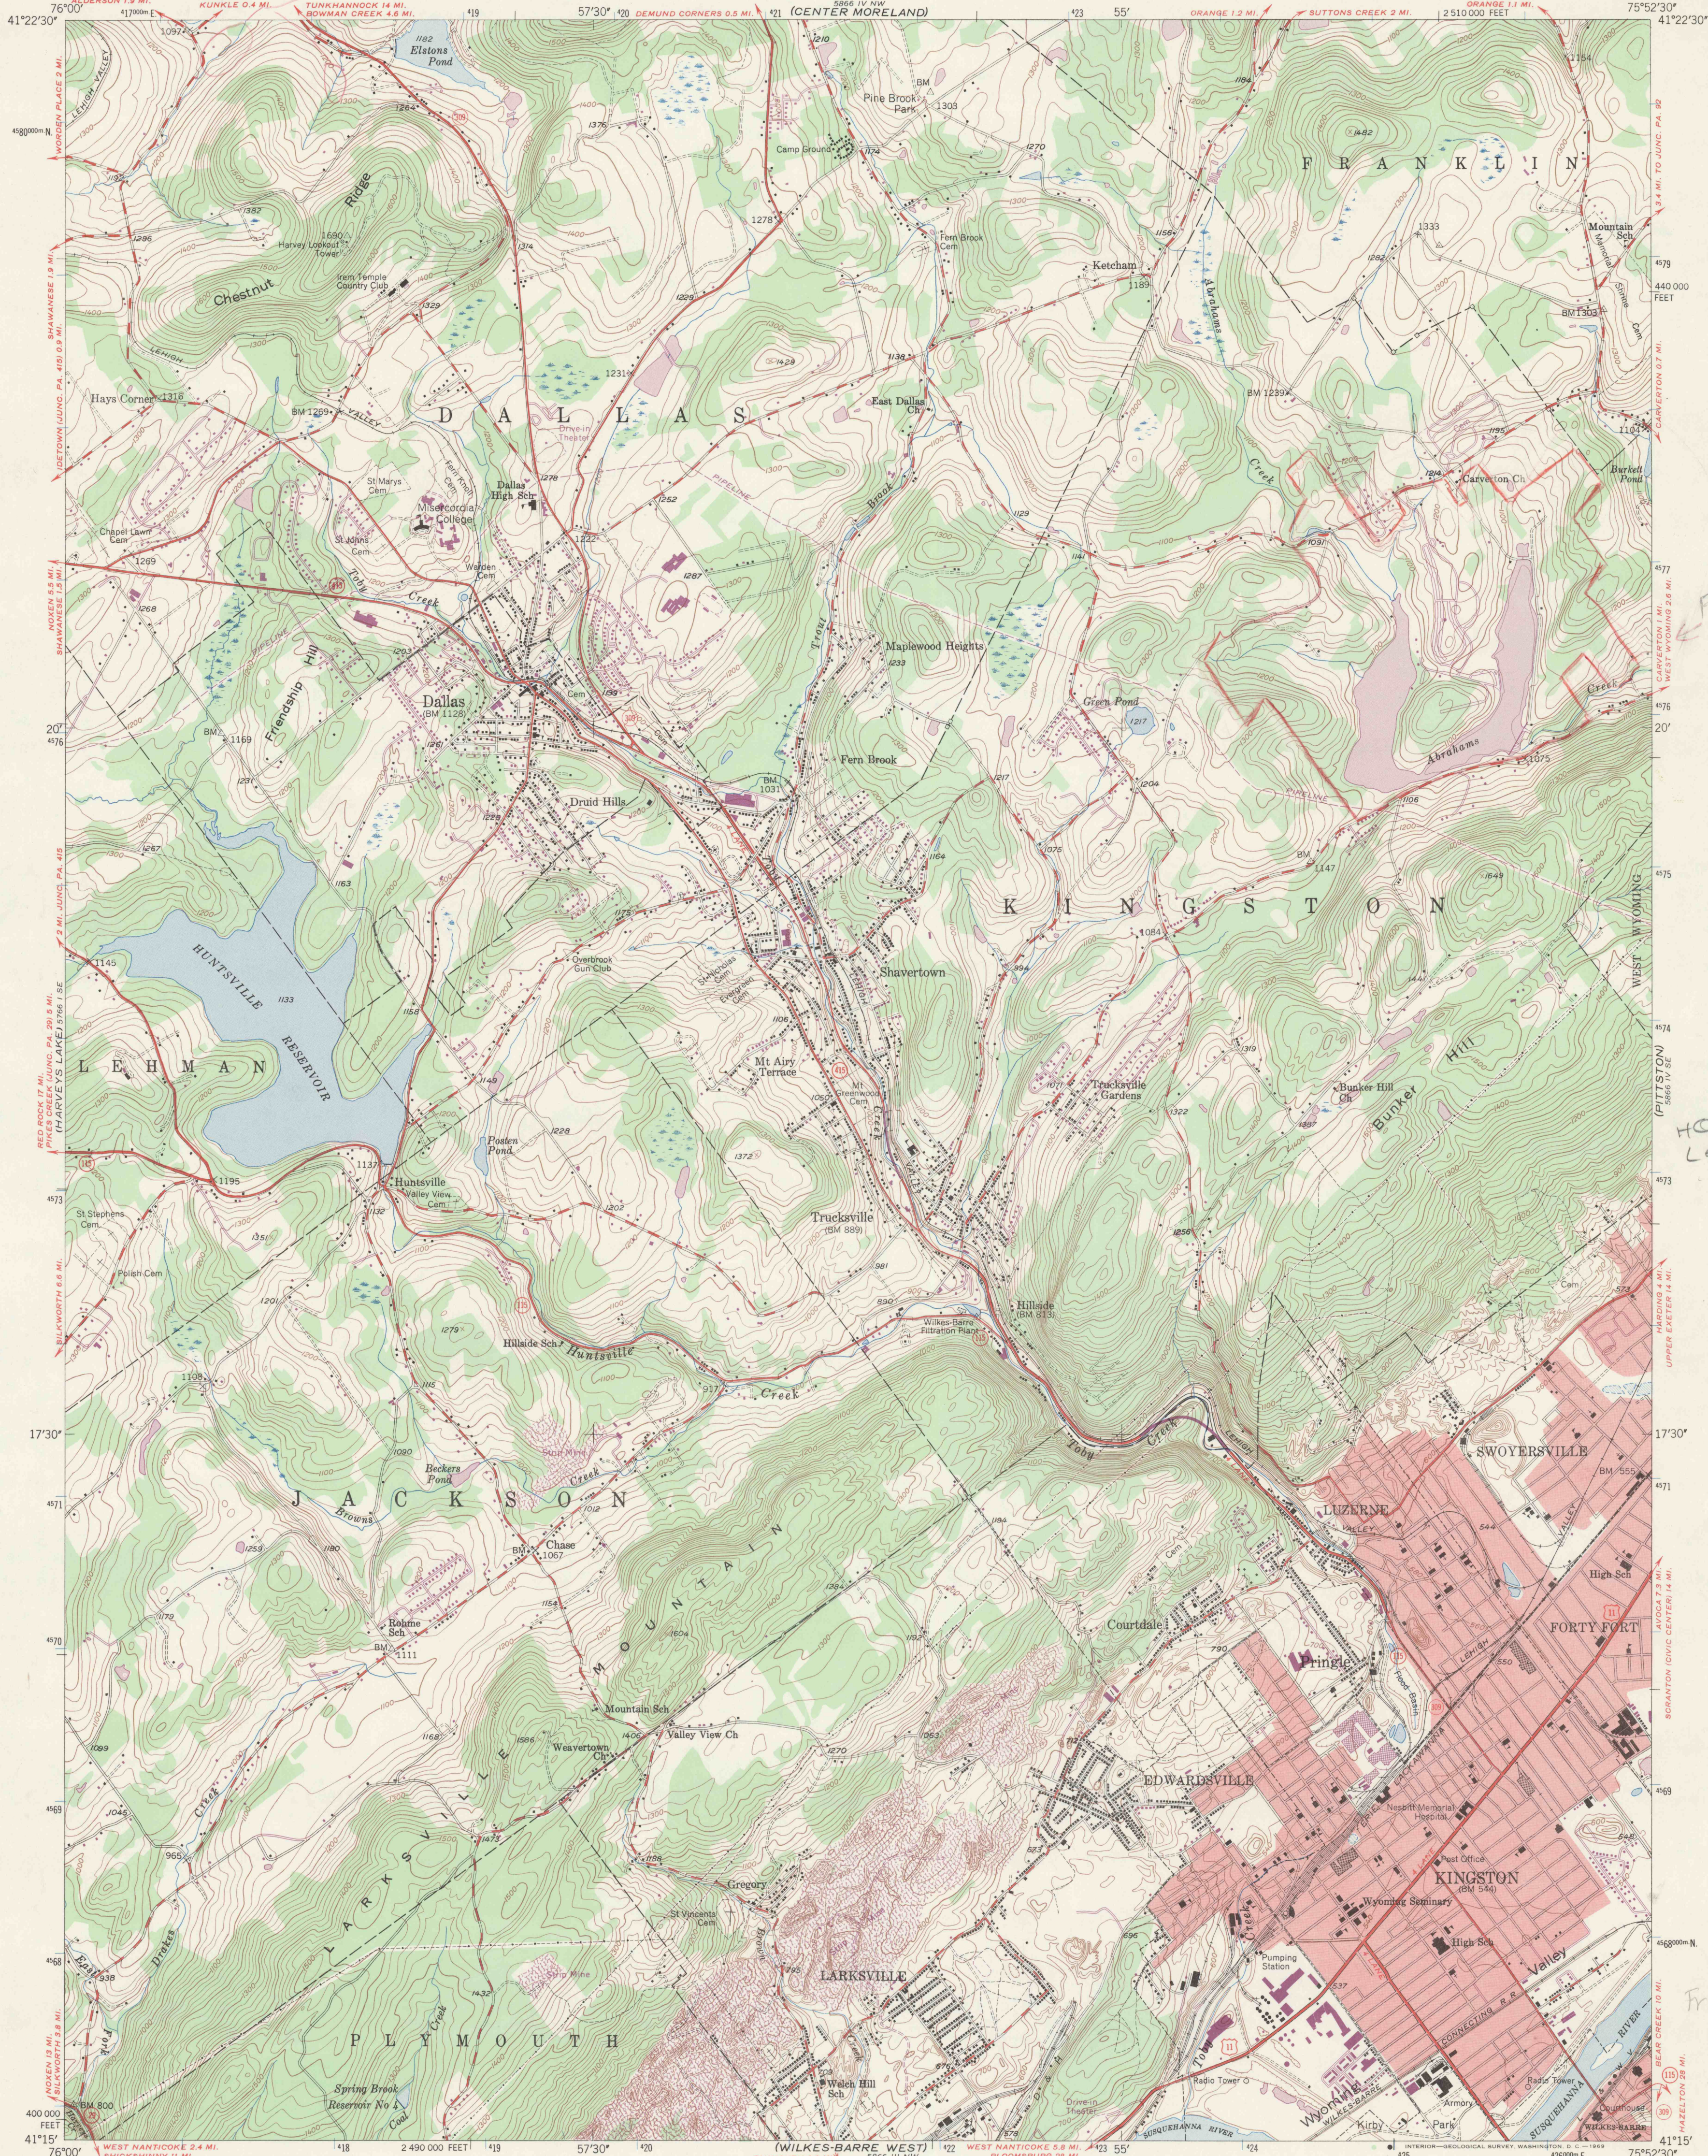

Mapped, edited, and published by the Geological Survey

Control by USGS, USC&GS and USED



Topography from aerial photographs by multiplex methods
Aerial photographs taken 1942. Field check 1946

Polyconic projection, 1927 North American datum
10,000-foot grid based on Pennsylvania coordinate system,
north zone.


1000-meter Universal Transverse Mercator grid ticks,
zone 18, shown in blue

Red tint indicates areas in which only
landmark buildings are shown

Revisions shown in purple compiled in cooperation with
State of Pennsylvania agencies, from aerial photographs taken 1969
This information not field checked

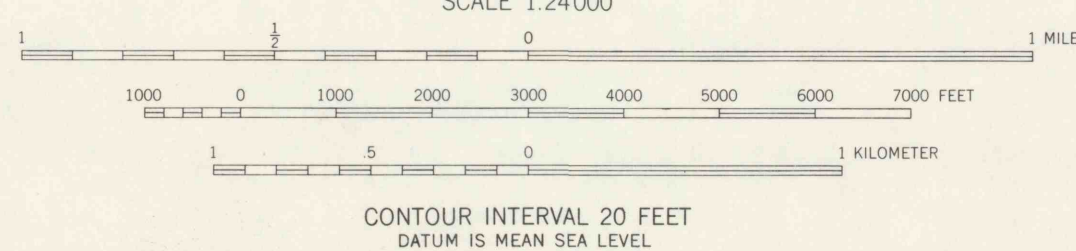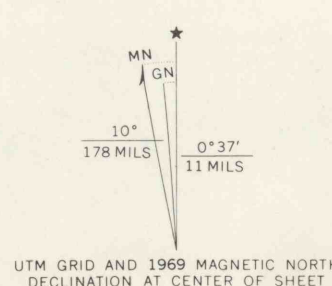

ROAD CLASSIFICATION	
Heavy-duty	Light-duty
Medium-duty	Unimproved dirt
U.S. Route	State Route

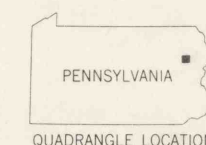

KINGSTON, PA.
N4115-W7552.5/7.5

1946
PHOTOGRAPHED 1969
AMS 5666 IV SW-SERIES V831

DRAWING NUMBER

DRAWING NUMBER

DRAWING NUMBER

SAM/3-203
0838

Frances
Stocum S.P.
01040

HQ stream
Leonard's Creek

Frances Stocum
S.P.
OK

3-20.3