



PLAN HOLD

PEEL PROTECTIVE STRIP TO EXPOSE ADHESIVE. POSITION EDGE OF PRINT ON THIS LINE AND RUB TO ADHERE.


PLAN HOLD CORPORATION IRVINE, CALIFORNIA
REORDER BY NO. 0705A-24

DRAWING NUMBER
W5/3-20.3

0838

W5/3-20.3
0838

3203

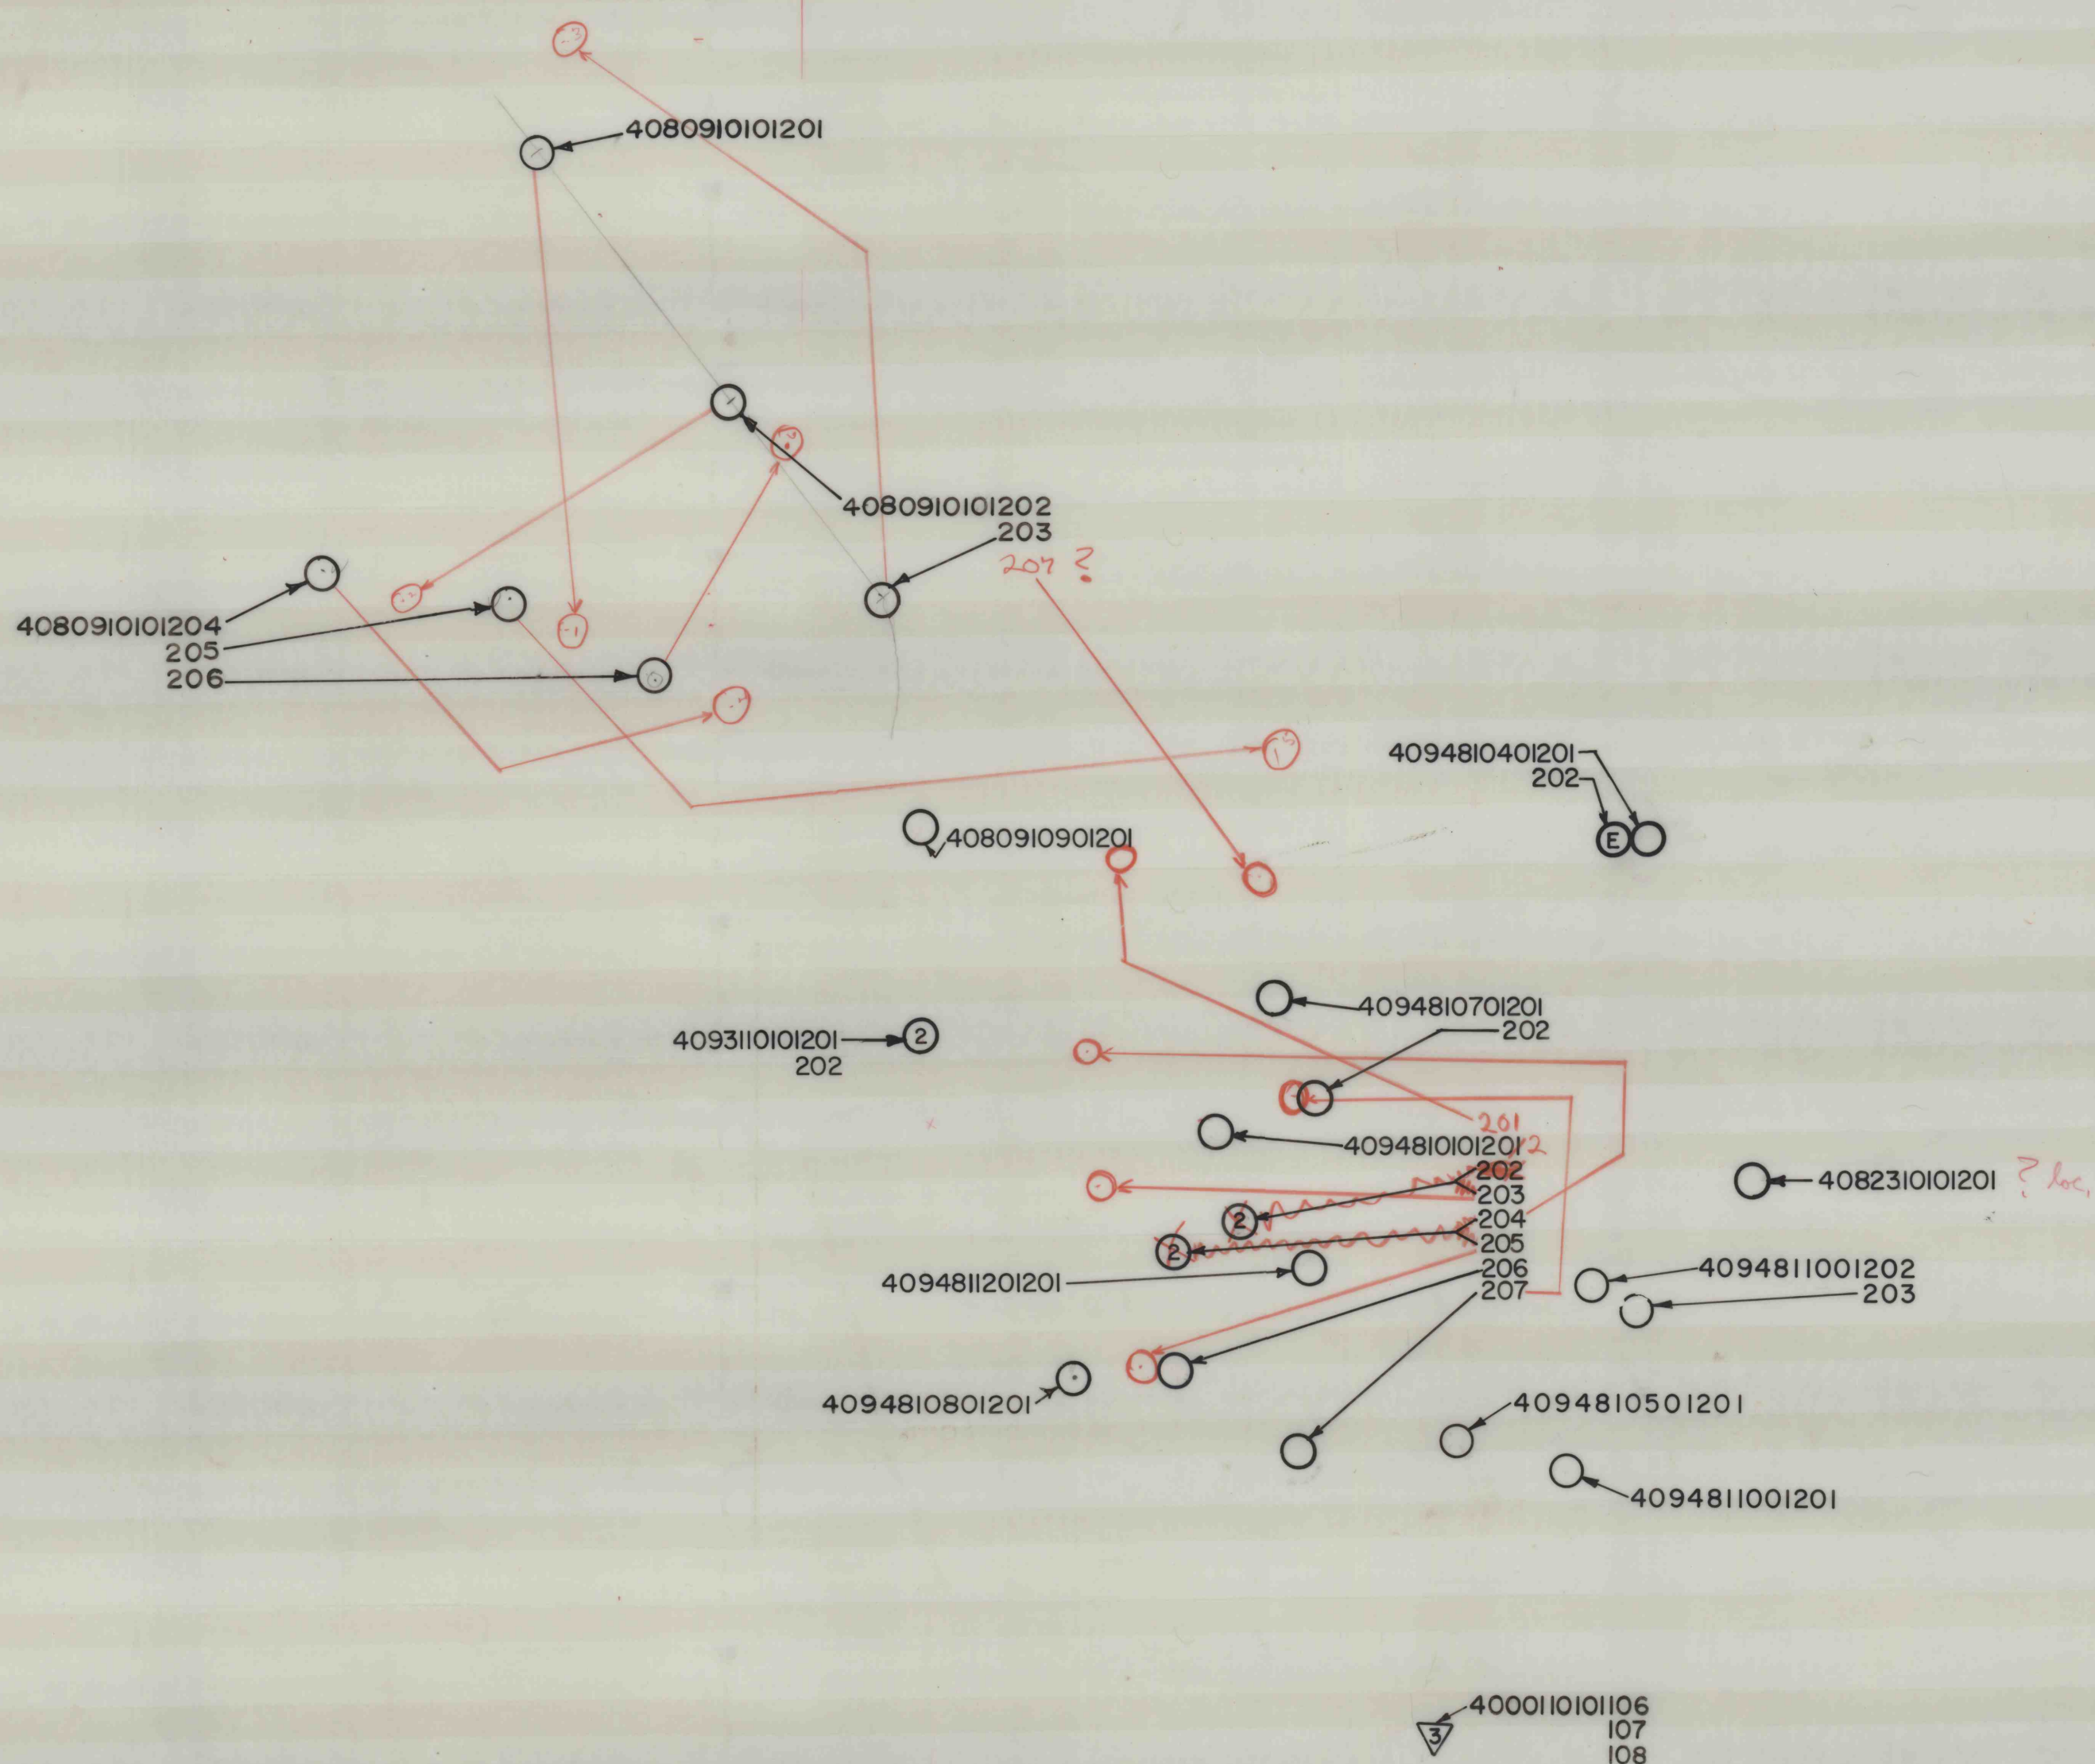

4000110101216

KINGSTON