


5066 II SE (KOSKUTH)


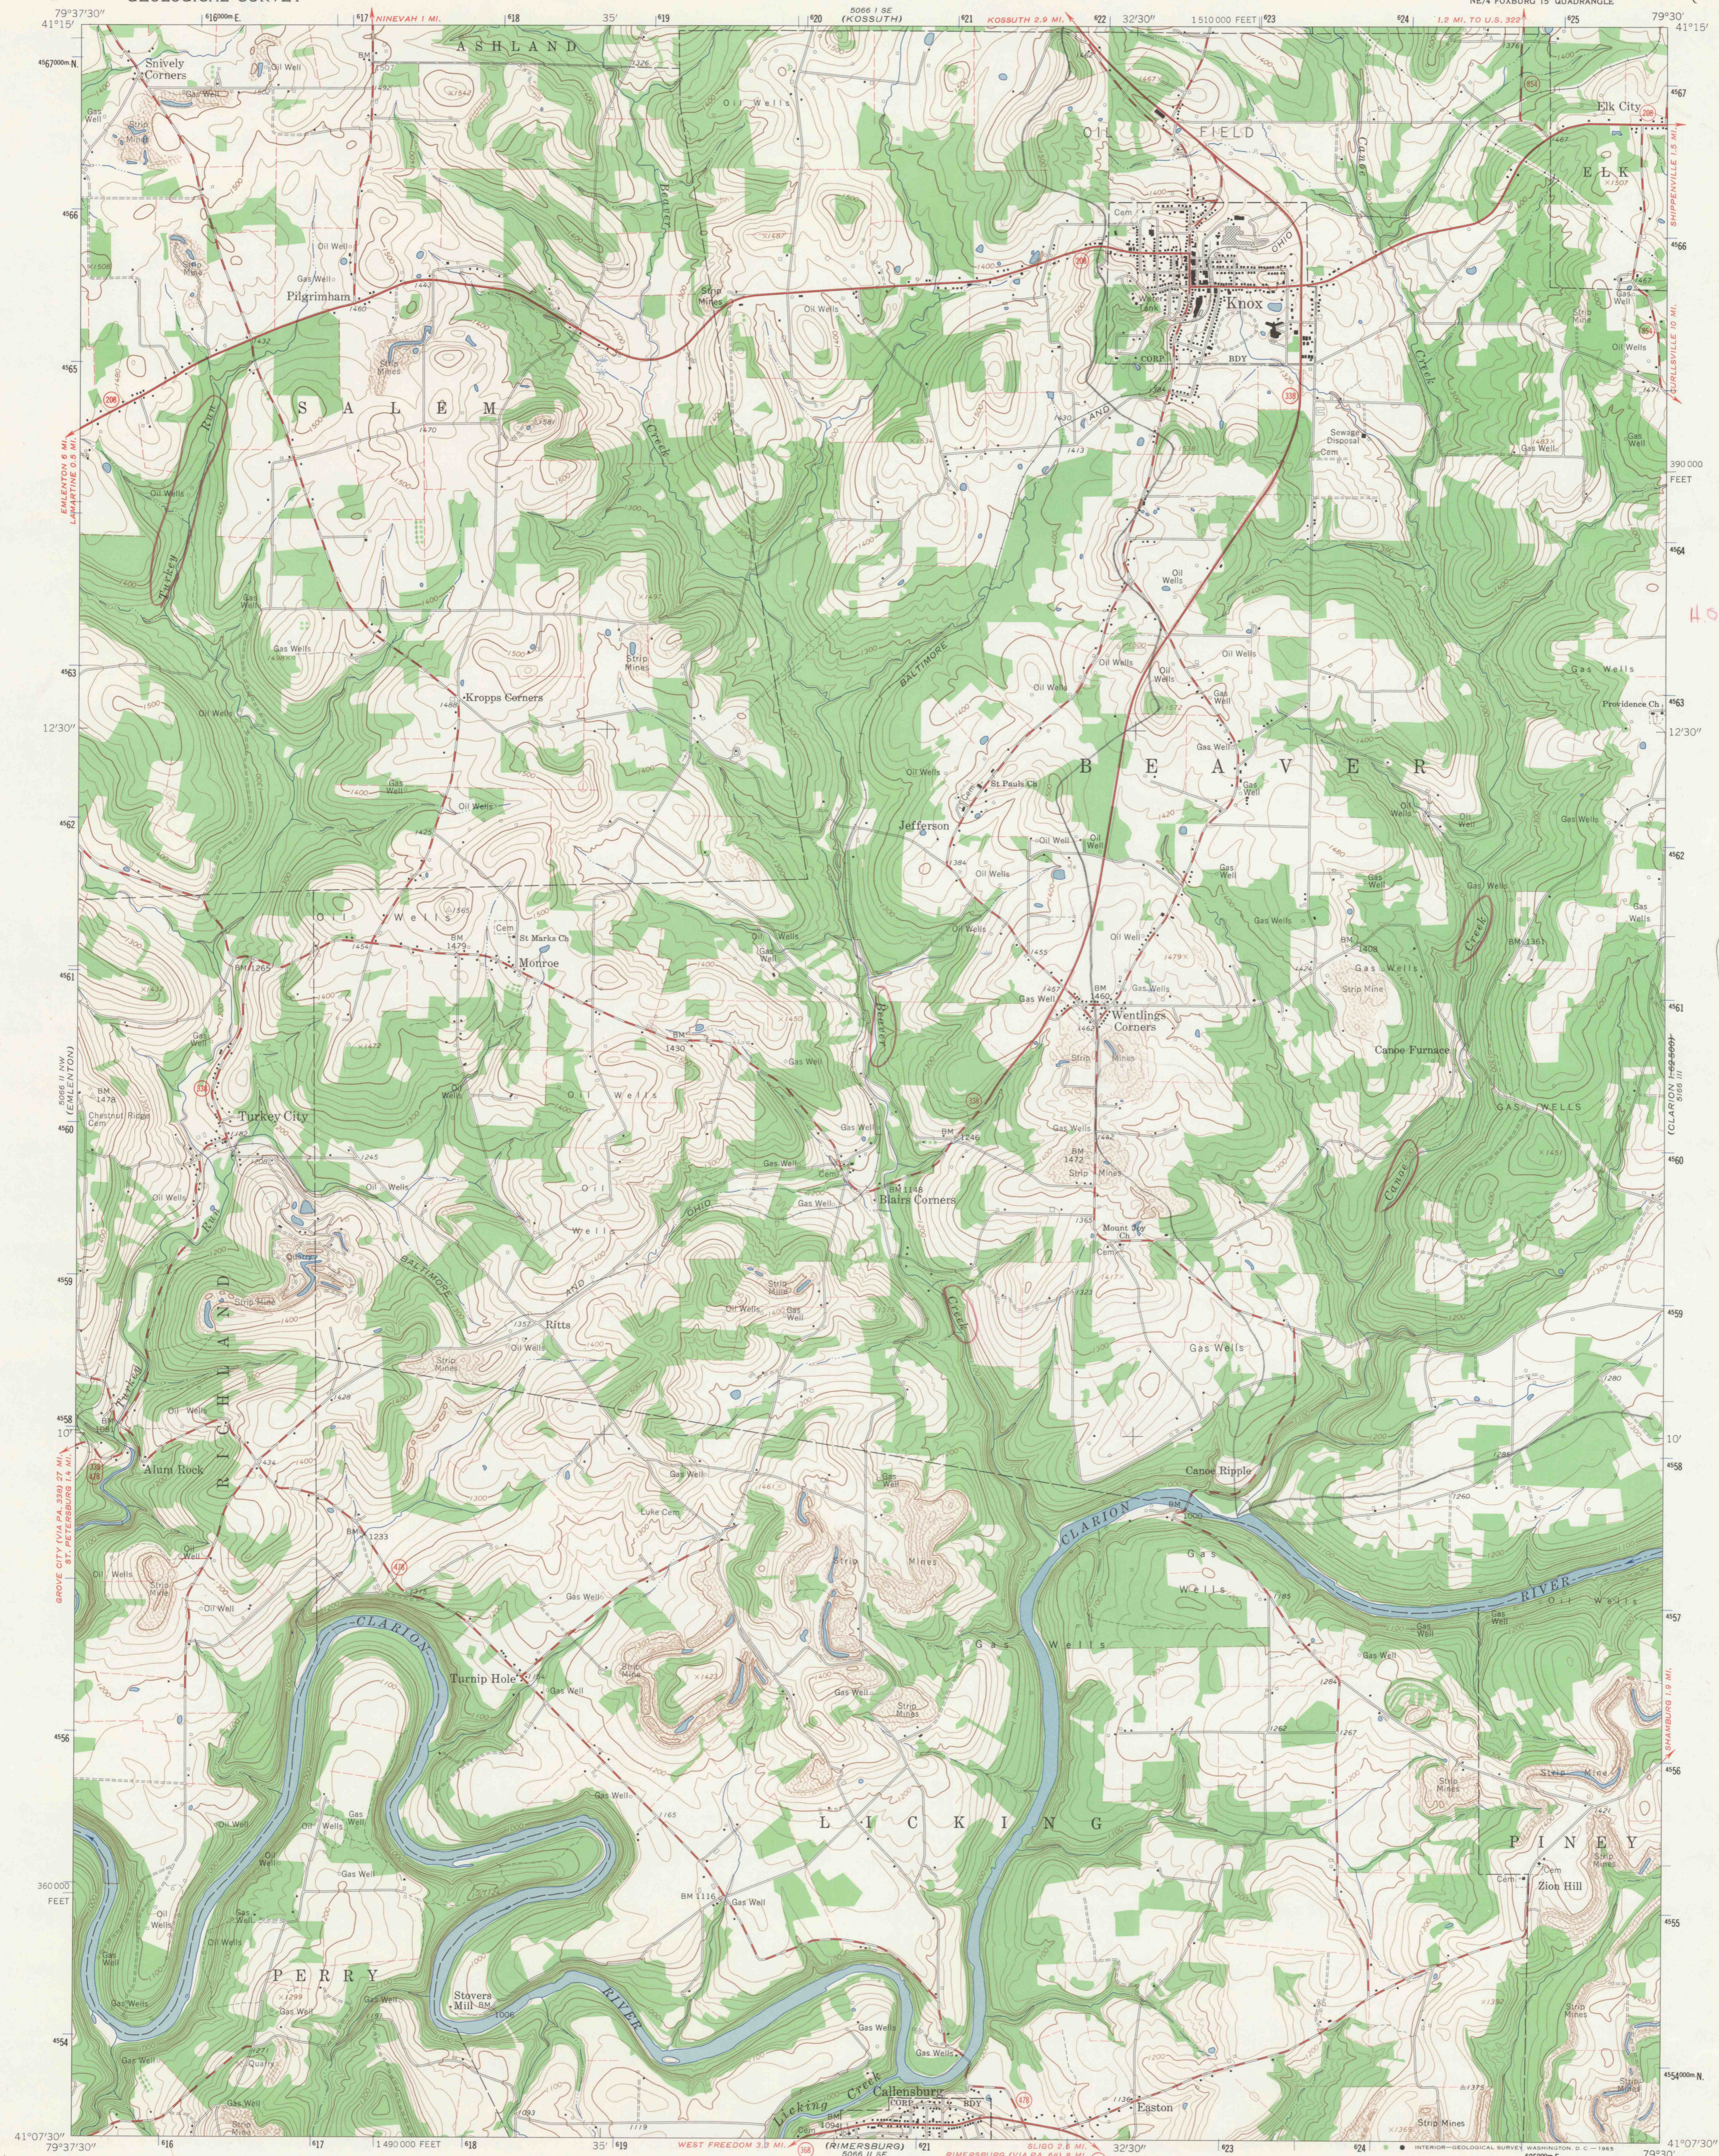

H.S. CANOE CR. BASIN  




DRAWING NUMBER

DRAWING NUMBER

DRAWING NUMBER  
SPM  
4-5.1

DRAWING NUMBER

Mapped, edited, and published by the Geological Survey  
Control by USGS, USC&GS, and USCE  
Topography by photogrammetric methods from aerial  
photographs taken 1962. Field checked 1963  
Polyconic projection. 1927 North American datum  
10,000-foot grid based on Pennsylvania coordinate system, north zone  
1000-meter Universal Transverse Mercator grid ticks,  
zone 17, shown in blue  
Fine red dashed lines indicate selected fence and field lines where  
generally visible on aerial photographs. This information is unchecked

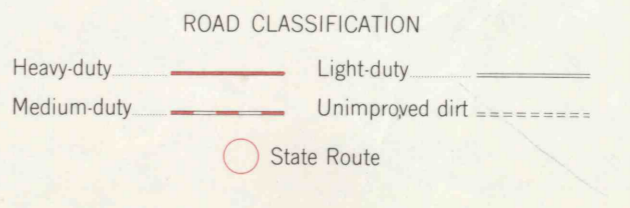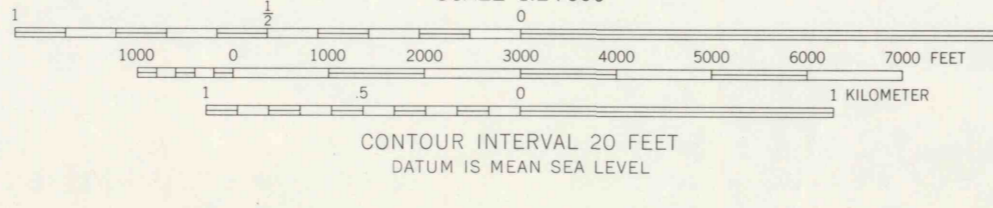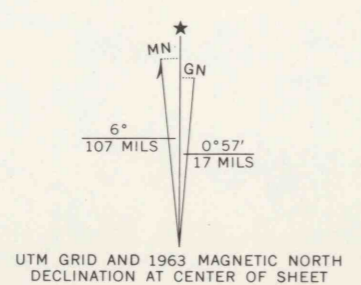

THIS MAP COMPLIES WITH NATIONAL MAP ACCURACY STANDARDS  
FOR SALE BY U. S. GEOLOGICAL SURVEY, WASHINGTON 25, D. C.  
A FOLDER DESCRIBING TOPOGRAPHIC MAPS AND SYMBOLS IS AVAILABLE ON REQUEST

KNOX, PA.  
NE/4 FOXBURG 15' QUADRANGLE  
N4107.5—W7930/7.5  
1963  
AMS 5066 II NE—SERIES V831

4-5.1