


5667 I SE  
(TROY)

UNITED STATES  
DEPARTMENT OF THE INTERIOR  
GEOLOGICAL SURVEY

COMMONWEALTH OF PENNSYLVANIA  
DEPARTMENT OF ENVIRONMENTAL RESOURCES  
TOPOGRAPHIC AND GEOLOGIC SURVEY

LEROY QUADRANGLE  
PENNSYLVANIA—BRADFORD CO.  
7.5 MINUTE SERIES (TOPOGRAPHIC)  
NW/4 POWELL 15' QUADRANGLE

5667 I SE  
(TROY)

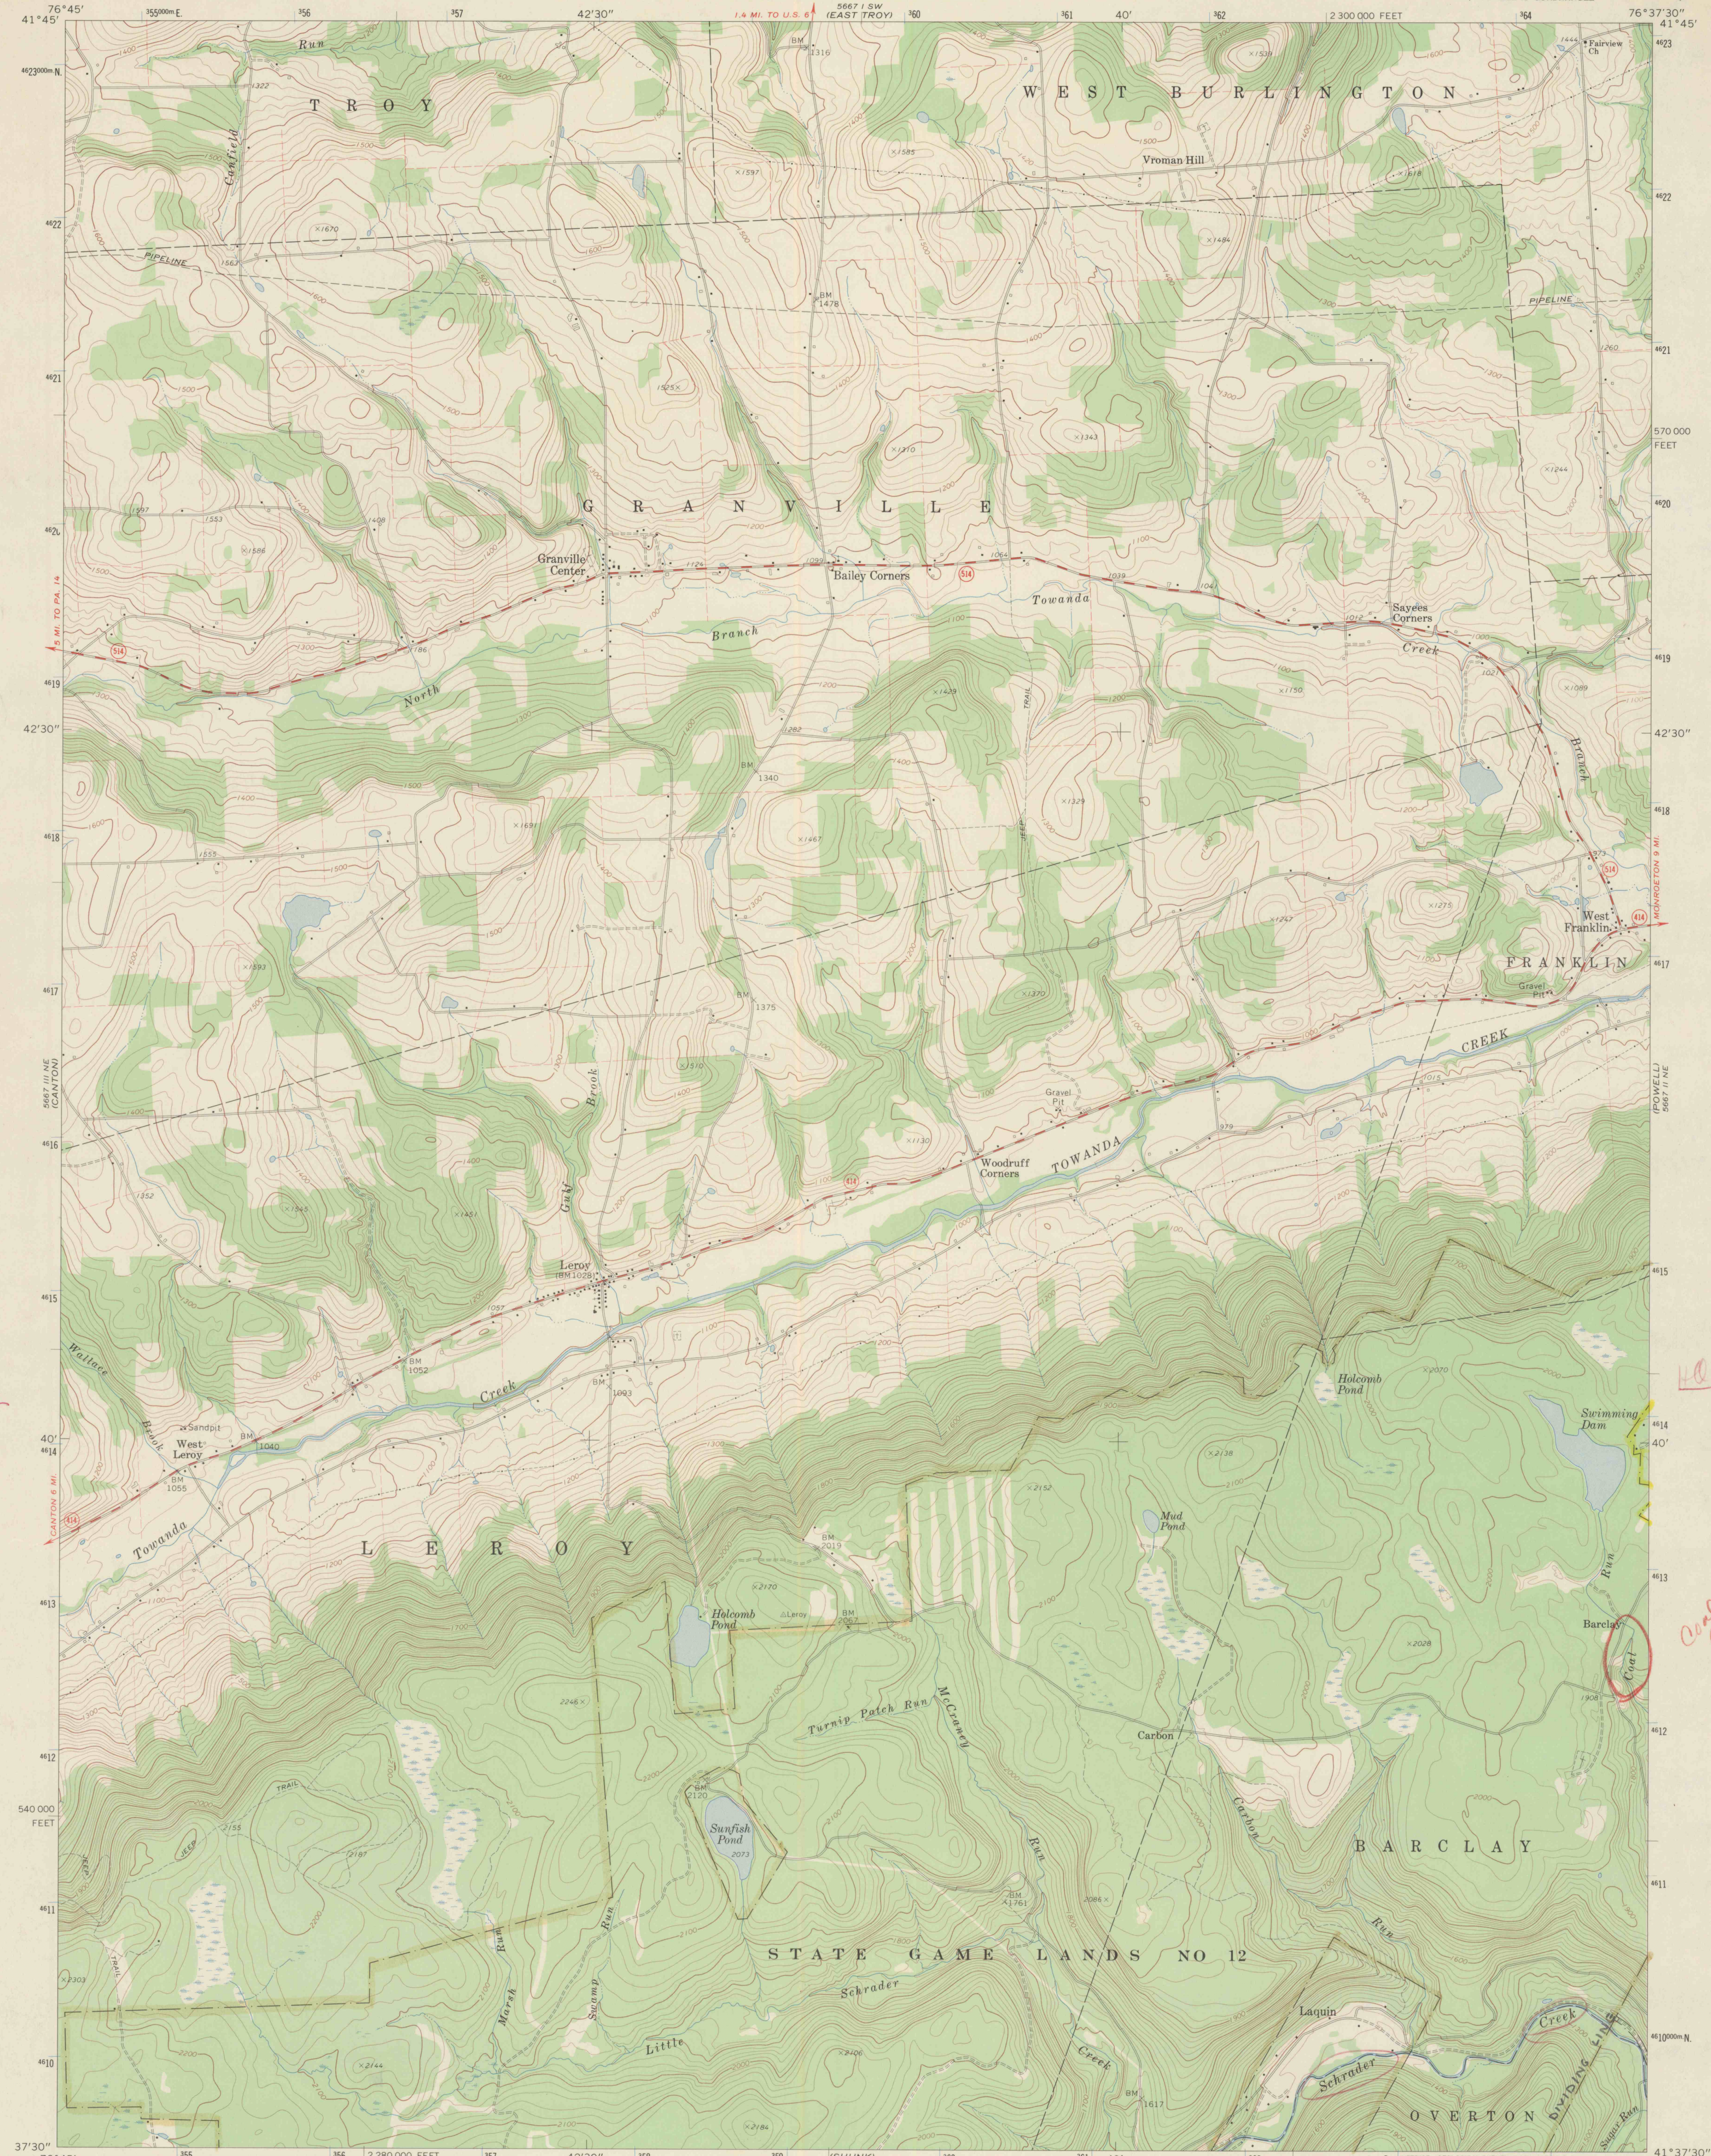

5667 I  
#12

HO Schuylkill

Coal Run  
- HQ


DRAWING NUMBER  
PLAN HOLD CORPORATION • BRIDGE, CALIFORNIA  
REPRODUCED BY NUMBER 07548

DRAWING NUMBER  
PLAN HOLD CORPORATION • BRIDGE, CALIFORNIA  
REPRODUCED BY NUMBER 07548

DRAWING NUMBER  
SAM/2-17.4  
PLAN HOLD CORPORATION • BRIDGE, CALIFORNIA  
REPRODUCED BY NUMBER 07548

Mapped, edited, and published by the Geological Survey  
Control by USGS and USC&GS  
Topography by photogrammetric methods from aerial photographs  
taken 1969. Field checked 1969.  
Polyconic projection. 1927 North American datum  
10,000-foot grid based on Pennsylvania coordinate system, north zone  
1000-meter Universal Transverse Mercator grid ticks,  
zone 18, shown in blue.  
Fine red dashed lines indicate selected fence and field lines where  
generally visible on aerial photographs. This information is unchecked

UTM GRID AND 1969 MAGNETIC NORTH  
DECLINATION AT CENTER OF SHEET

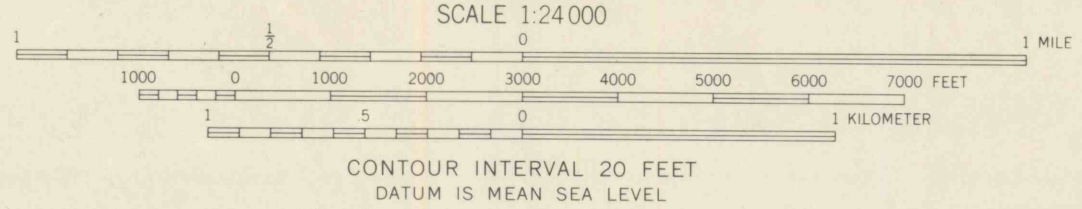

THIS MAP COMPLIES WITH NATIONAL MAP ACCURACY STANDARDS  
FOR SALE BY U. S. GEOLOGICAL SURVEY, WASHINGTON, D. C. 20242  
A FOLDER DESCRIBING TOPOGRAPHIC MAPS AND SYMBOLS IS AVAILABLE ON REQUEST

ROAD CLASSIFICATION  
Primary highway, hard surface  
Secondary highway, hard surface  
Unimproved road  
Interstate Route  
U. S. Route  
State Route

LEROY, PA.  
NW/4 POWELL 15' QUADRANGLE  
N4137.5-W7637.5/7.5

1969  
AMS 5667 I NW—SERIES V831

2-17.4