


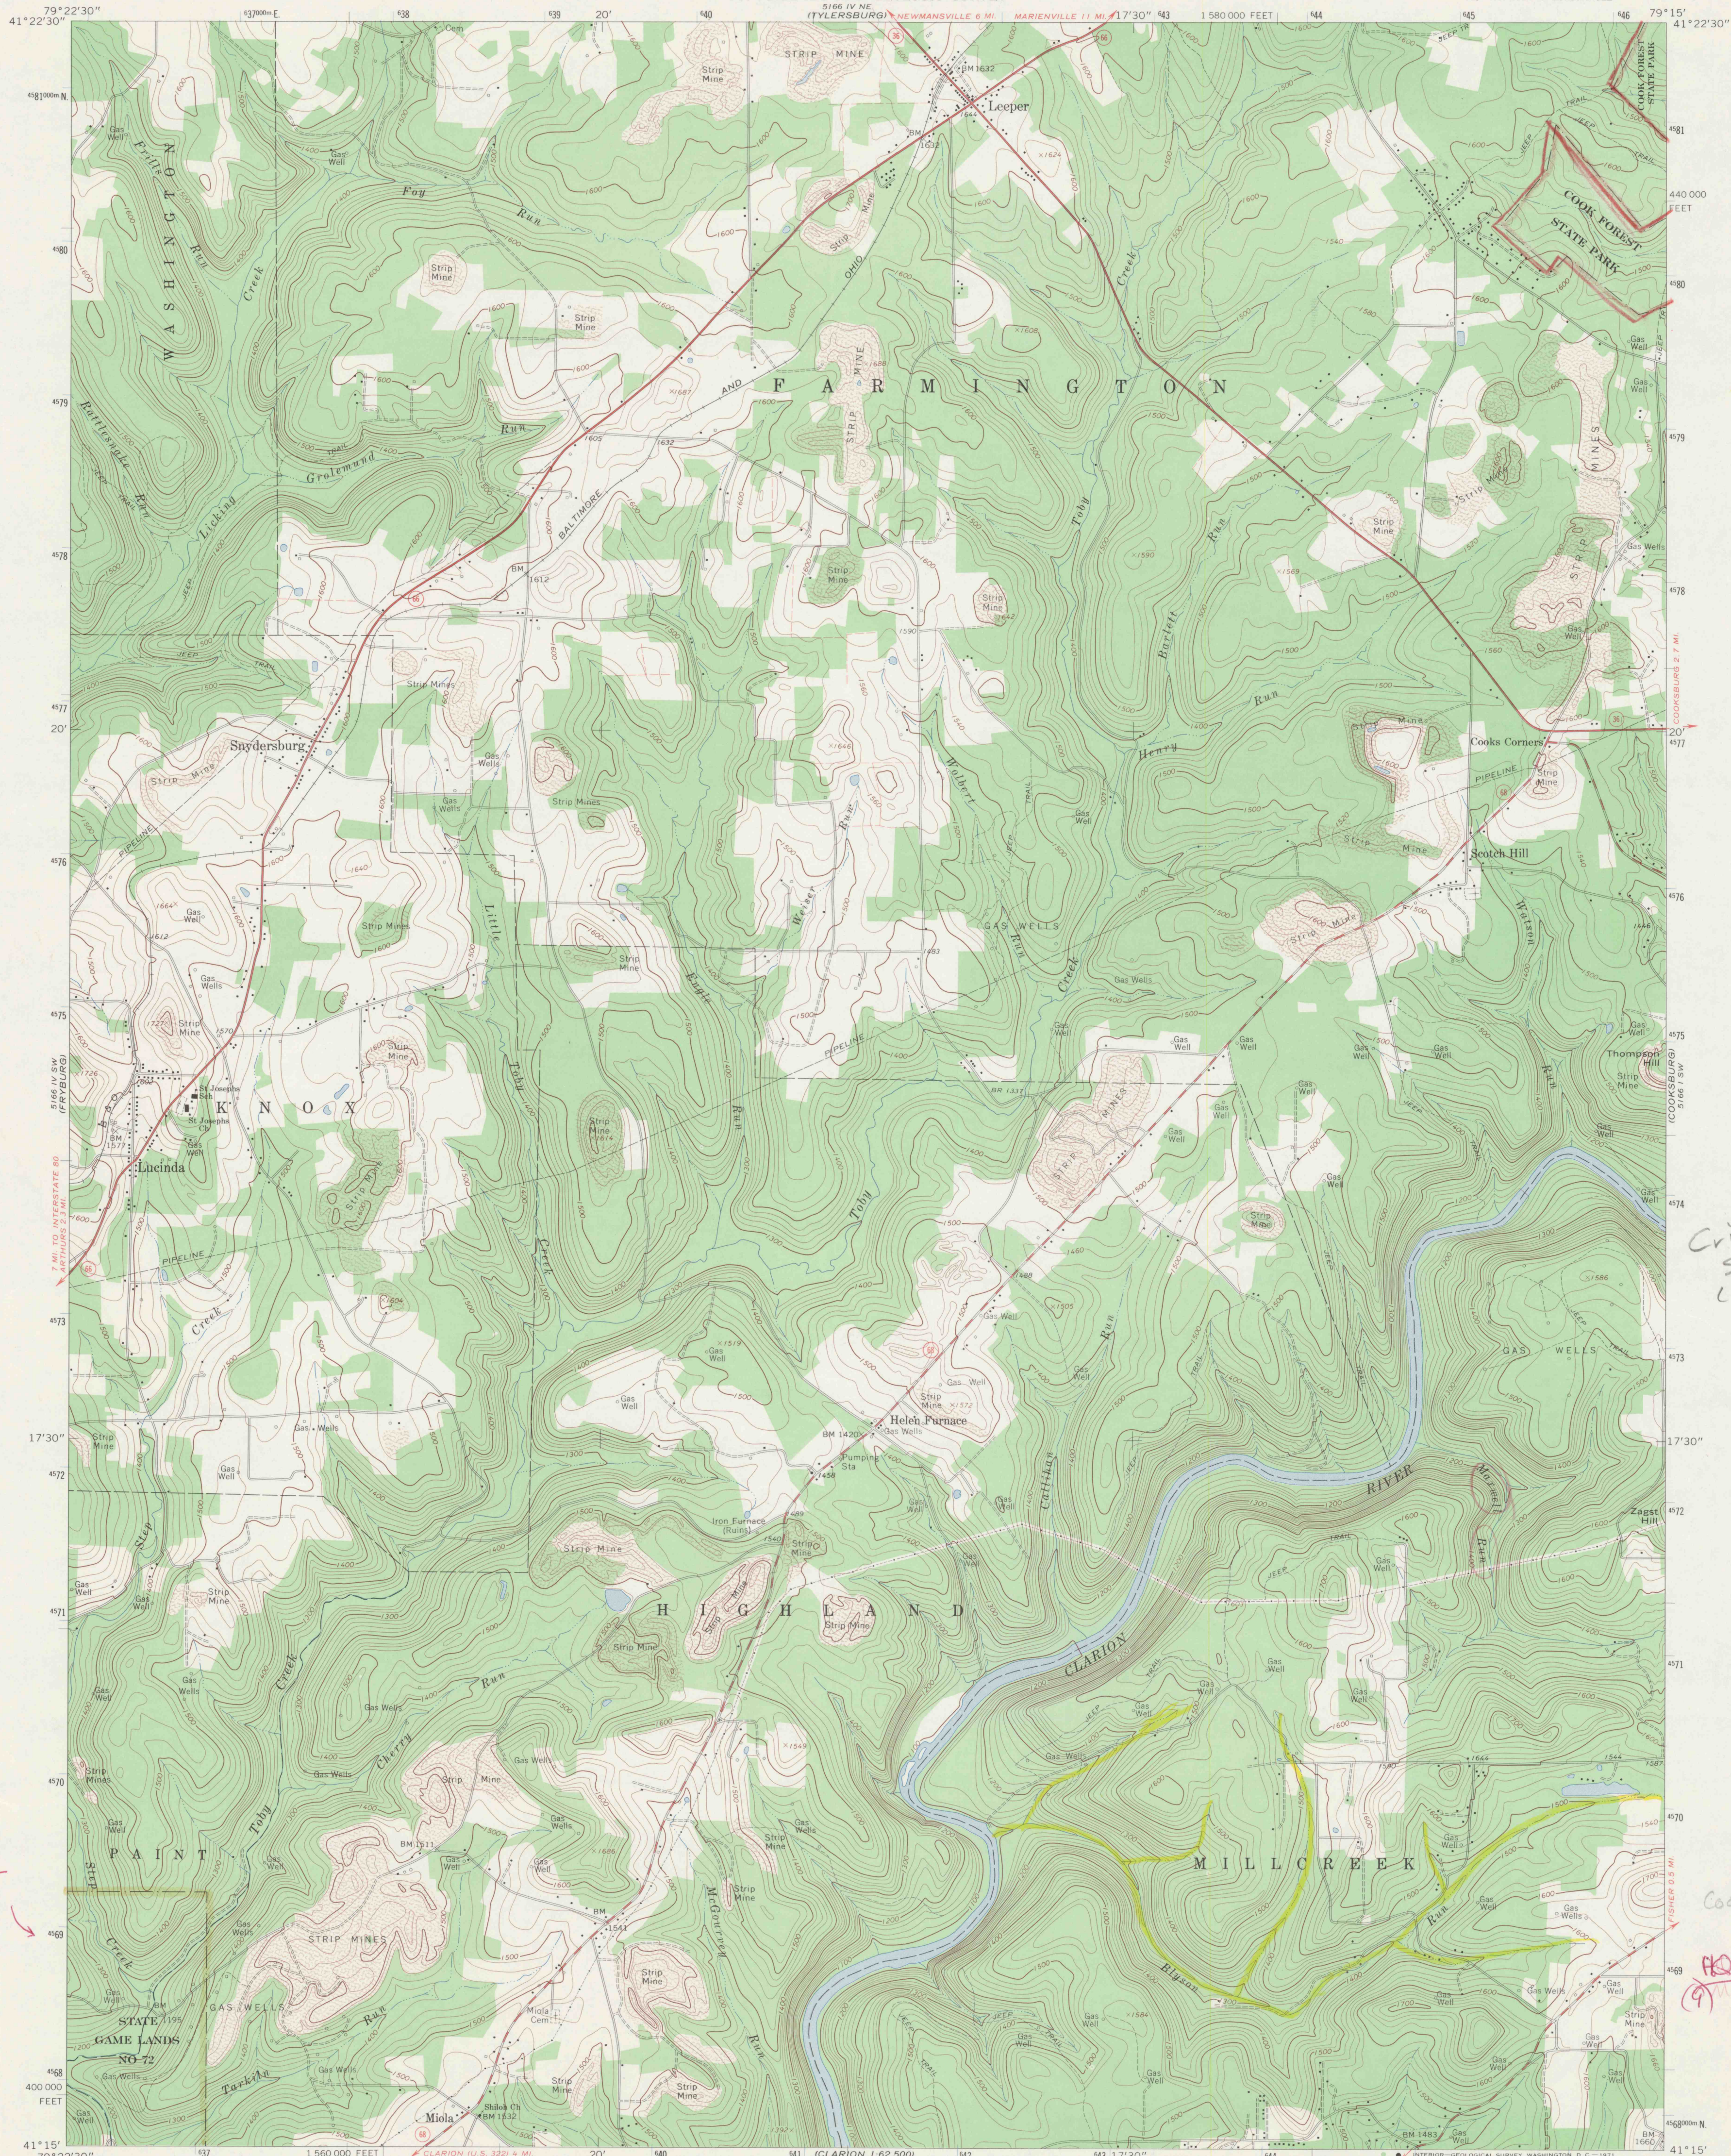

Cook Forest S.P.

E.V. Stream

Crit. Hab. #72
St. G.L. #72
(change left corner)

E.V. Blyson Run

Cook Forest S.P. OK

Stream
(Maxwell Run)

Mapped, edited, and published by the Geological Survey
Control by USGS and USC&GS
Topography by photogrammetric methods from aerial photographs
taken 1967 and 1968. Field checked 1967
Polyconic projection. 1927 North American datum
10,000-foot grid based on Pennsylvania coordinate system, north zone
1000-meter Universal Transverse Mercator grid ticks, zone 17,
shown in blue
Fine red dashed lines indicate selected fence and field lines where
generally visible on aerial photographs. This information is unchecked

UTM GRID AND 1967 MAGNETIC NORTH
DECLINATION AT CENTER OF SHEET

SCALE 1:24,000
CONTOUR INTERVAL 20 FEET
DATUM IS MEAN SEA LEVEL

ROAD CLASSIFICATION
Primary highway, all weather, light-duty road, all weather,
hard surface improved surface
Secondary highway, all weather, Unimproved road, fair or dry
hard surface weather
State Route

LUCINDA, PA.
SE/4 TIONESTA 15' QUADRANGLE
N4115—W7915/7.5

1967

AMS 5166 IV SE—SERIES V831

DRAWING NUMBER

DRAWING NUMBER

DRAWING NUMBER

SAM 3-6.2

0811

3-6.2