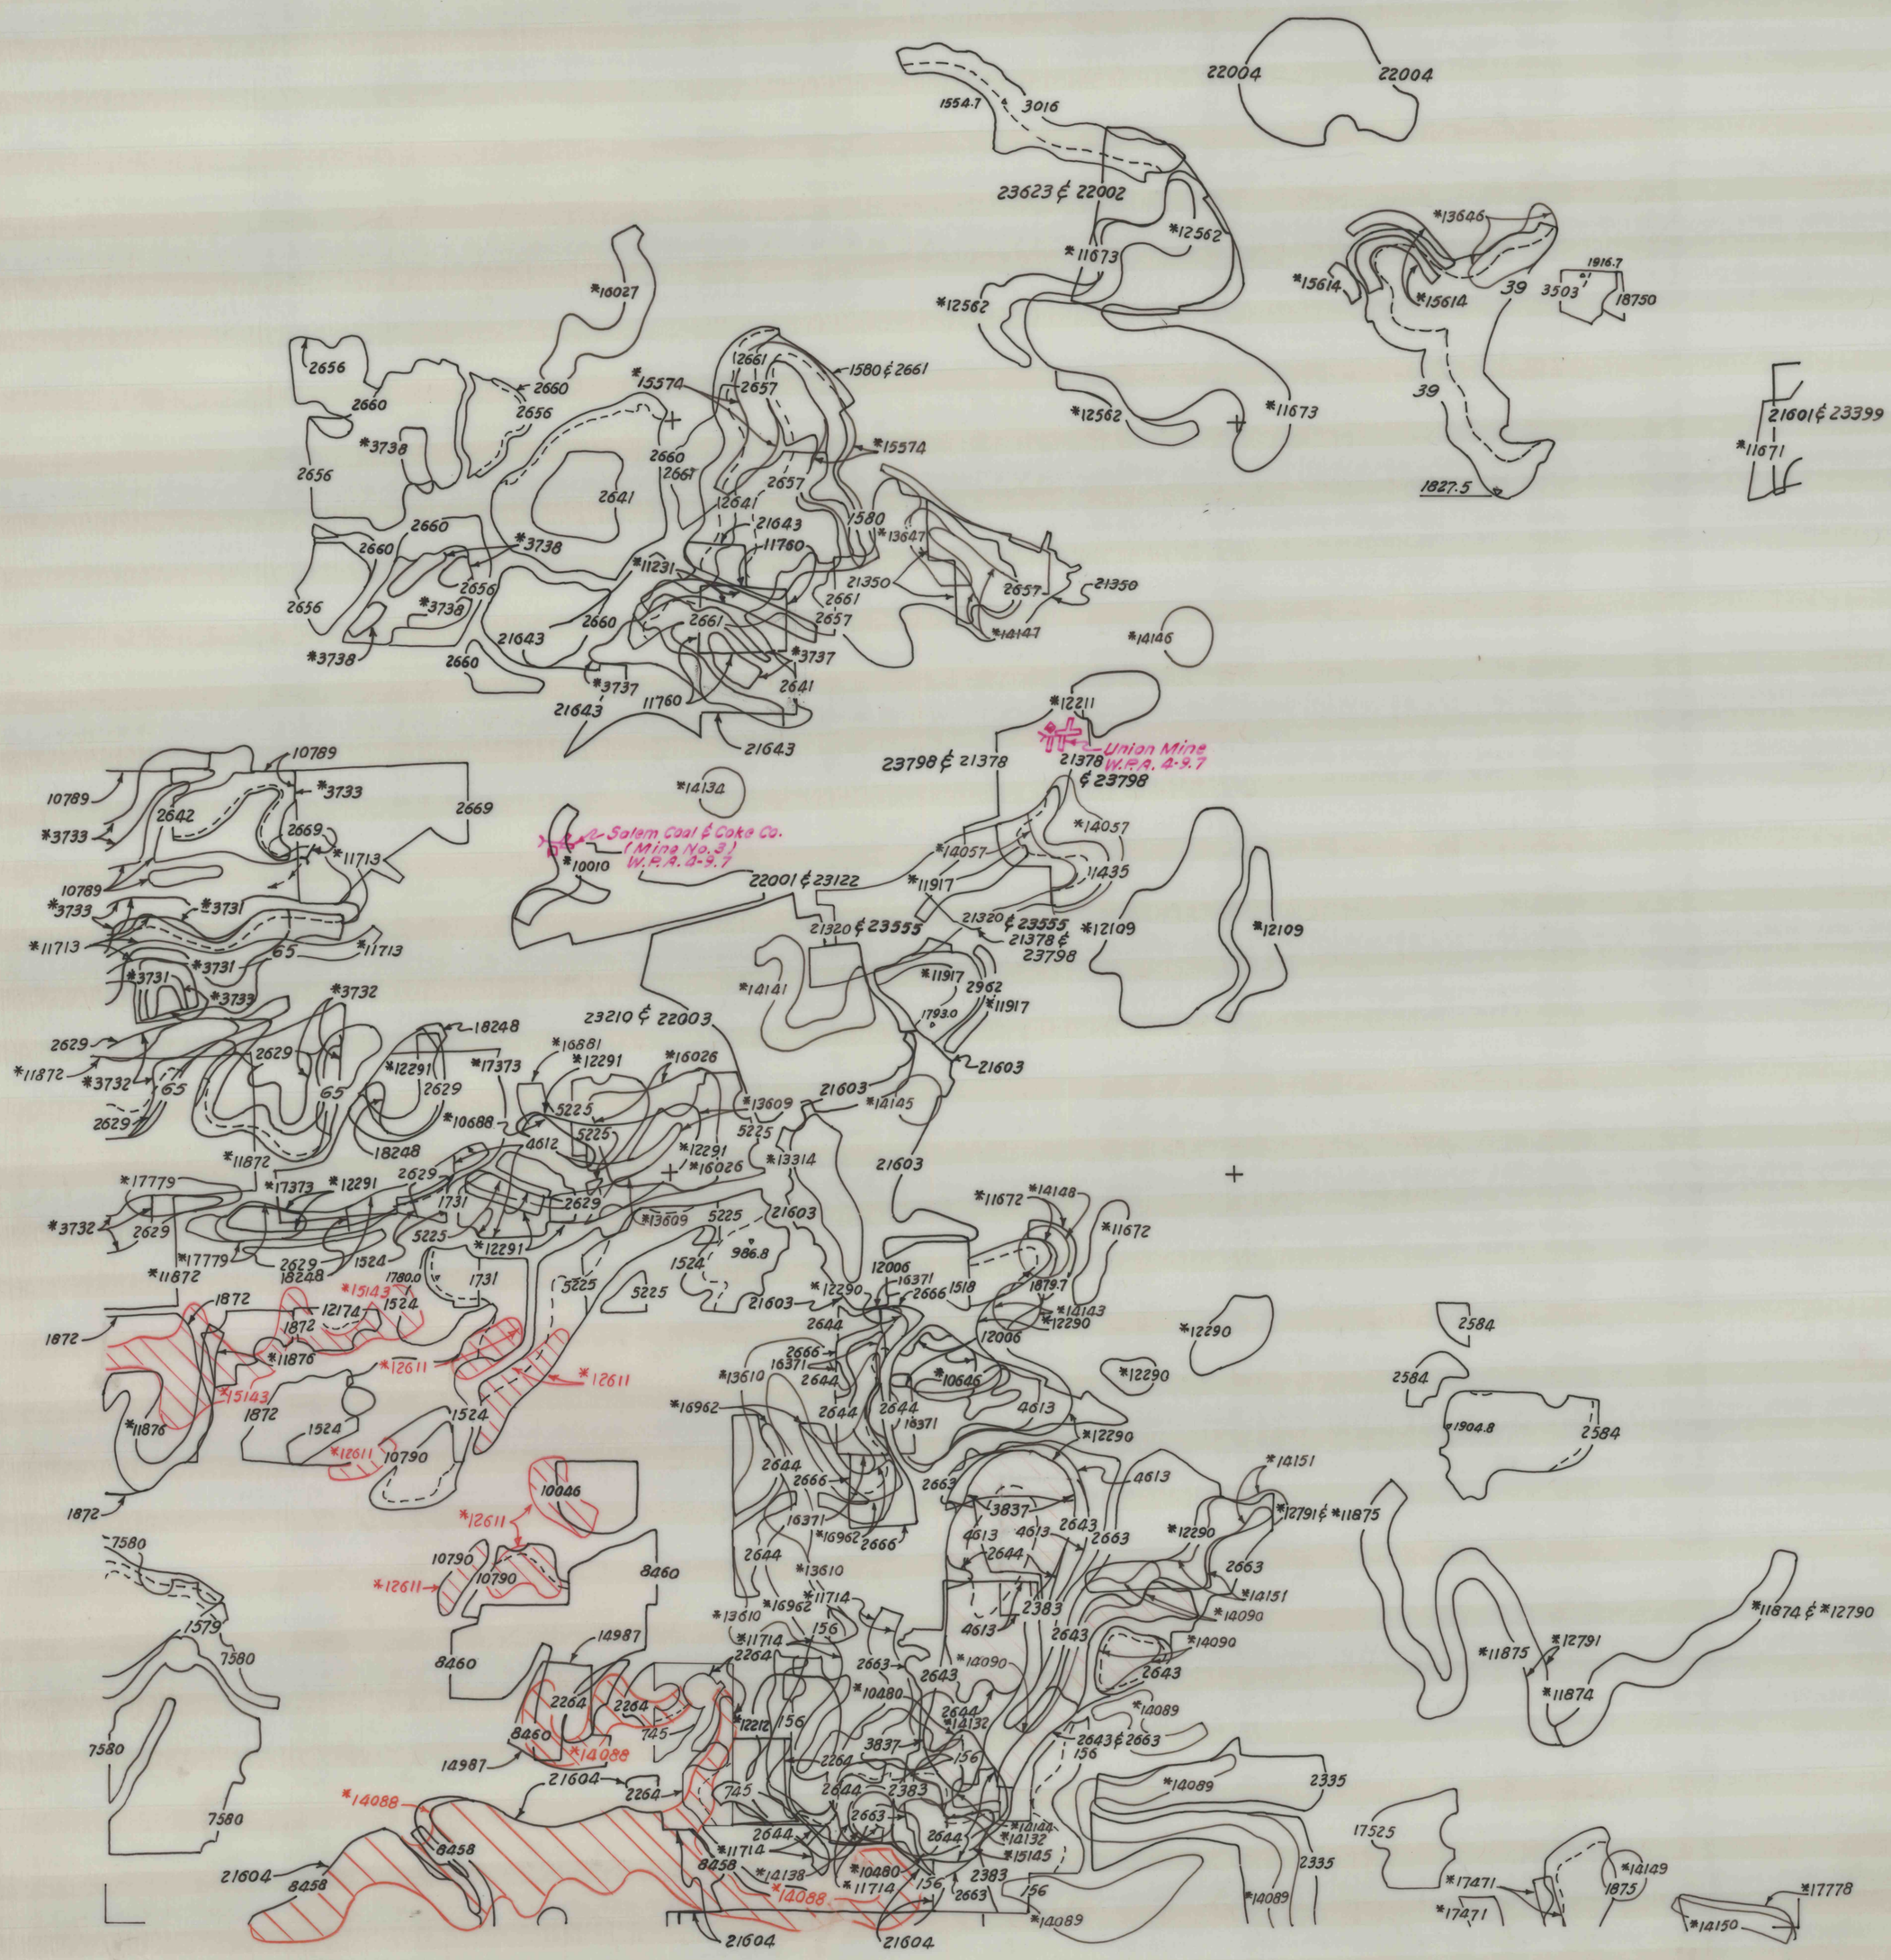

C14-9.3 (Sheet 1 of 2)
1016

DRAWING NUMBER
C14-9.3
1016

PLAN HOLD CORPORATION • IRVINE, CALIFORNIA
REORDER BY NUMBER 07249
TRACING SIZE OF PAPER 24 INCHES