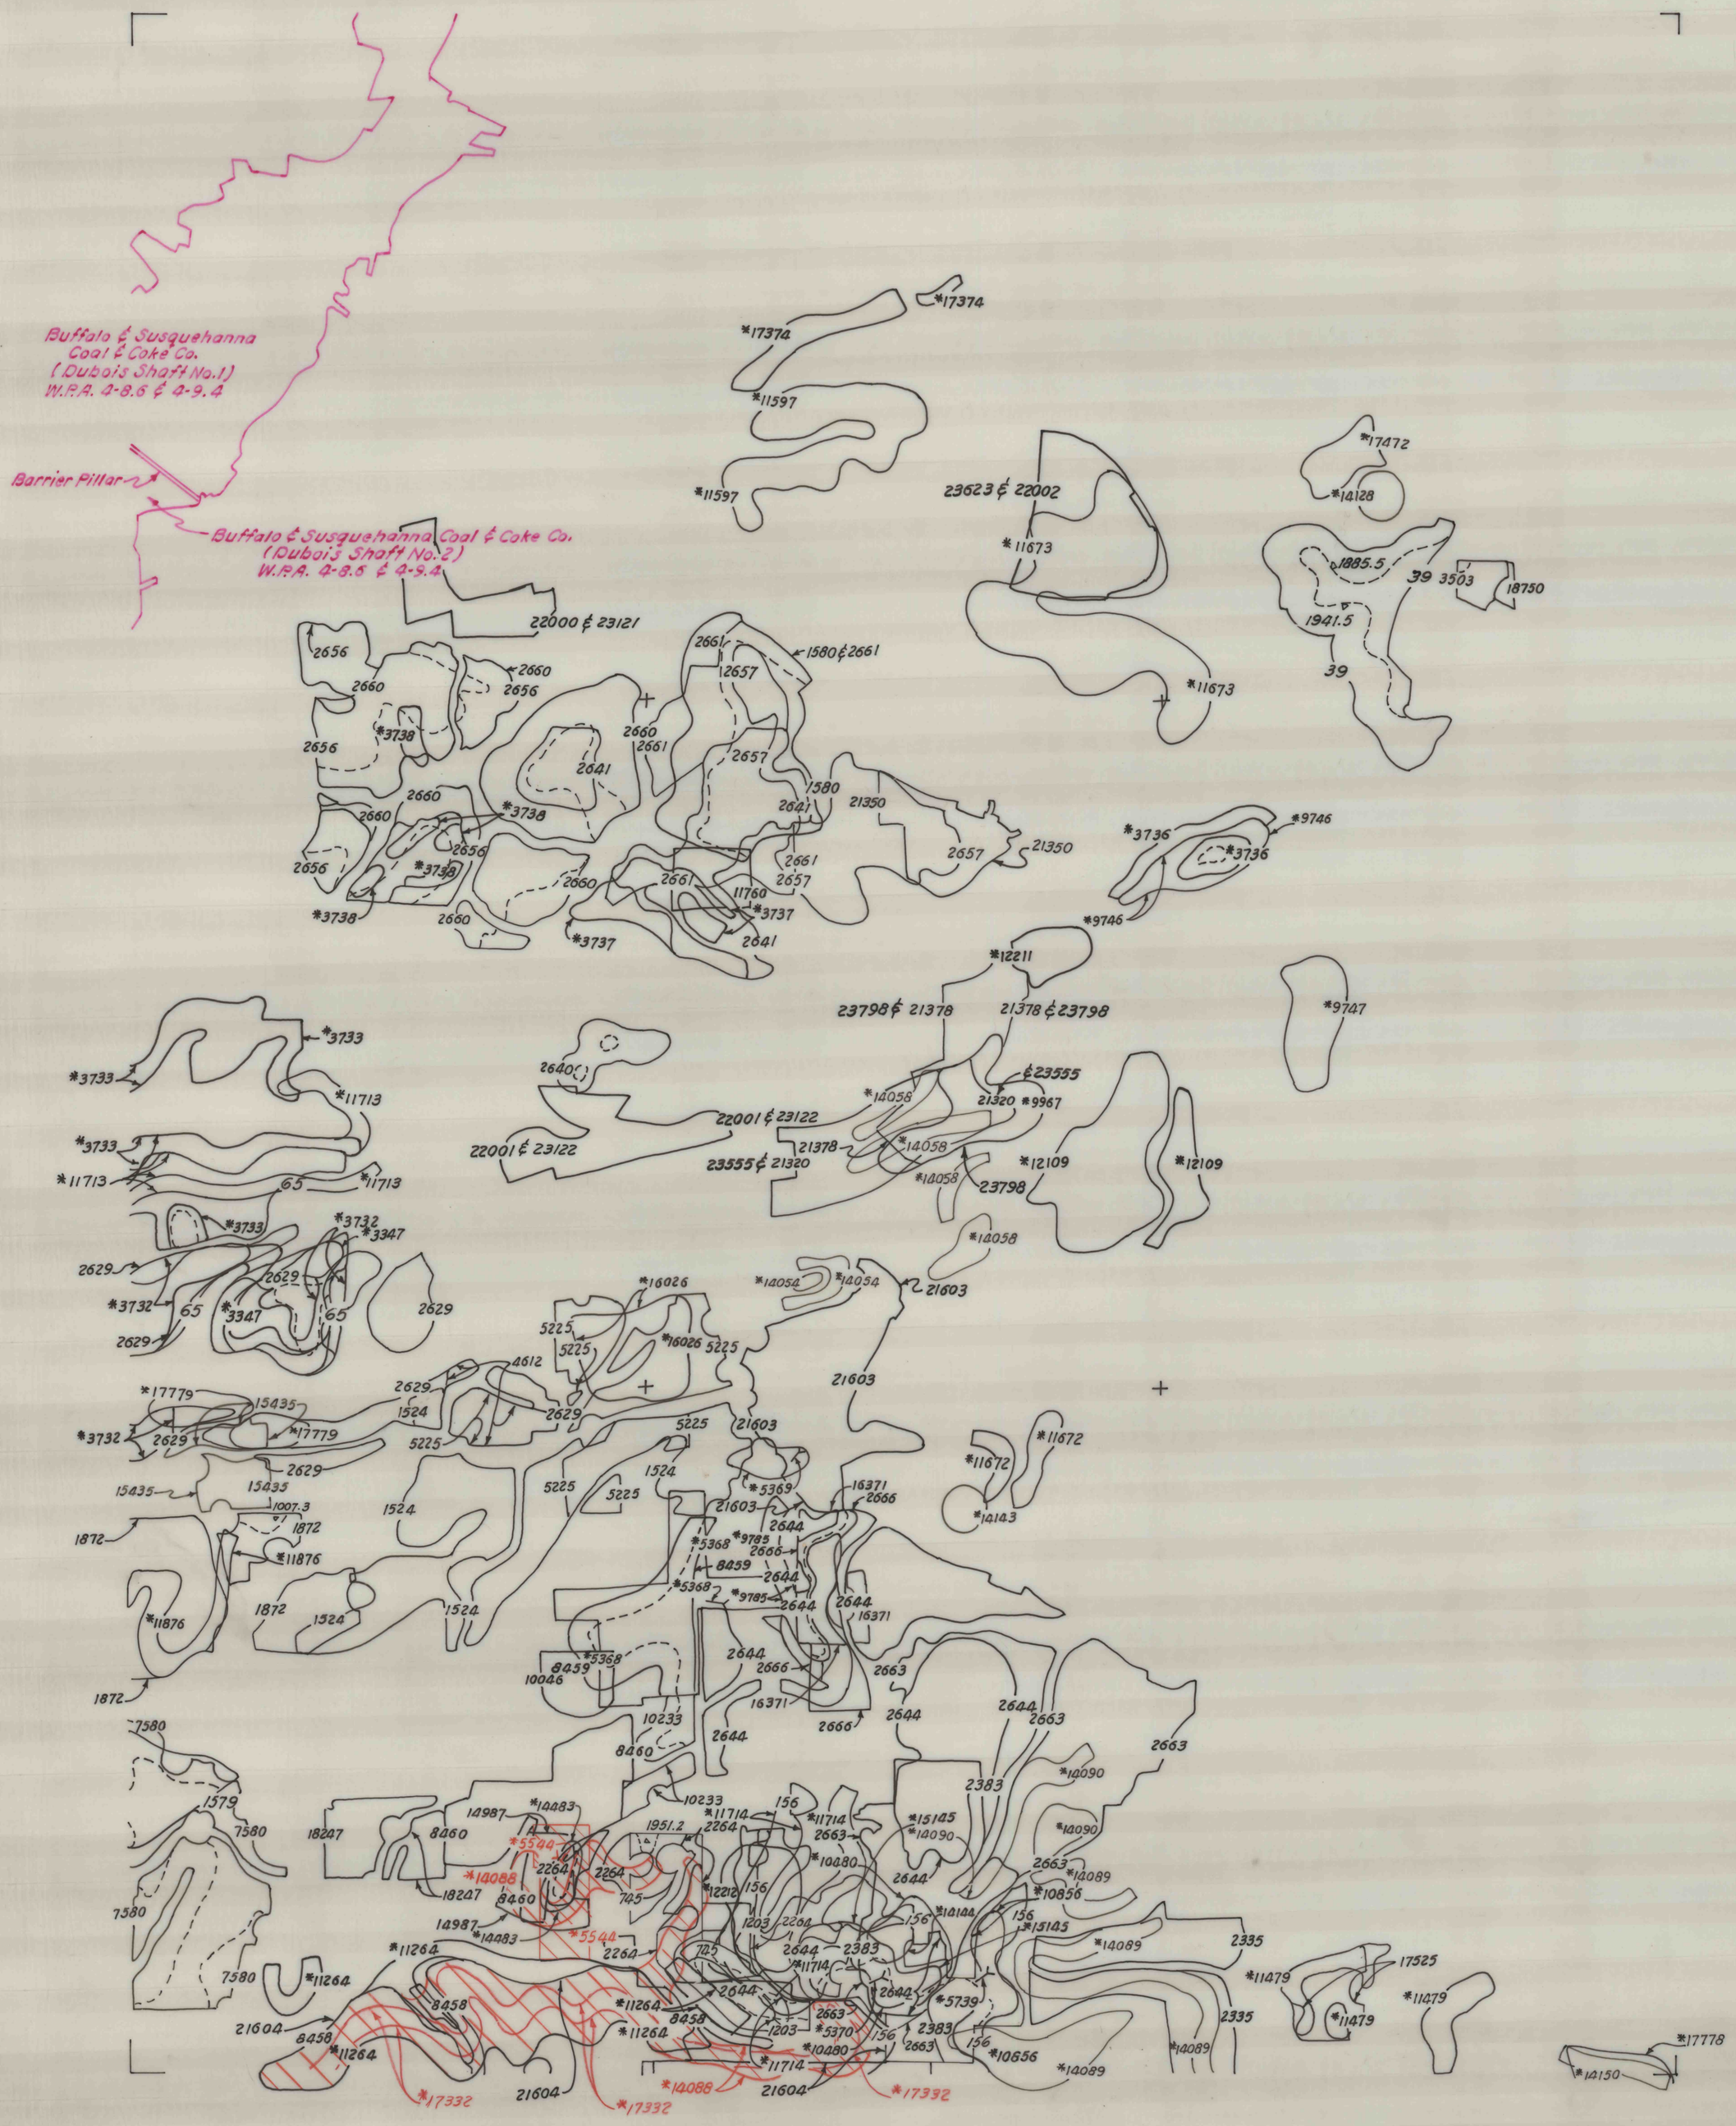

D/4-9.3
1016 (Sheet 1 of 2)

DRAWING NUMBER
D/4-9.3
1016

PLAN HOLD CORPORATION • IRVINE, CALIFORNIA