



PLAN HOLD



PEEL PROTECTIVE STRIP TO EXPOSE ADHESIVE. POSITION EDGE OF PRINT ON THIS LINE AND RUB TO ADHERE.

PLAN HOLD CORPORATION IRVINE CALIFORNIA
REORDER BY NO. 0783424

DRAWING NUMBER
D/4-9.3

1016

D/4-9.3 (Sheet 2 of 2)
1016

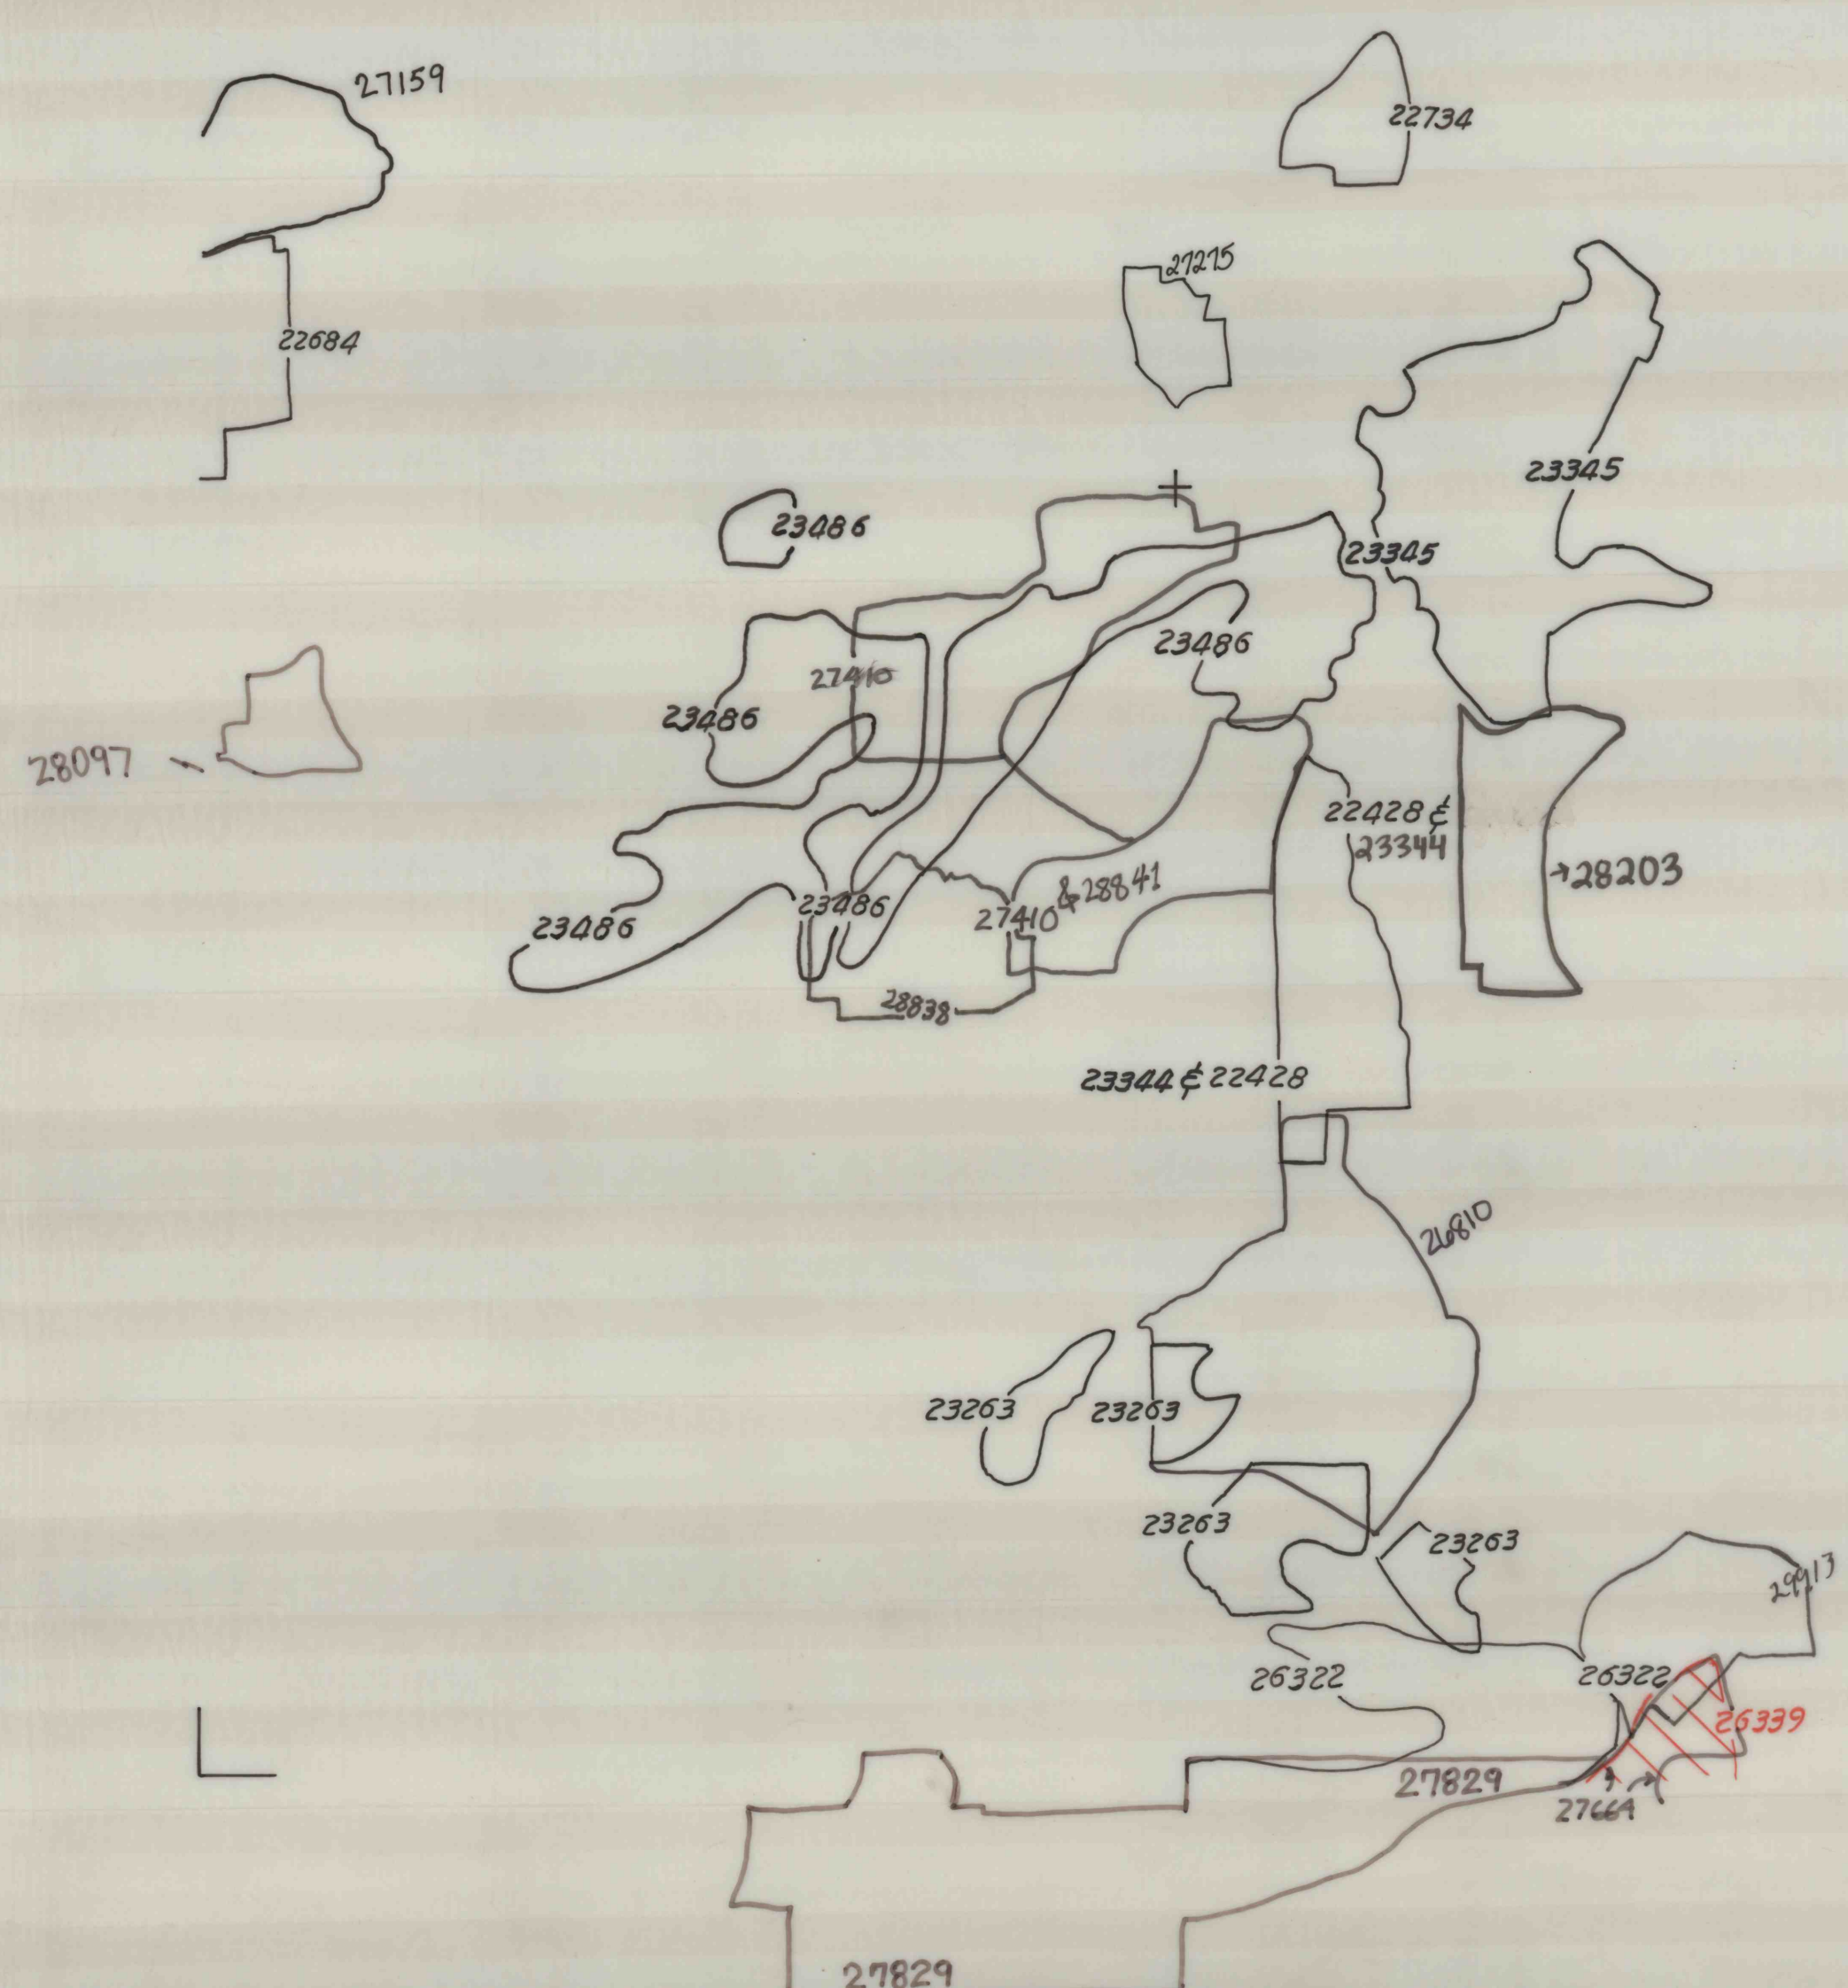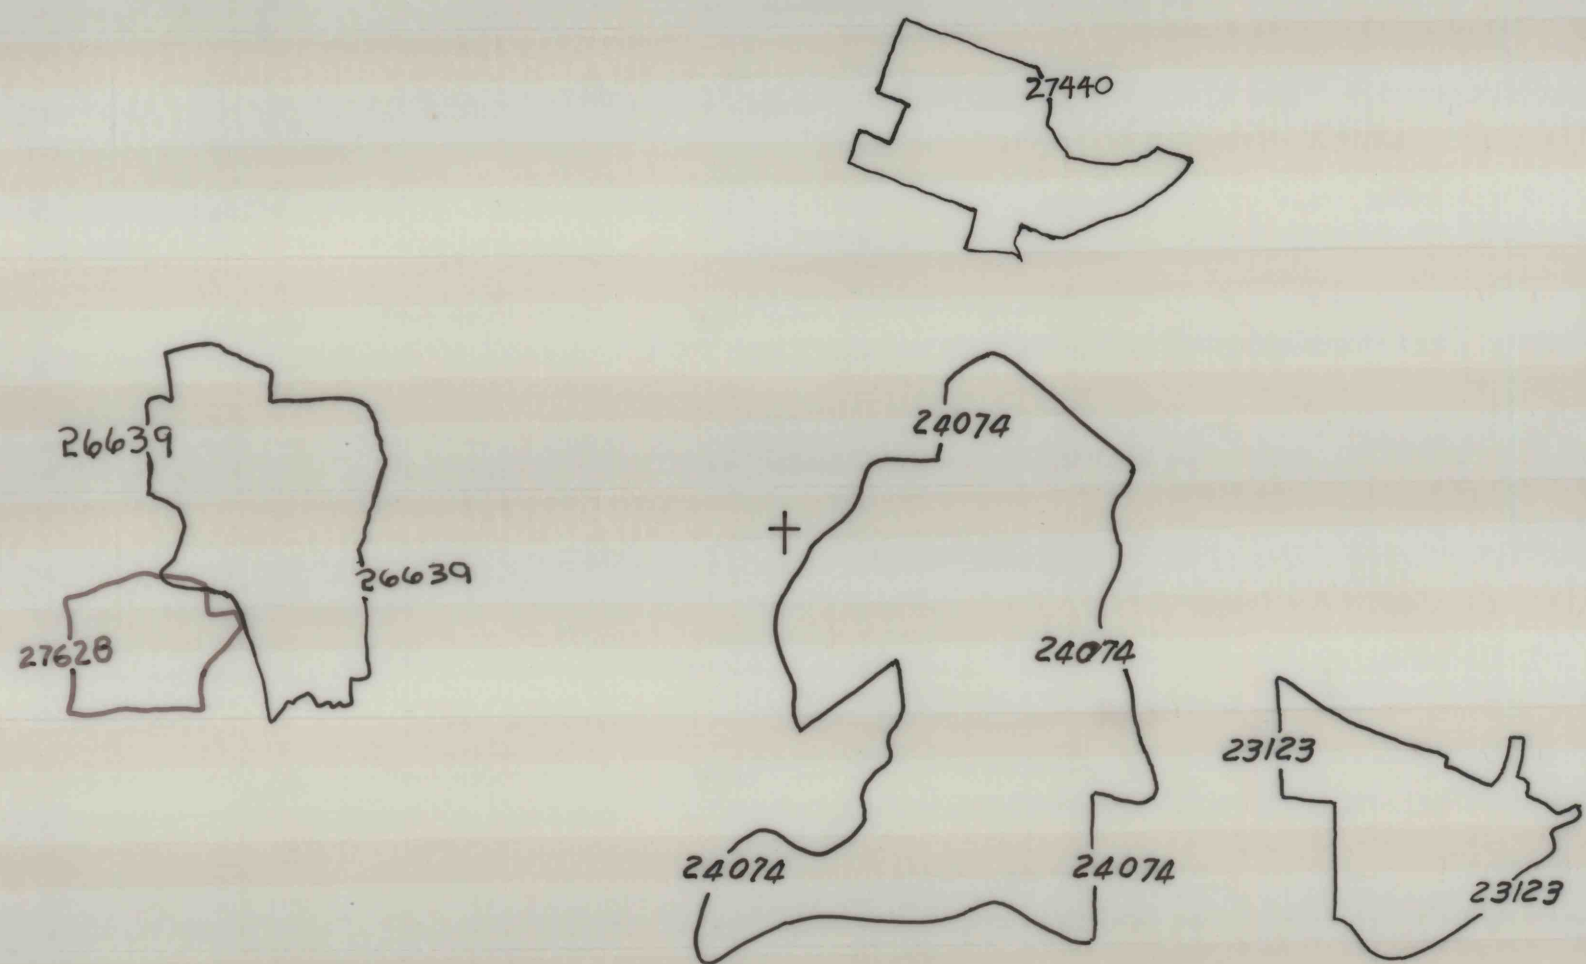

23021