




Streams Update  
8/22/97

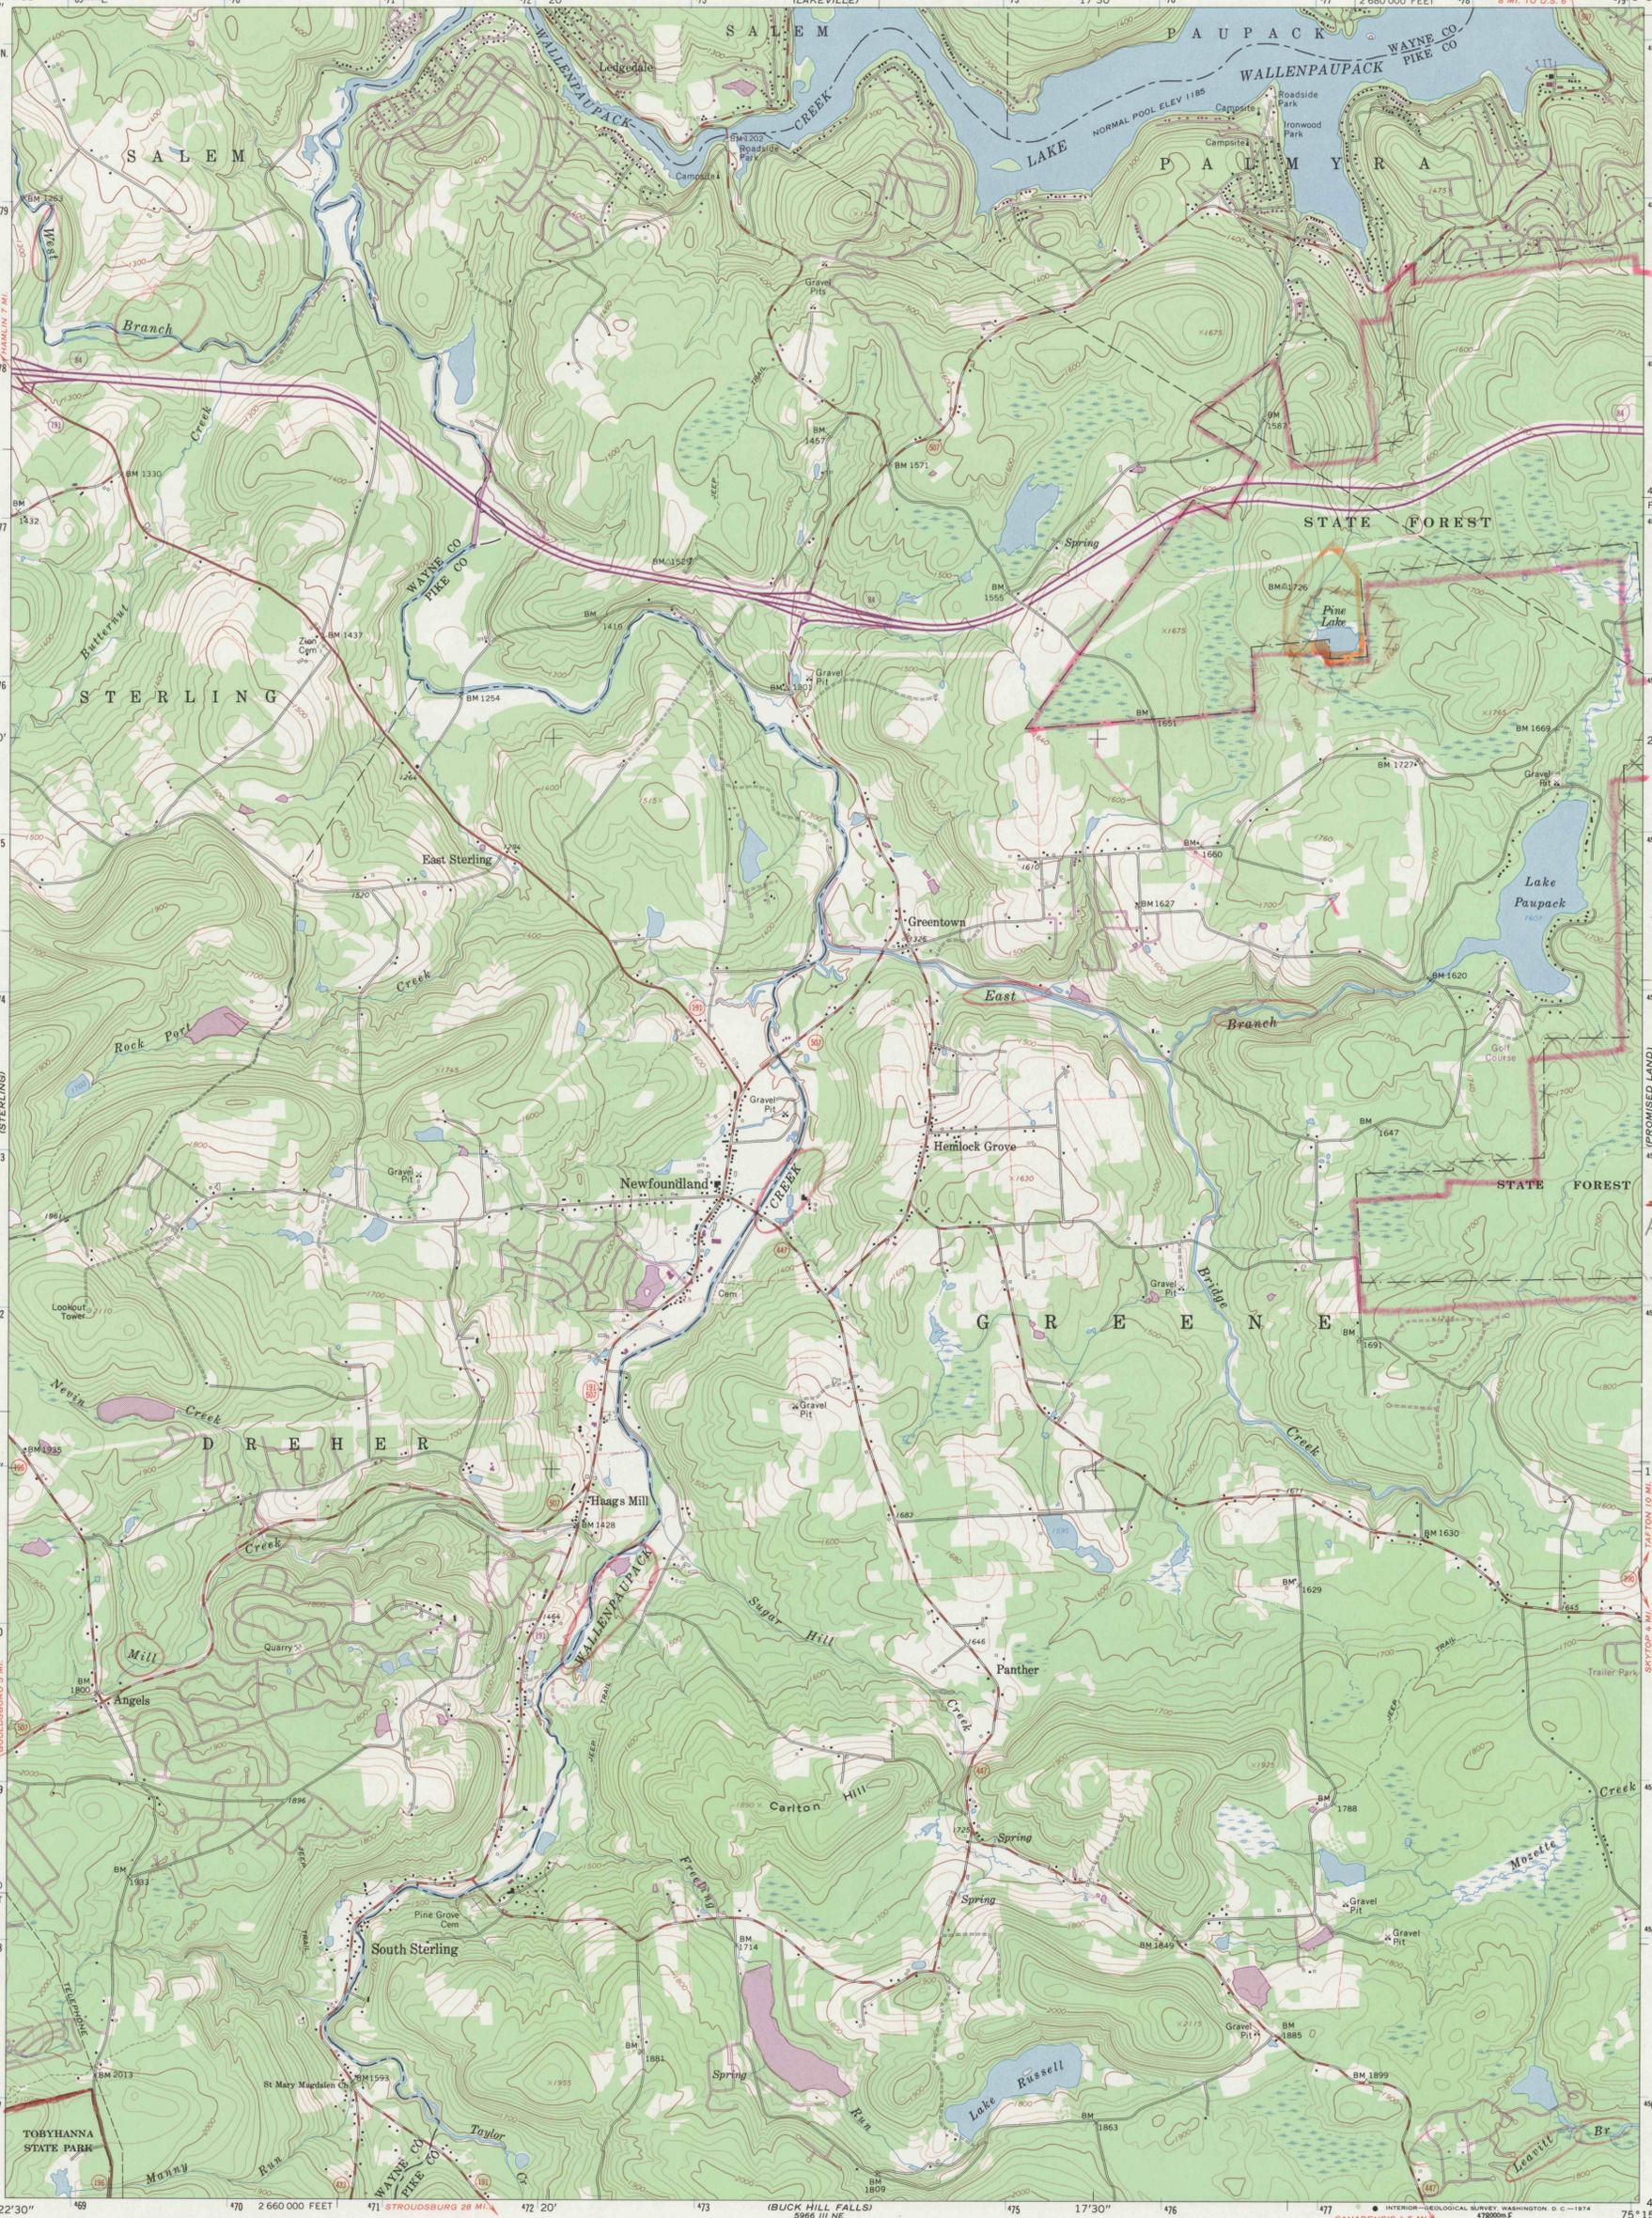

Wallenpaupack Creek  
Basin  
HQ-CWF  
is source to Lake  
Wallenpaupack Dam

STATE FOREST  
7 TOBYHANNA  
STATE PARK  
PINE LAKE  
NATURAL AREA  
HQ STREAMS  
ALL DEL.  
RIVER TRIPS,  
EXCEPT DEL  
RIVER

Mapped, edited, and published by the Geological Survey  
Control by USGS and US&GS  
Topography by photogrammetric methods from aerial photographs  
taken 1963. Field checked 1966  
Polyconic projection. 1927 North American datum  
10,000-foot grid based on Pennsylvania coordinate system, north zone  
1000-meter Universal Transverse Mercator grid ticks, zone 18,  
shown in blue  
Fine red dashed lines indicate selected fence and field lines where  
generally visible on aerial photographs. This information is un-checked  
Revisions shown in purple compiled in cooperation with  
State of Pennsylvania agencies from aerial photographs  
taken 1973. This information not field checked

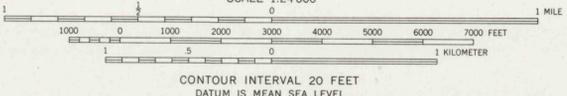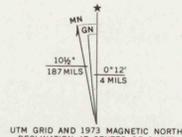

CONTOUR INTERVAL 20 FEET  
DATUM IS MEAN SEA LEVEL



ROAD CLASSIFICATION

Heavy-duty	Light-duty
Medium-duty	Unimproved dirt

State Route  
Interstate Route

NEWFOUNDLAND, PA.  
N4115-W7515/7.5  
1966  
PHOTOREVISED 1973  
AMS 5966 IV SE-SERIES V831

DRAWING NUMBER

DRAWING NUMBER

DRAWING NUMBER  
SPM 8-22.2

3-22.2