



PEEL PROTECTIVE STRIP TO EXPOSE ADHESIVE. POSITION EDGE OF PRINT ON THIS LINE AND RUB TO ADHERE

NONCOAL


DRAWING NUMBER
MISC./3-21.1

PLAN HOLD CORPORATION IRVINE CALIFORNIA
REORDER BY NO. 070SA-24

REORDER BY NO. 07USA-24

WINE CALIFORNIA

MISC./3-21.1 (Sheet 1 of 2)
REFUSE BREAKER ROCK
CINDERS & FINE COAL
0741

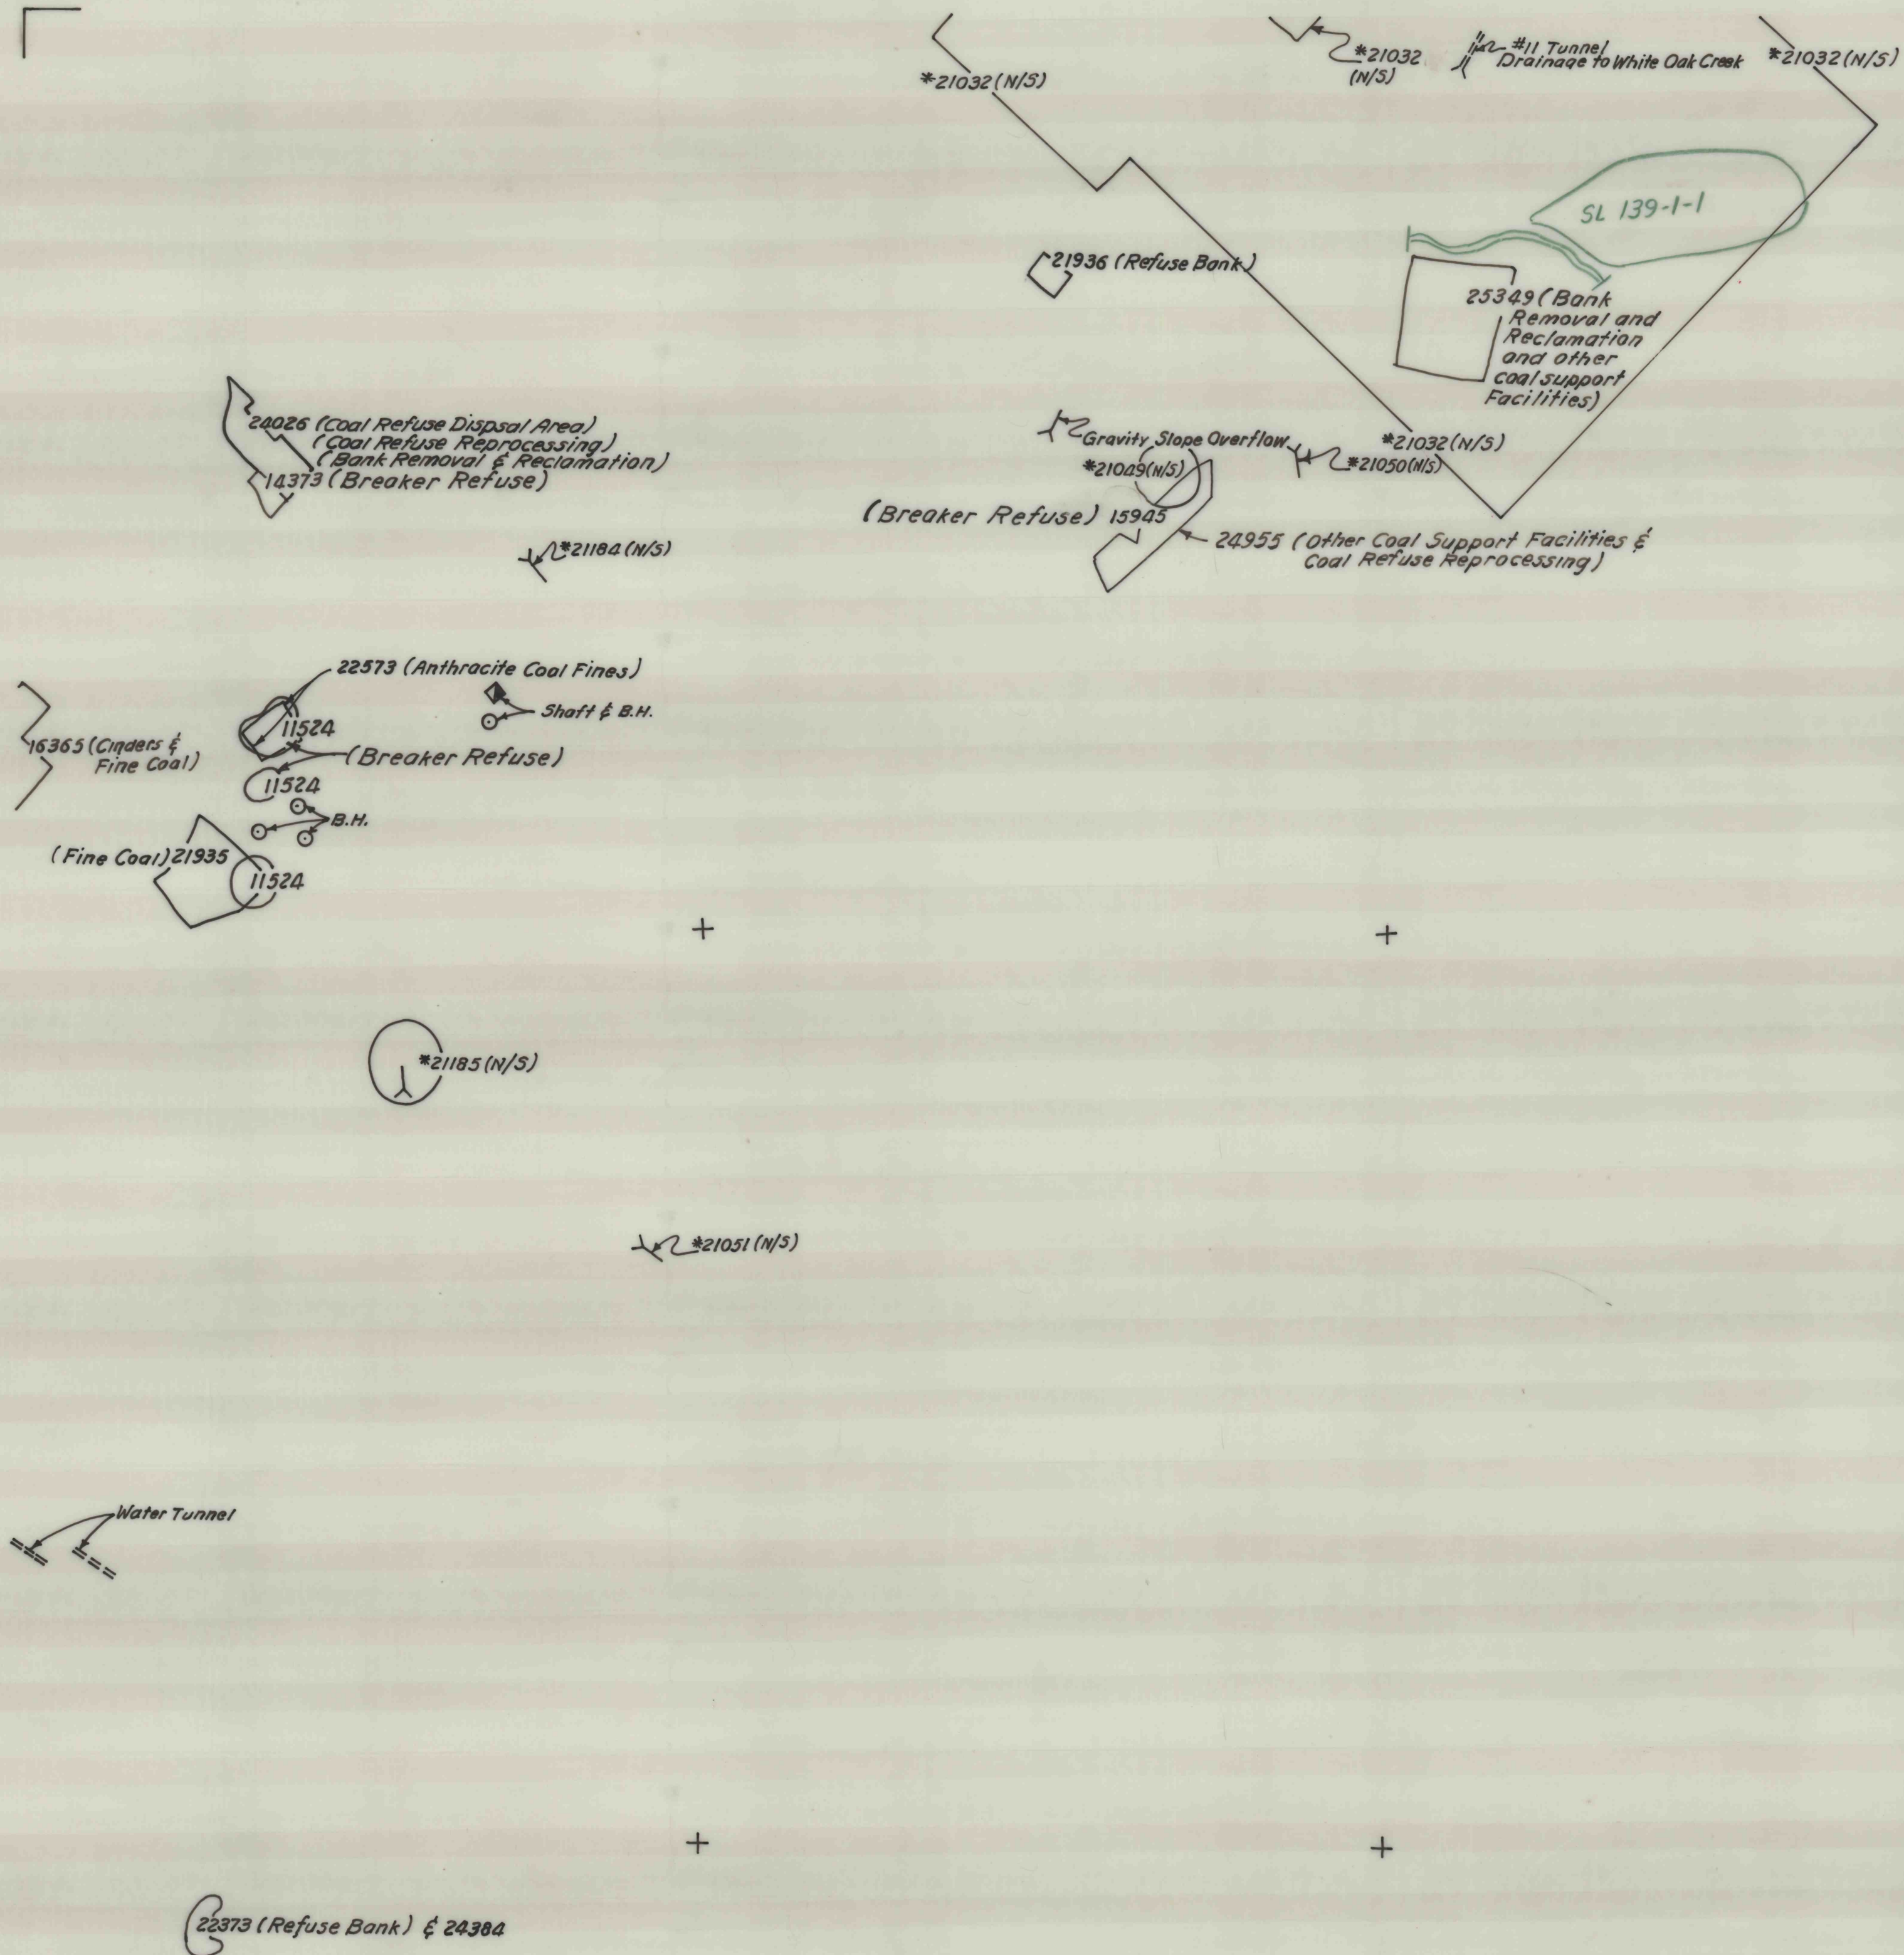

Shafts, B.H., Tunnels & Slopes from a 1952 Hudson Coal Co. Engineering Department Report.