DRAWING NUMBER
PLAN HOLD CORPORATION • IRVINE, CALIFORNIA
RECORDED BY NUMBER 07SAR

B/4-5.3
1008
COAL 107
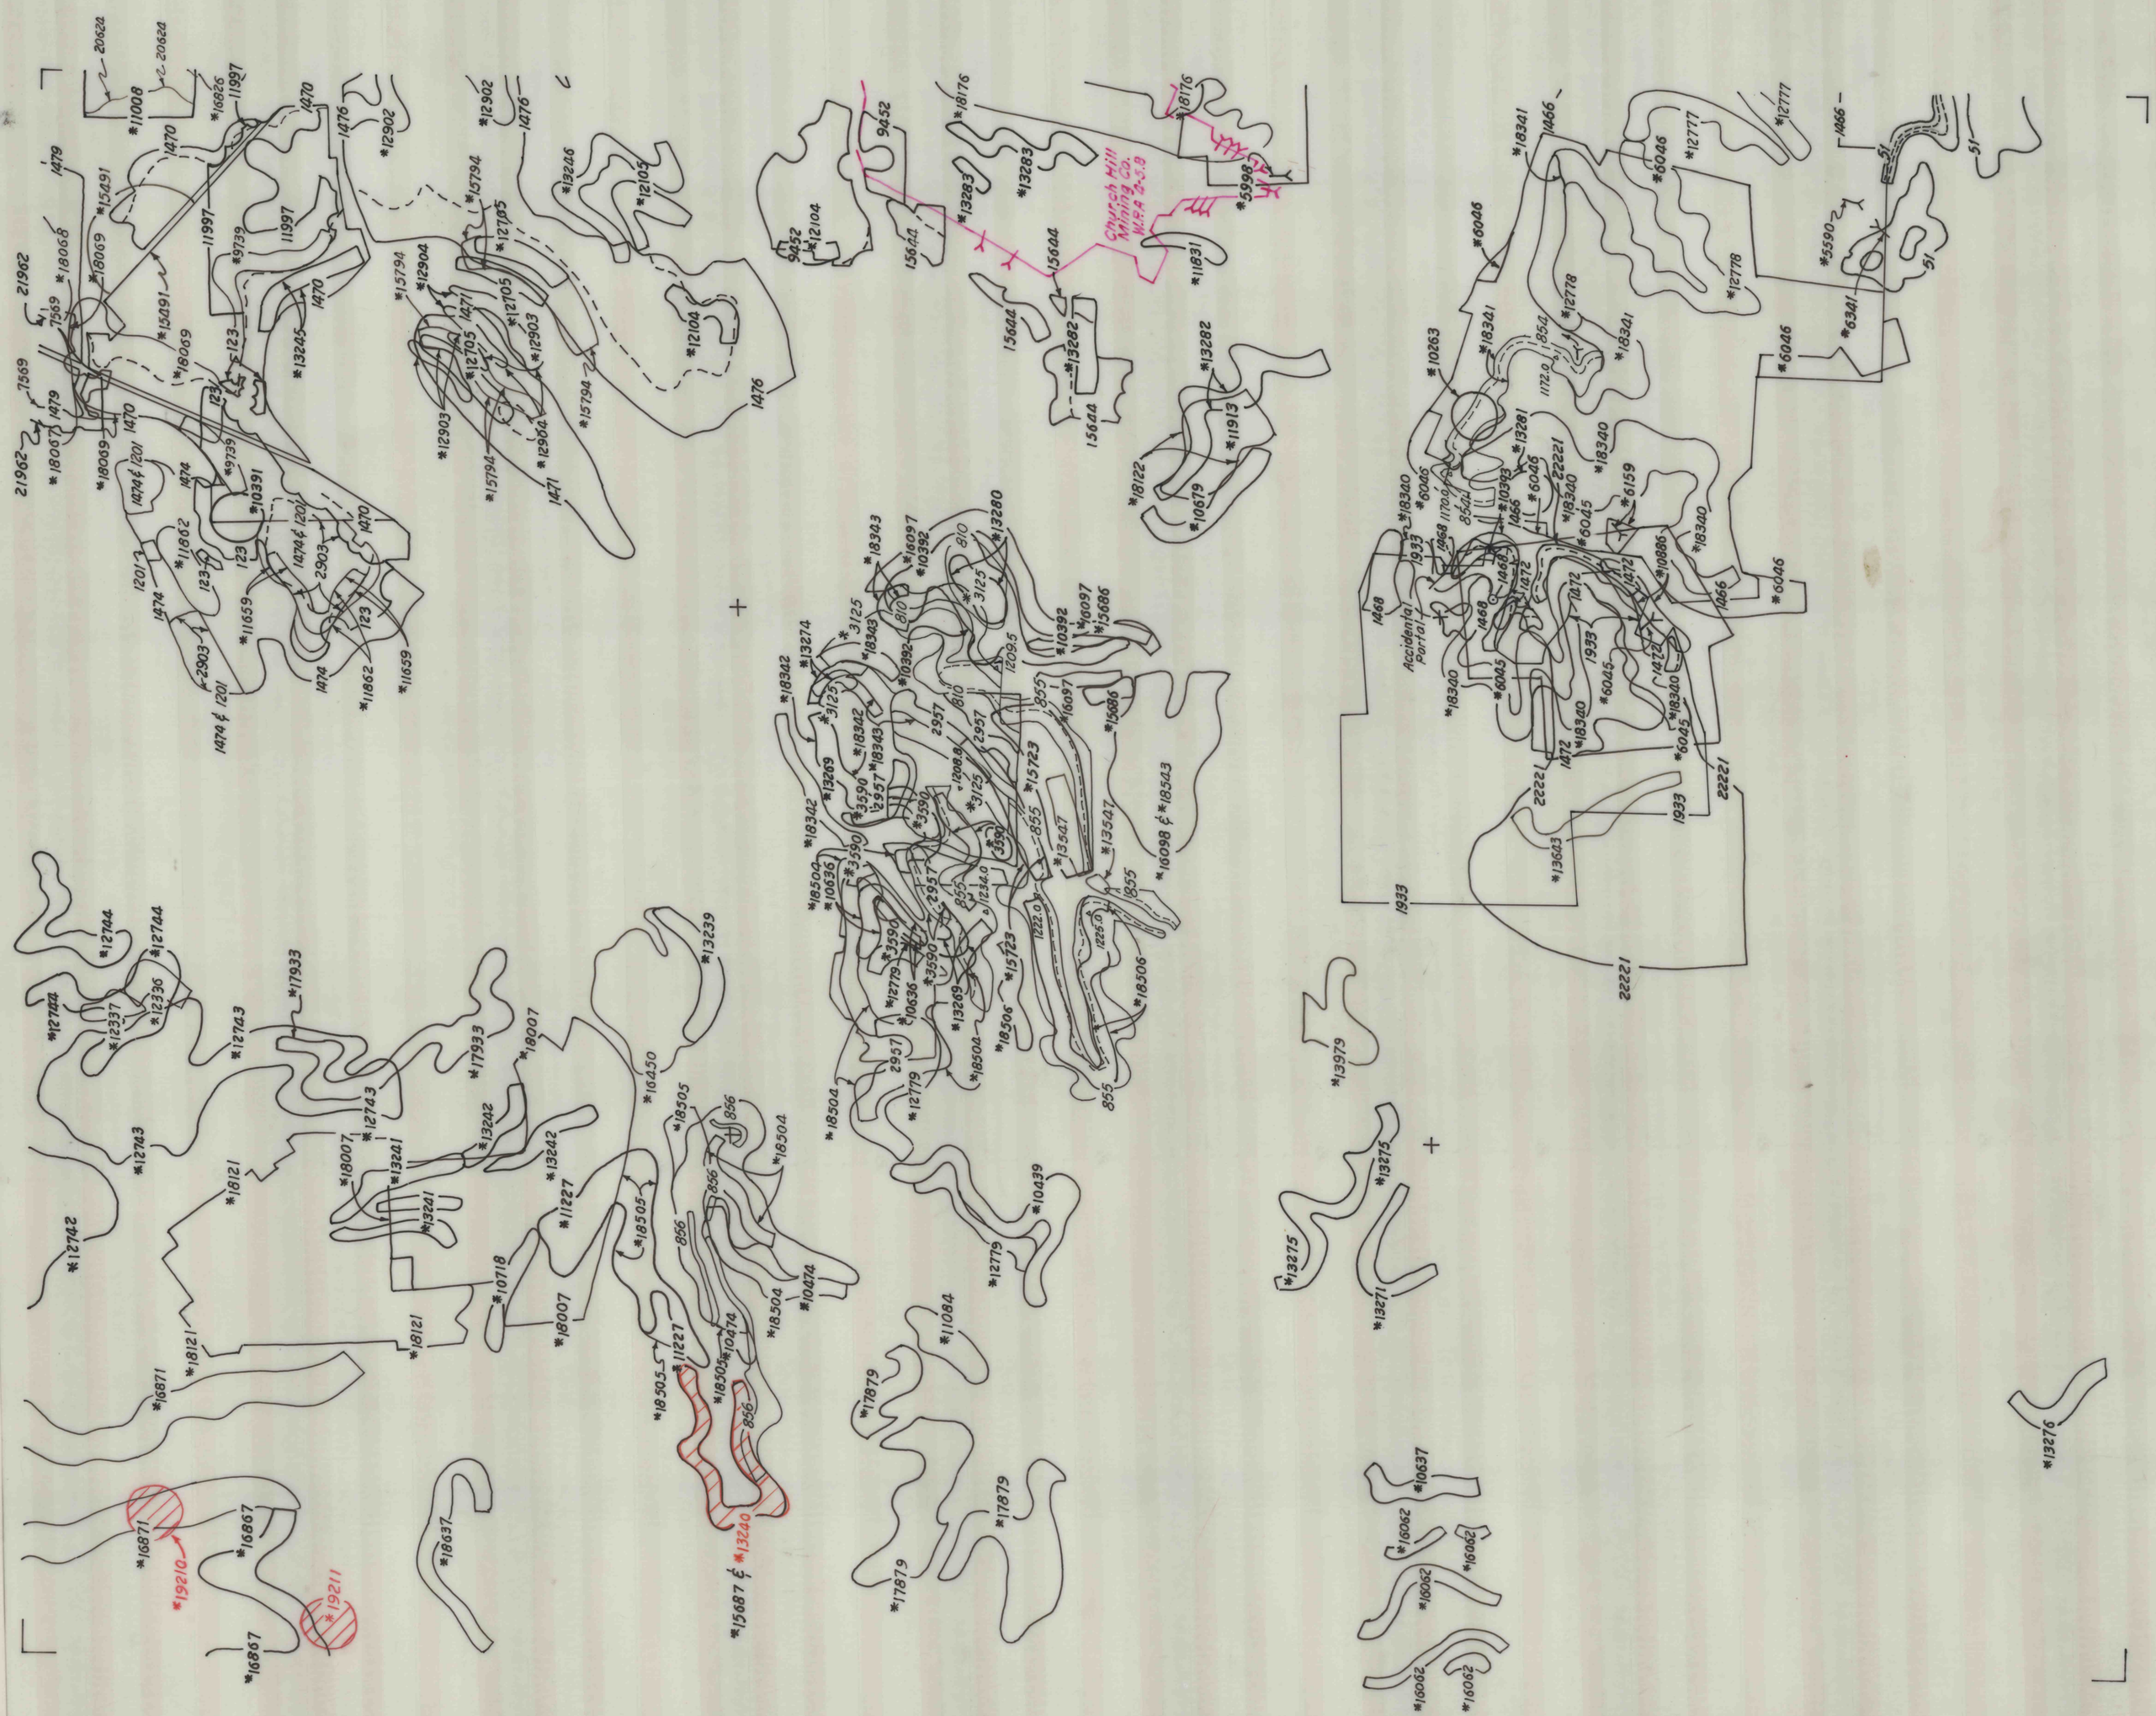
B/4-5.3 (1 of 3)
1008