PLAN HOLD
PEEL PROTECTIVE STRIP TO EXPOSE ADHESIVE. POSITION EDGE OF PRINT ON THIS LINE AND RUB TO ADHERE.
DRAWING NUMBER
D14-5.3
PLAN HOLD CORPORATION · TORRANCE · CALIFORNIA
REORDER BY NO. 070SA-24

1008

COAL 110
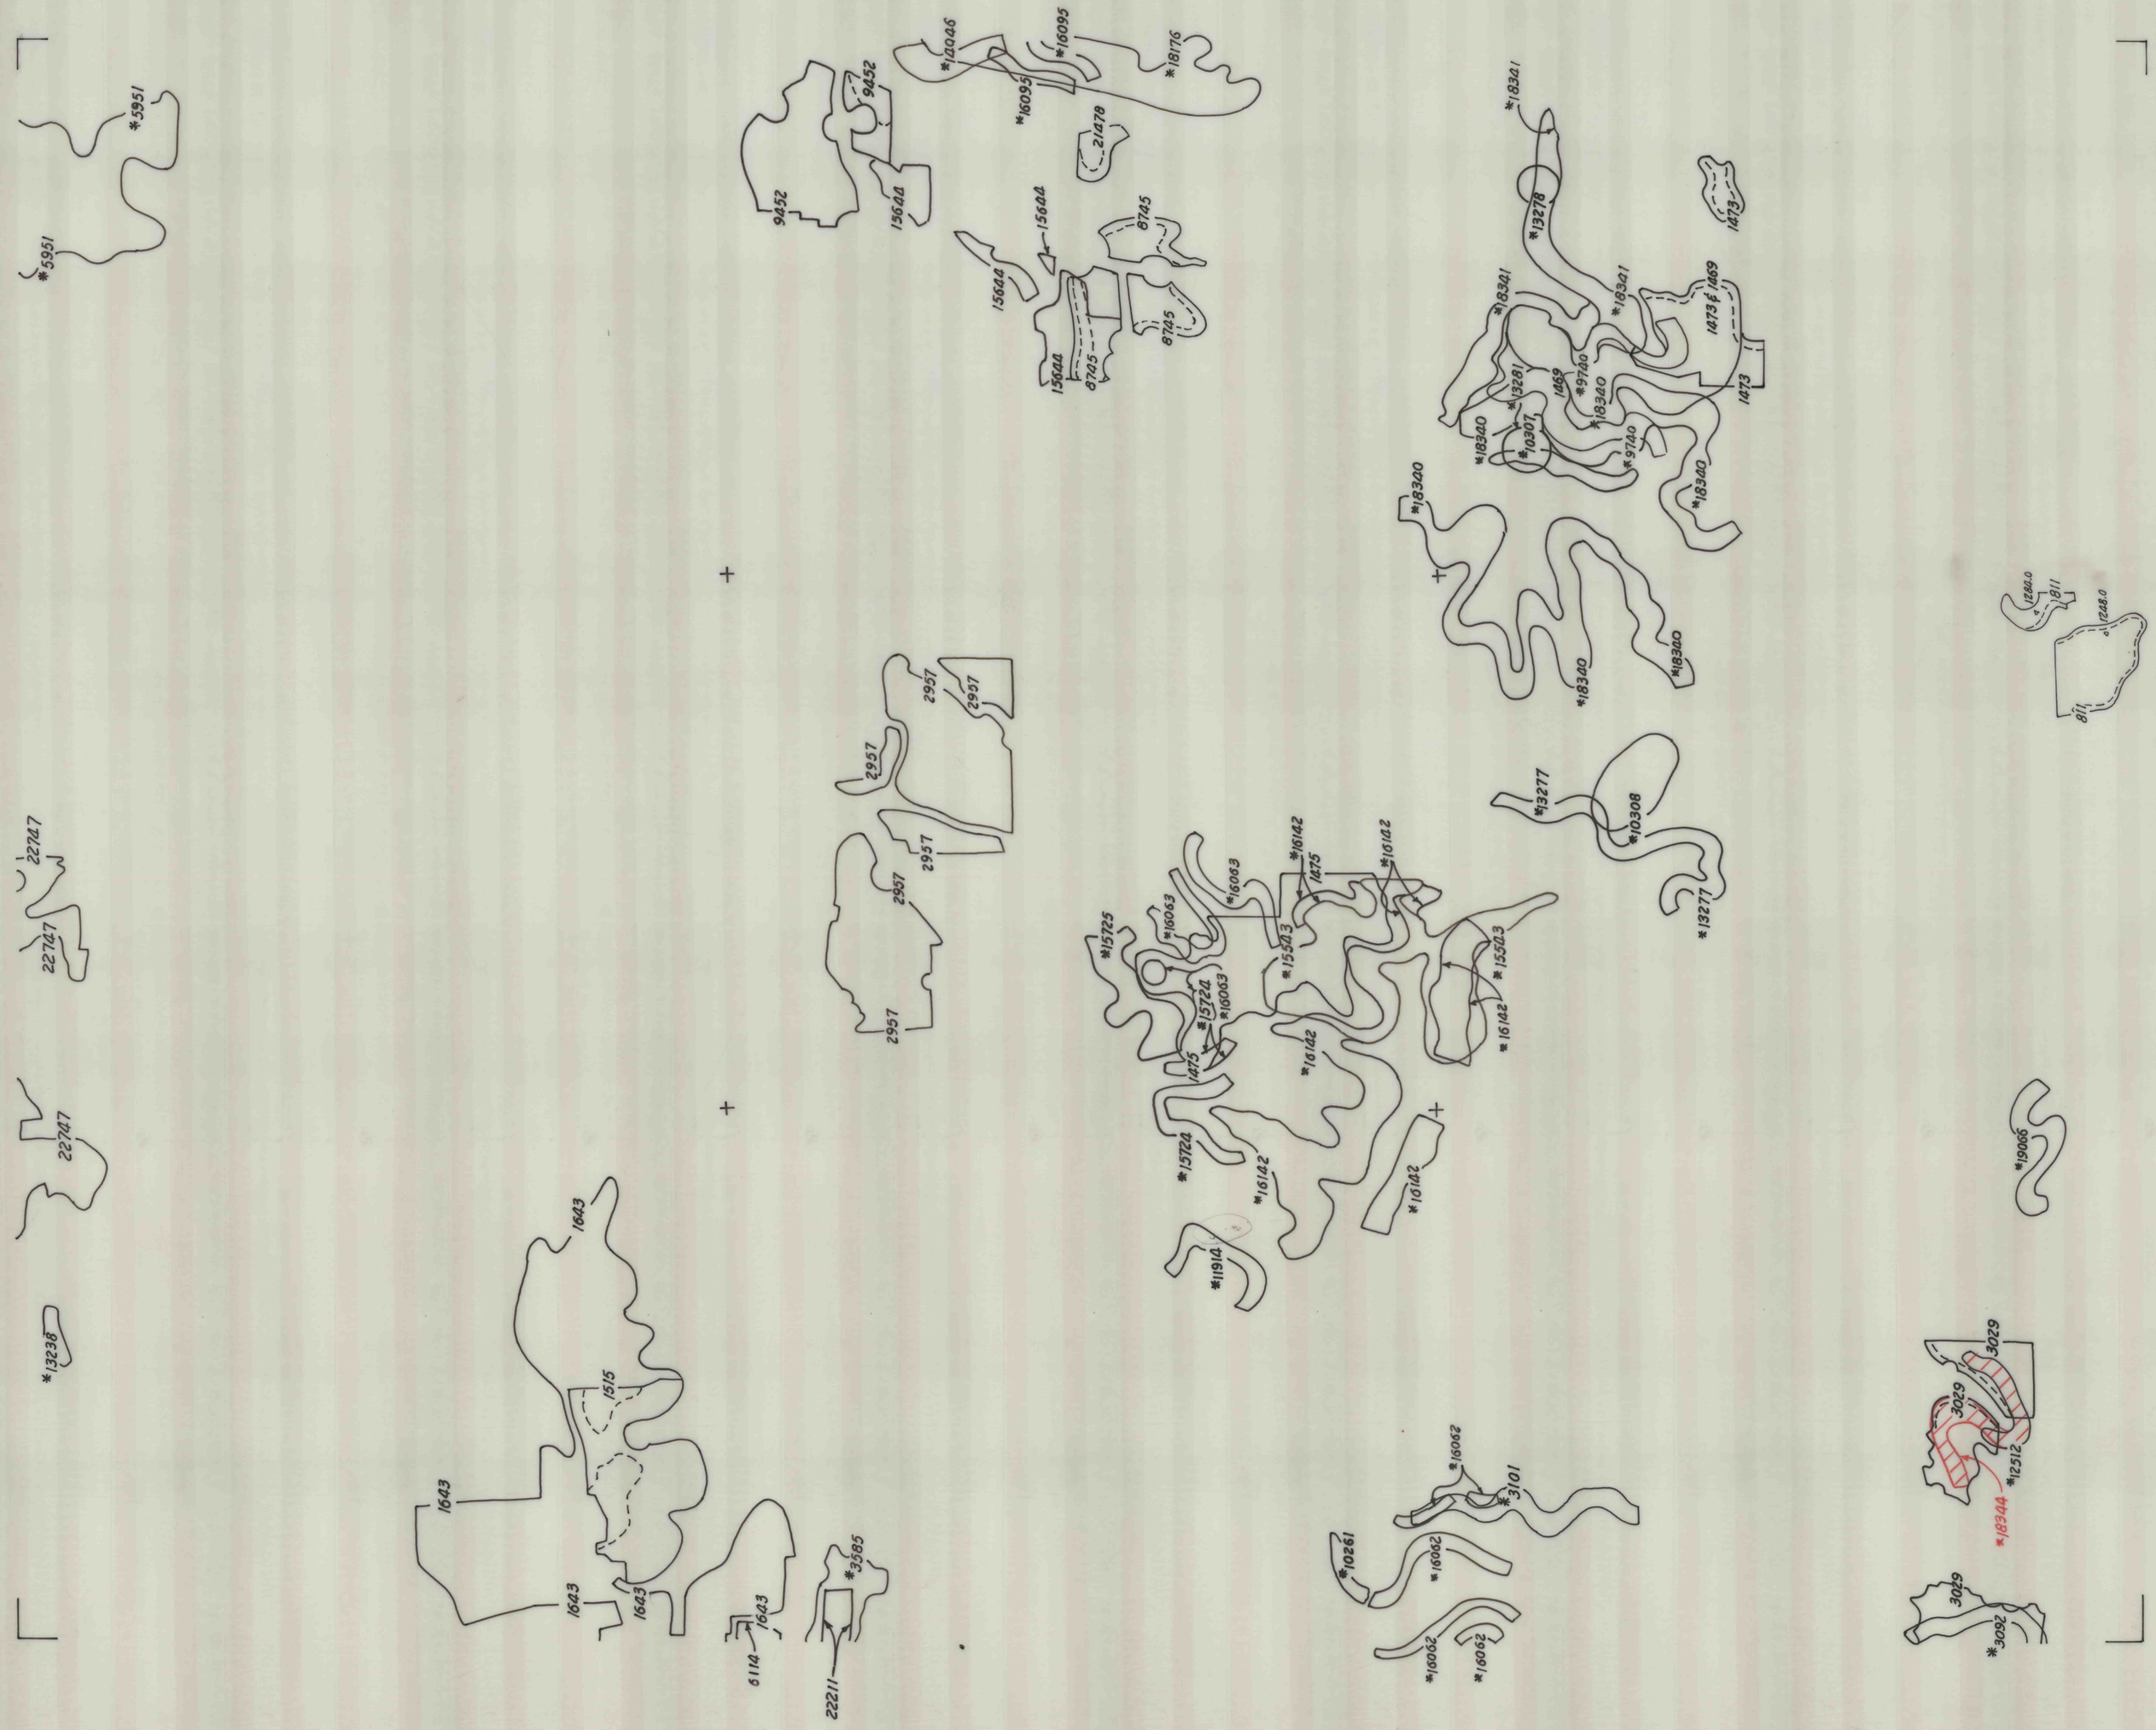
D14-5.3 (Sheet 1 of 2)
1008