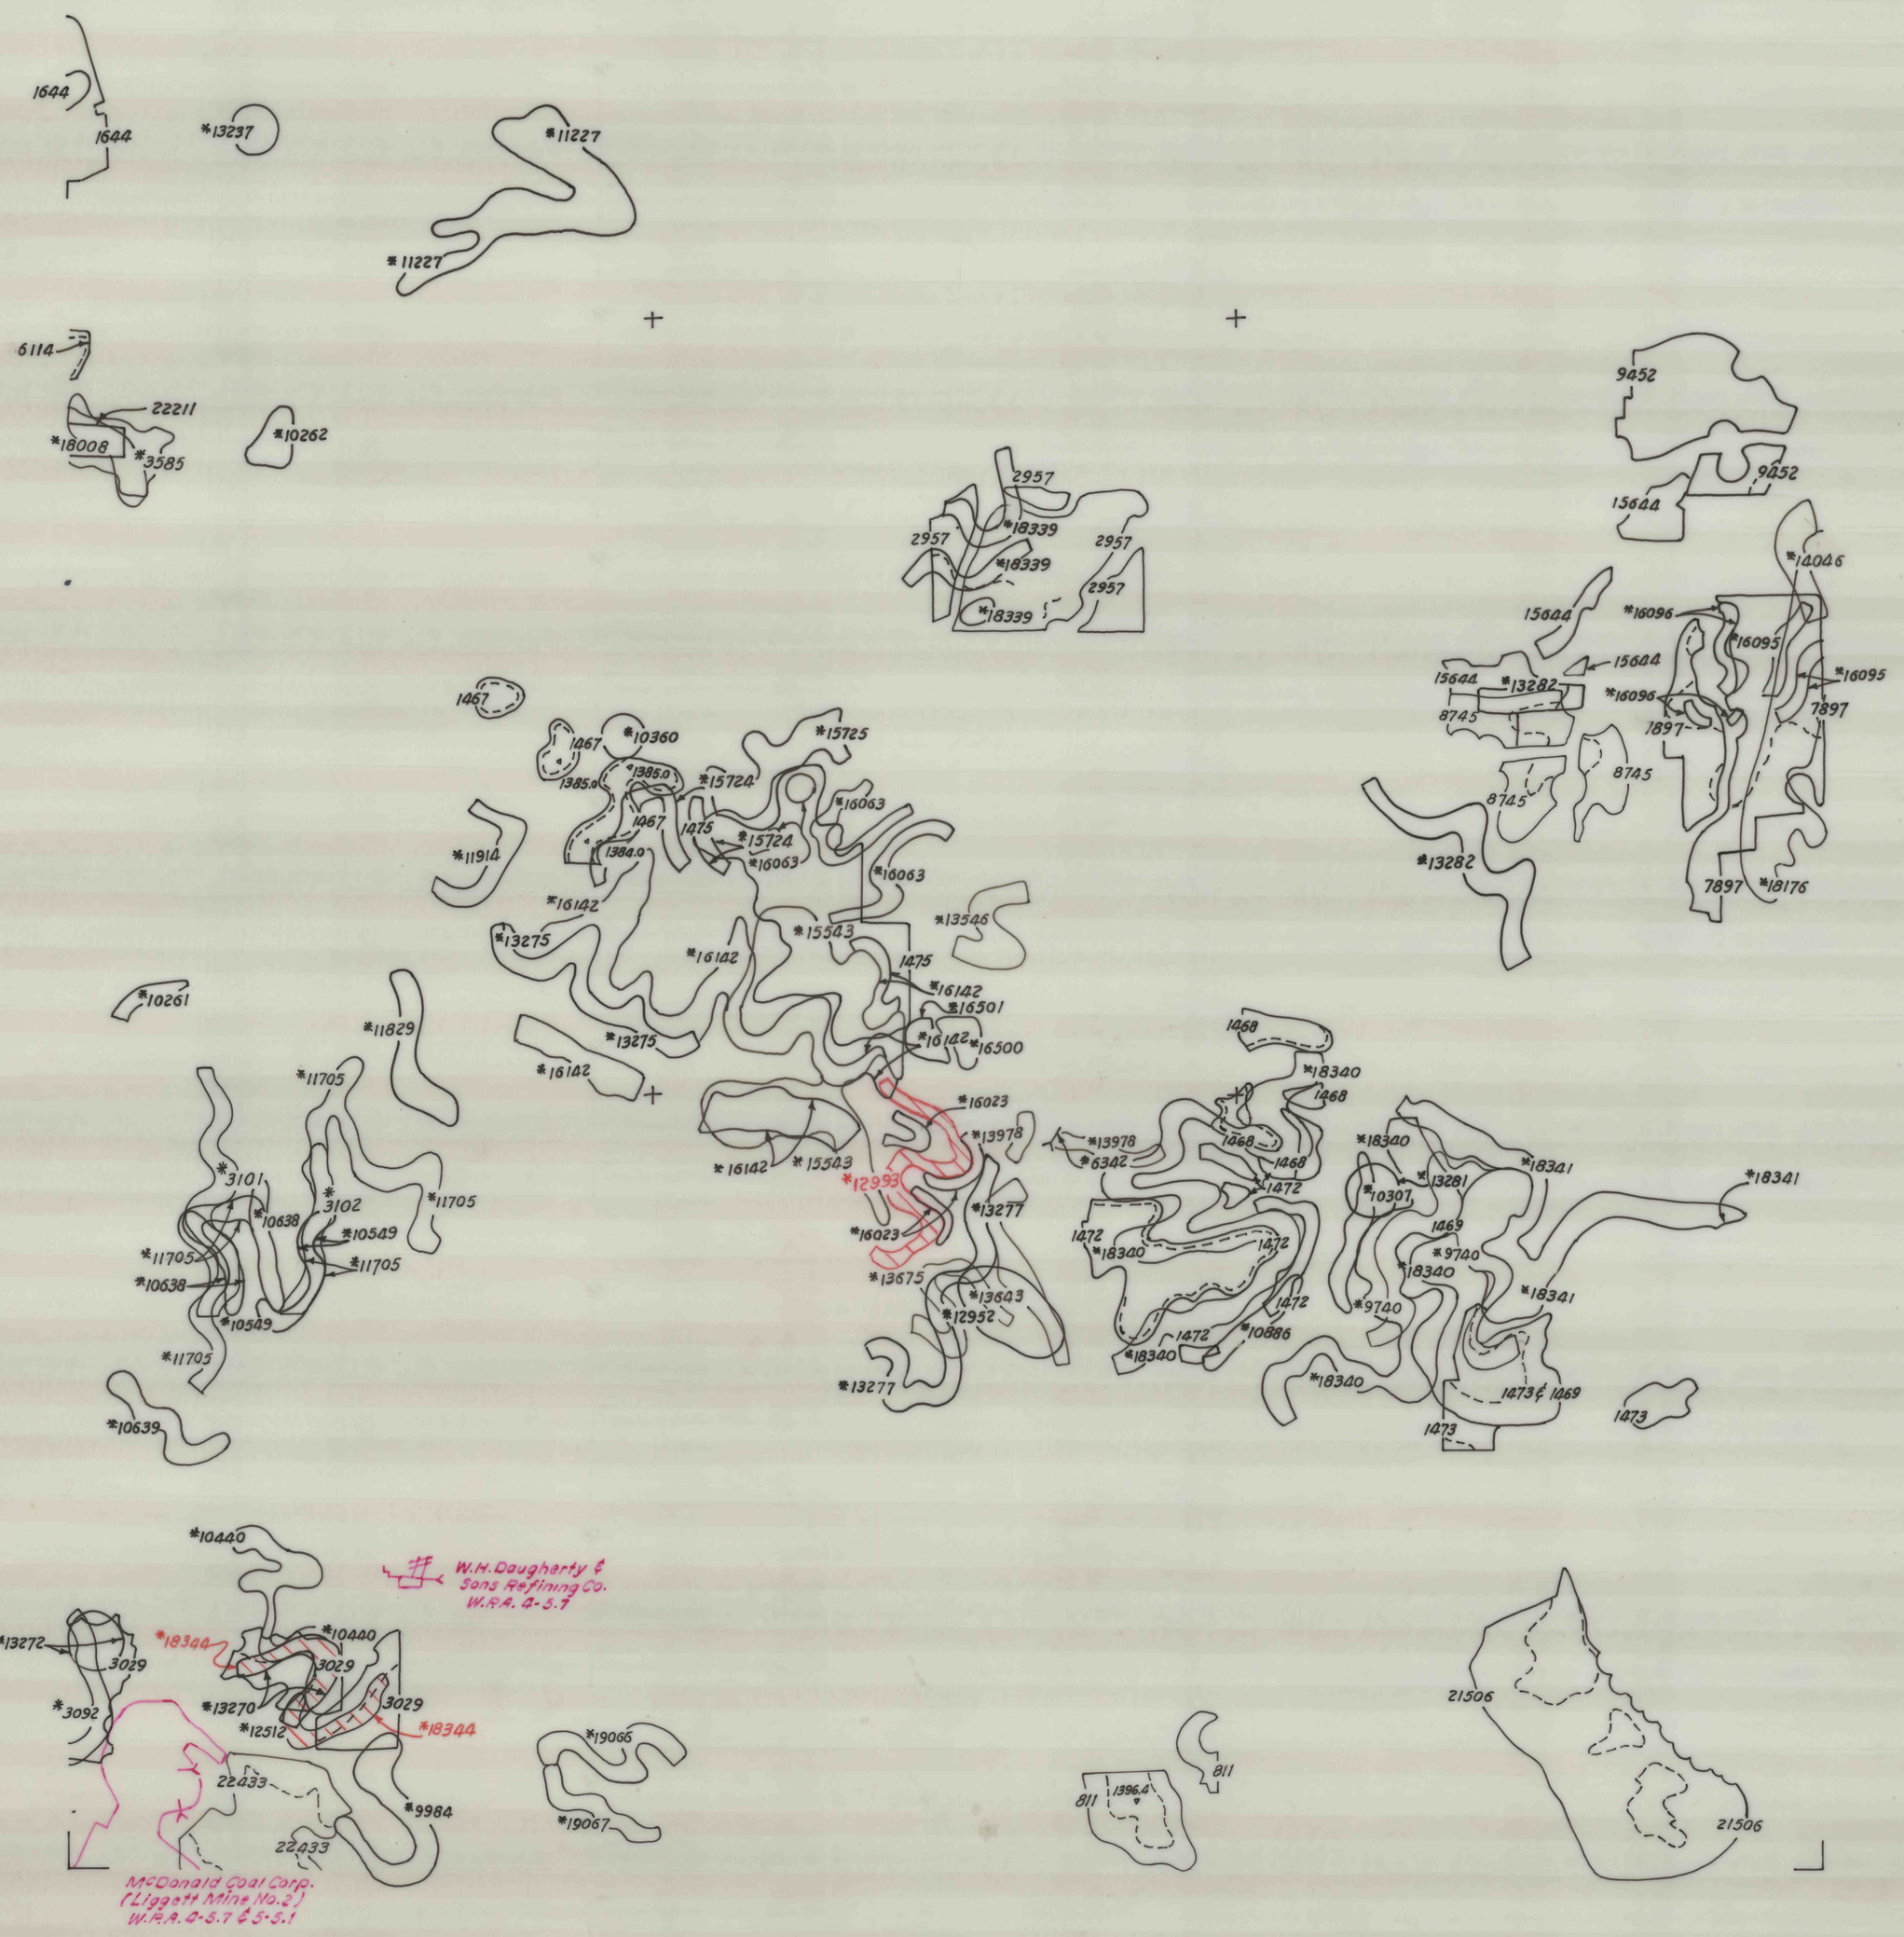

COAL III

E/4-5.3 (Sheet 1 of 2)
1008

DRAWING NUMBER
E/4-5.3

1008