



\*4635 (No Seam)

\*4695 (No Seam)

\*4773 (No Seam)

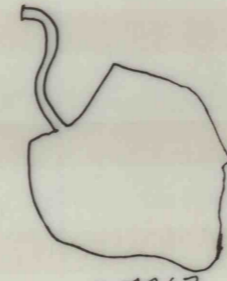


27363

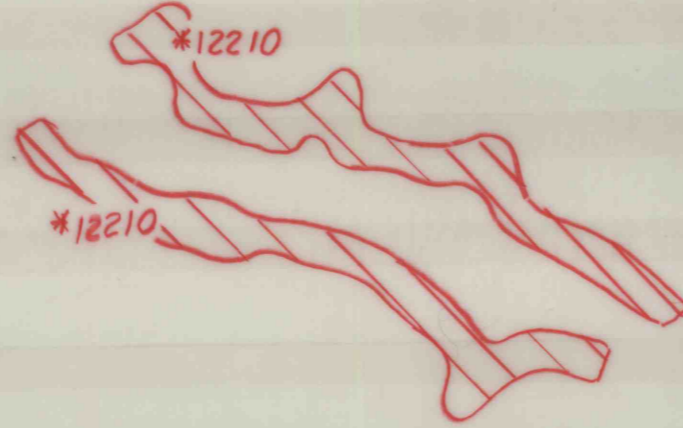


\*12210

\*12210

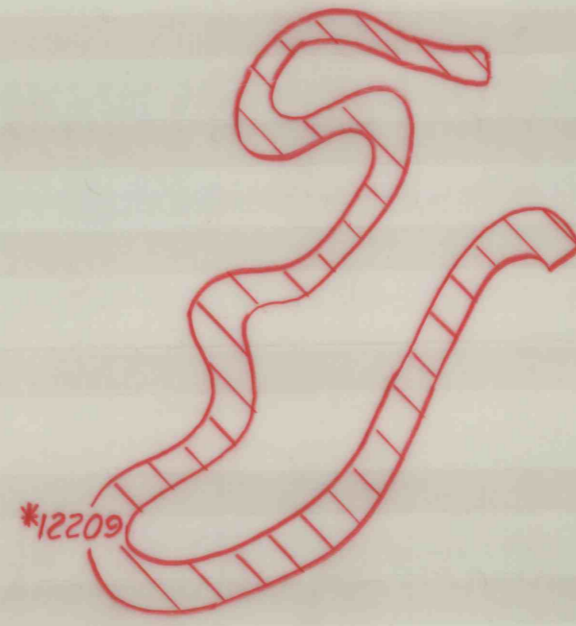

\*12209

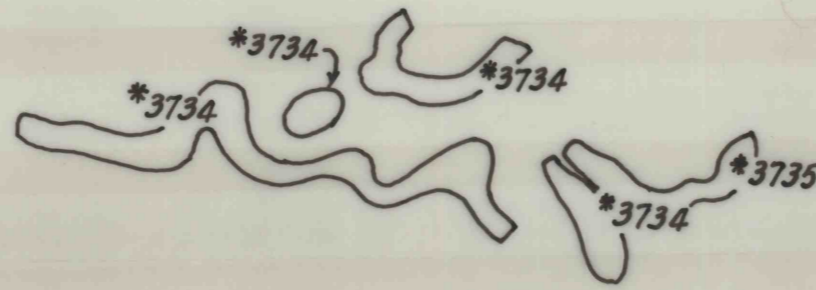

\*3734


\*3734

\*3734

\*3734

\*3735

\*3734

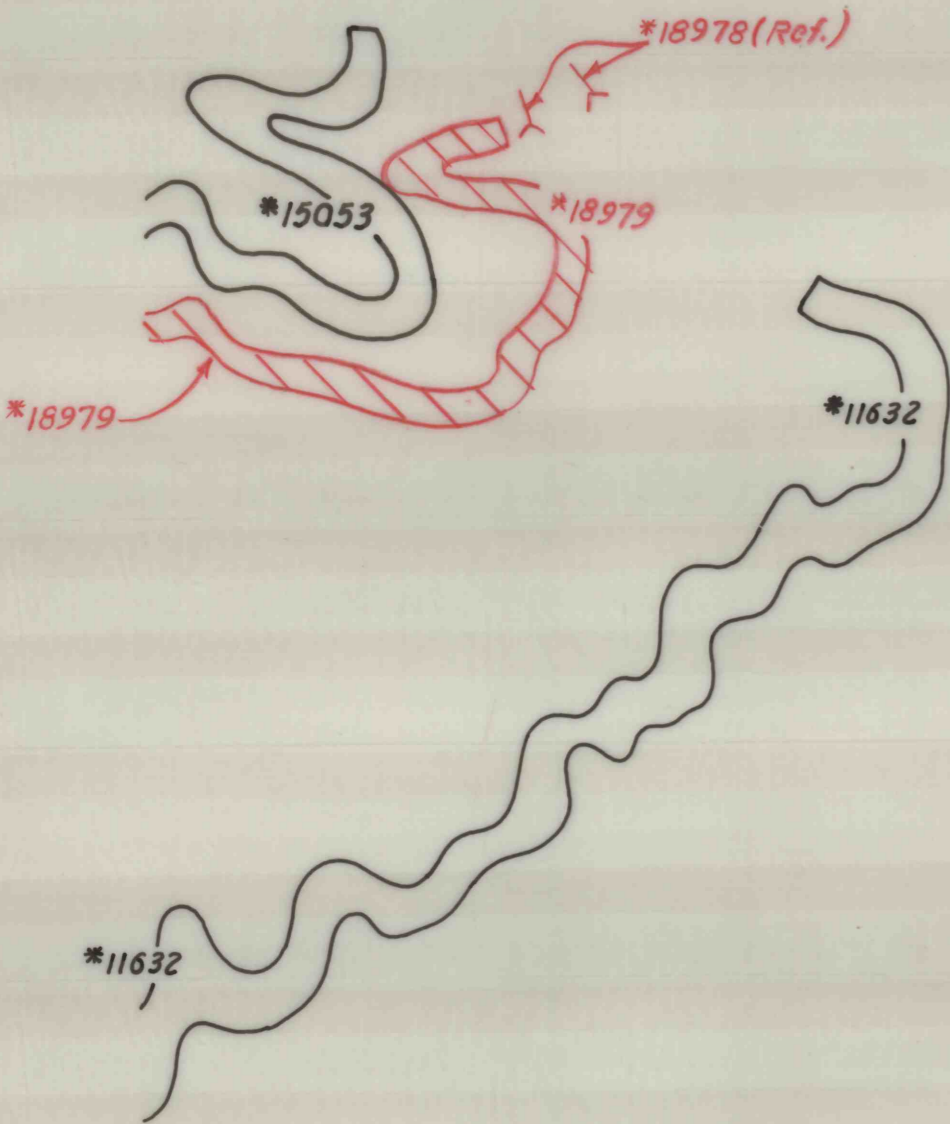

\*15053

\*18979

\*18978 (Ref.)

\*18979

\*11632

\*11632

\*18980 (N/S)

D/4-9.1  
0917